
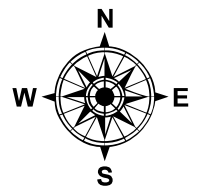



PARENT PARCEL: 06-26-044-000-012

CHILD PARCEL: **MAP CORRECTION ONLY**

23-05059-C

STARTING POINT: SW CORNER OF S/L 379

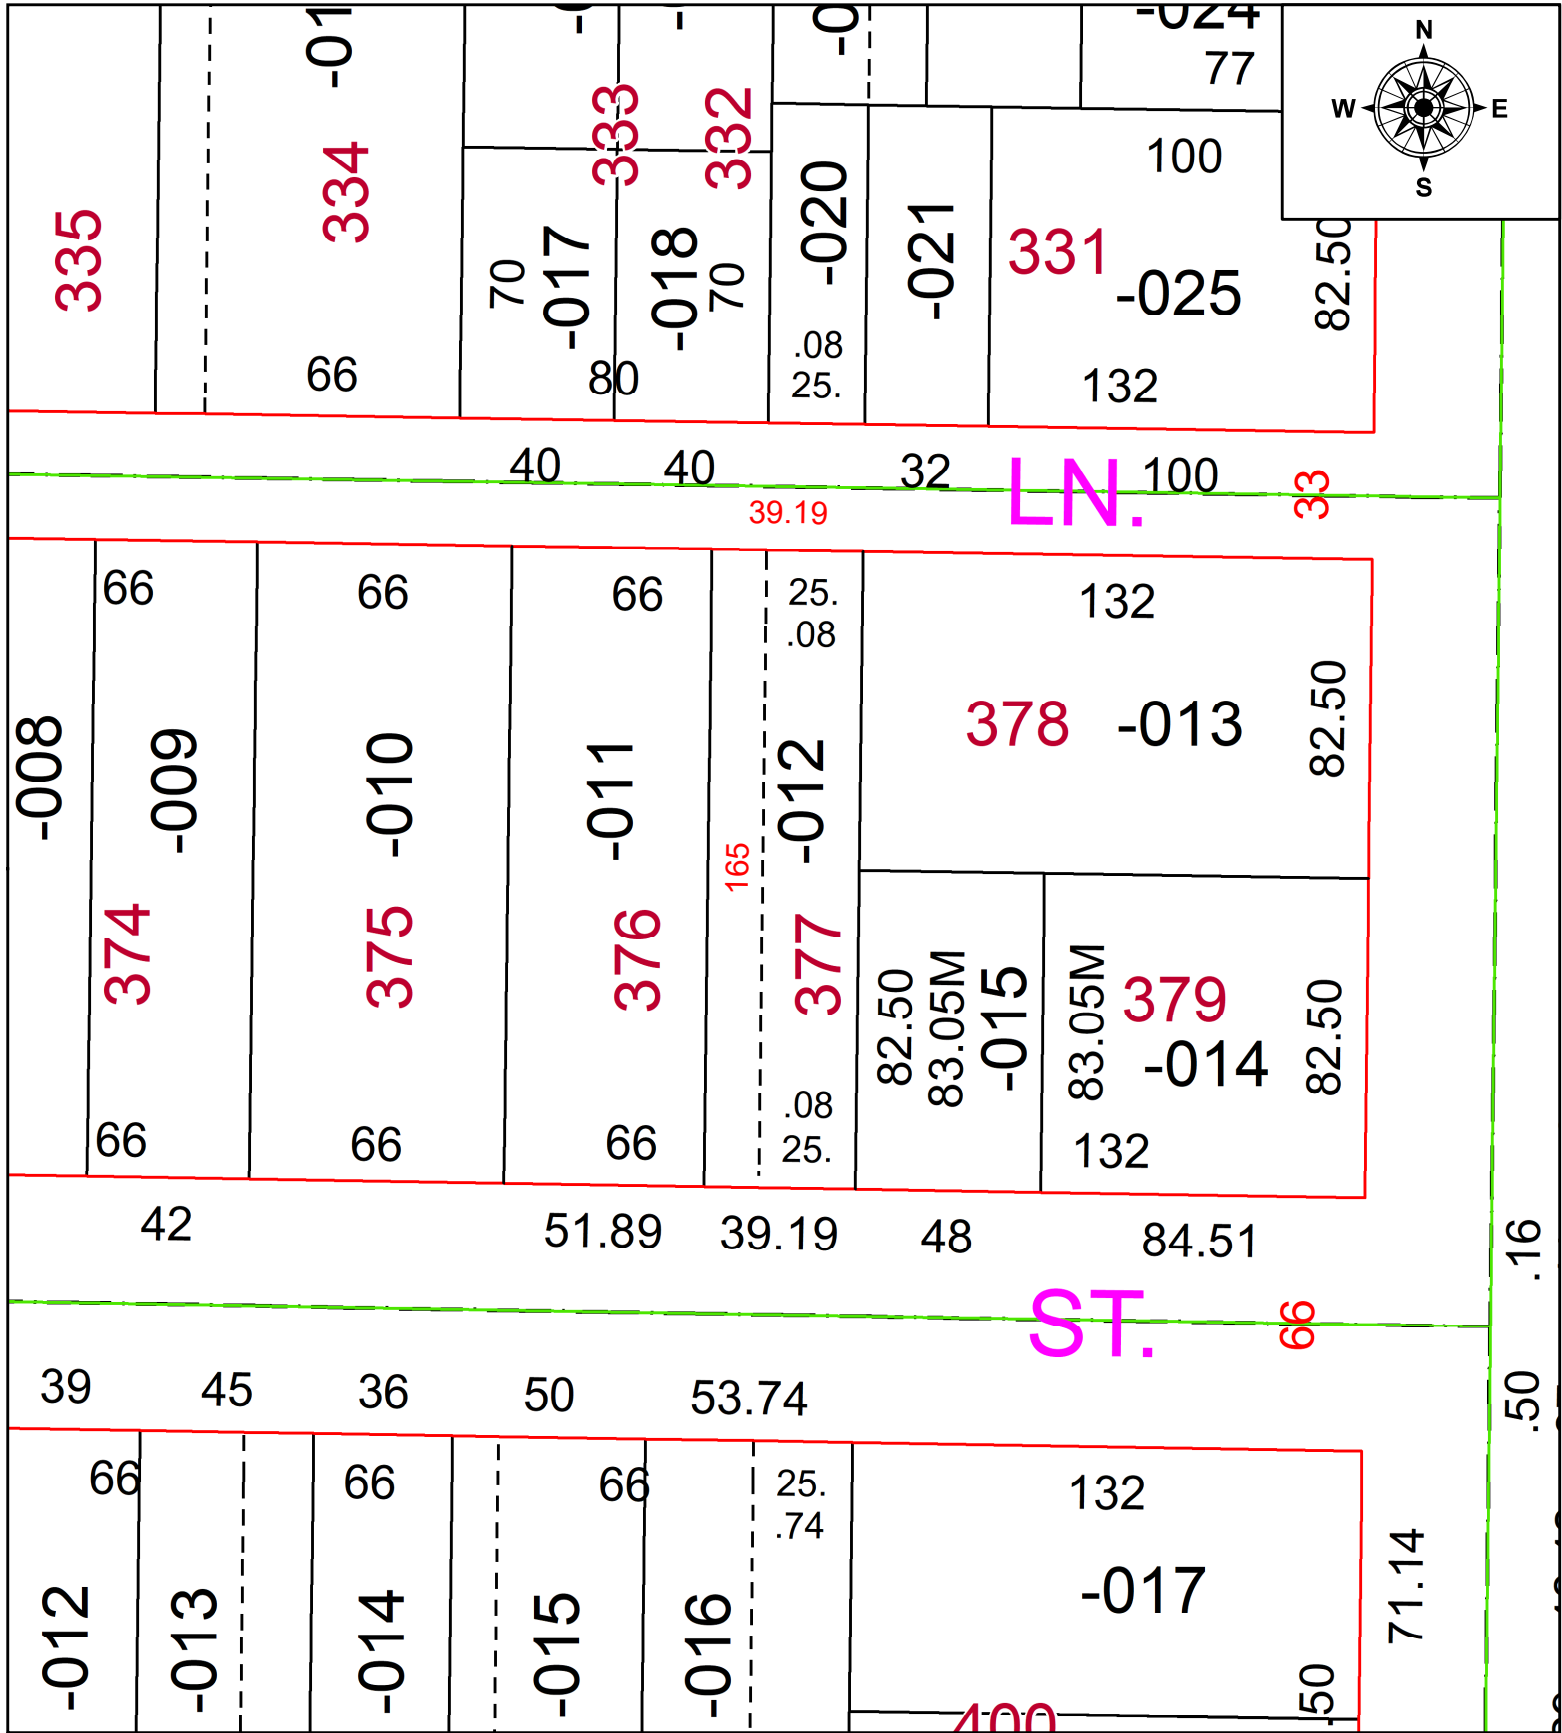

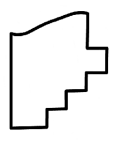 **SPLITS/DEEDS PROCESSED**  
 LORAIN COUNTY TAX MAP DEPARTMENT  
 226 MIDDLE AVE. ELYRIA, OH

**SURVEYED BY:** WILFREDO BARBOSA **SURV #** 50851  
**CLOSURE:** 1: 2147483648  
**MAP PAGE(S):** 06-120  
**APPROVED BY:** AC **DATE:** March 30, 2023  
**SCALE:** 1 in = 50 ft **PRIOR INSTRUMENT:** 2022- 0900746