

PARENT PARCEL:

02-02-003-102-089 & -092

CHILD PARCEL:



02-02-003-102-094 THRU -097

AC CORR PER SURVEYOR MICHAEL SPELLACY

STARTING POINT:

C/LS OF NANTUCKET DR & N. LEAVITT RD

25-05062

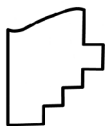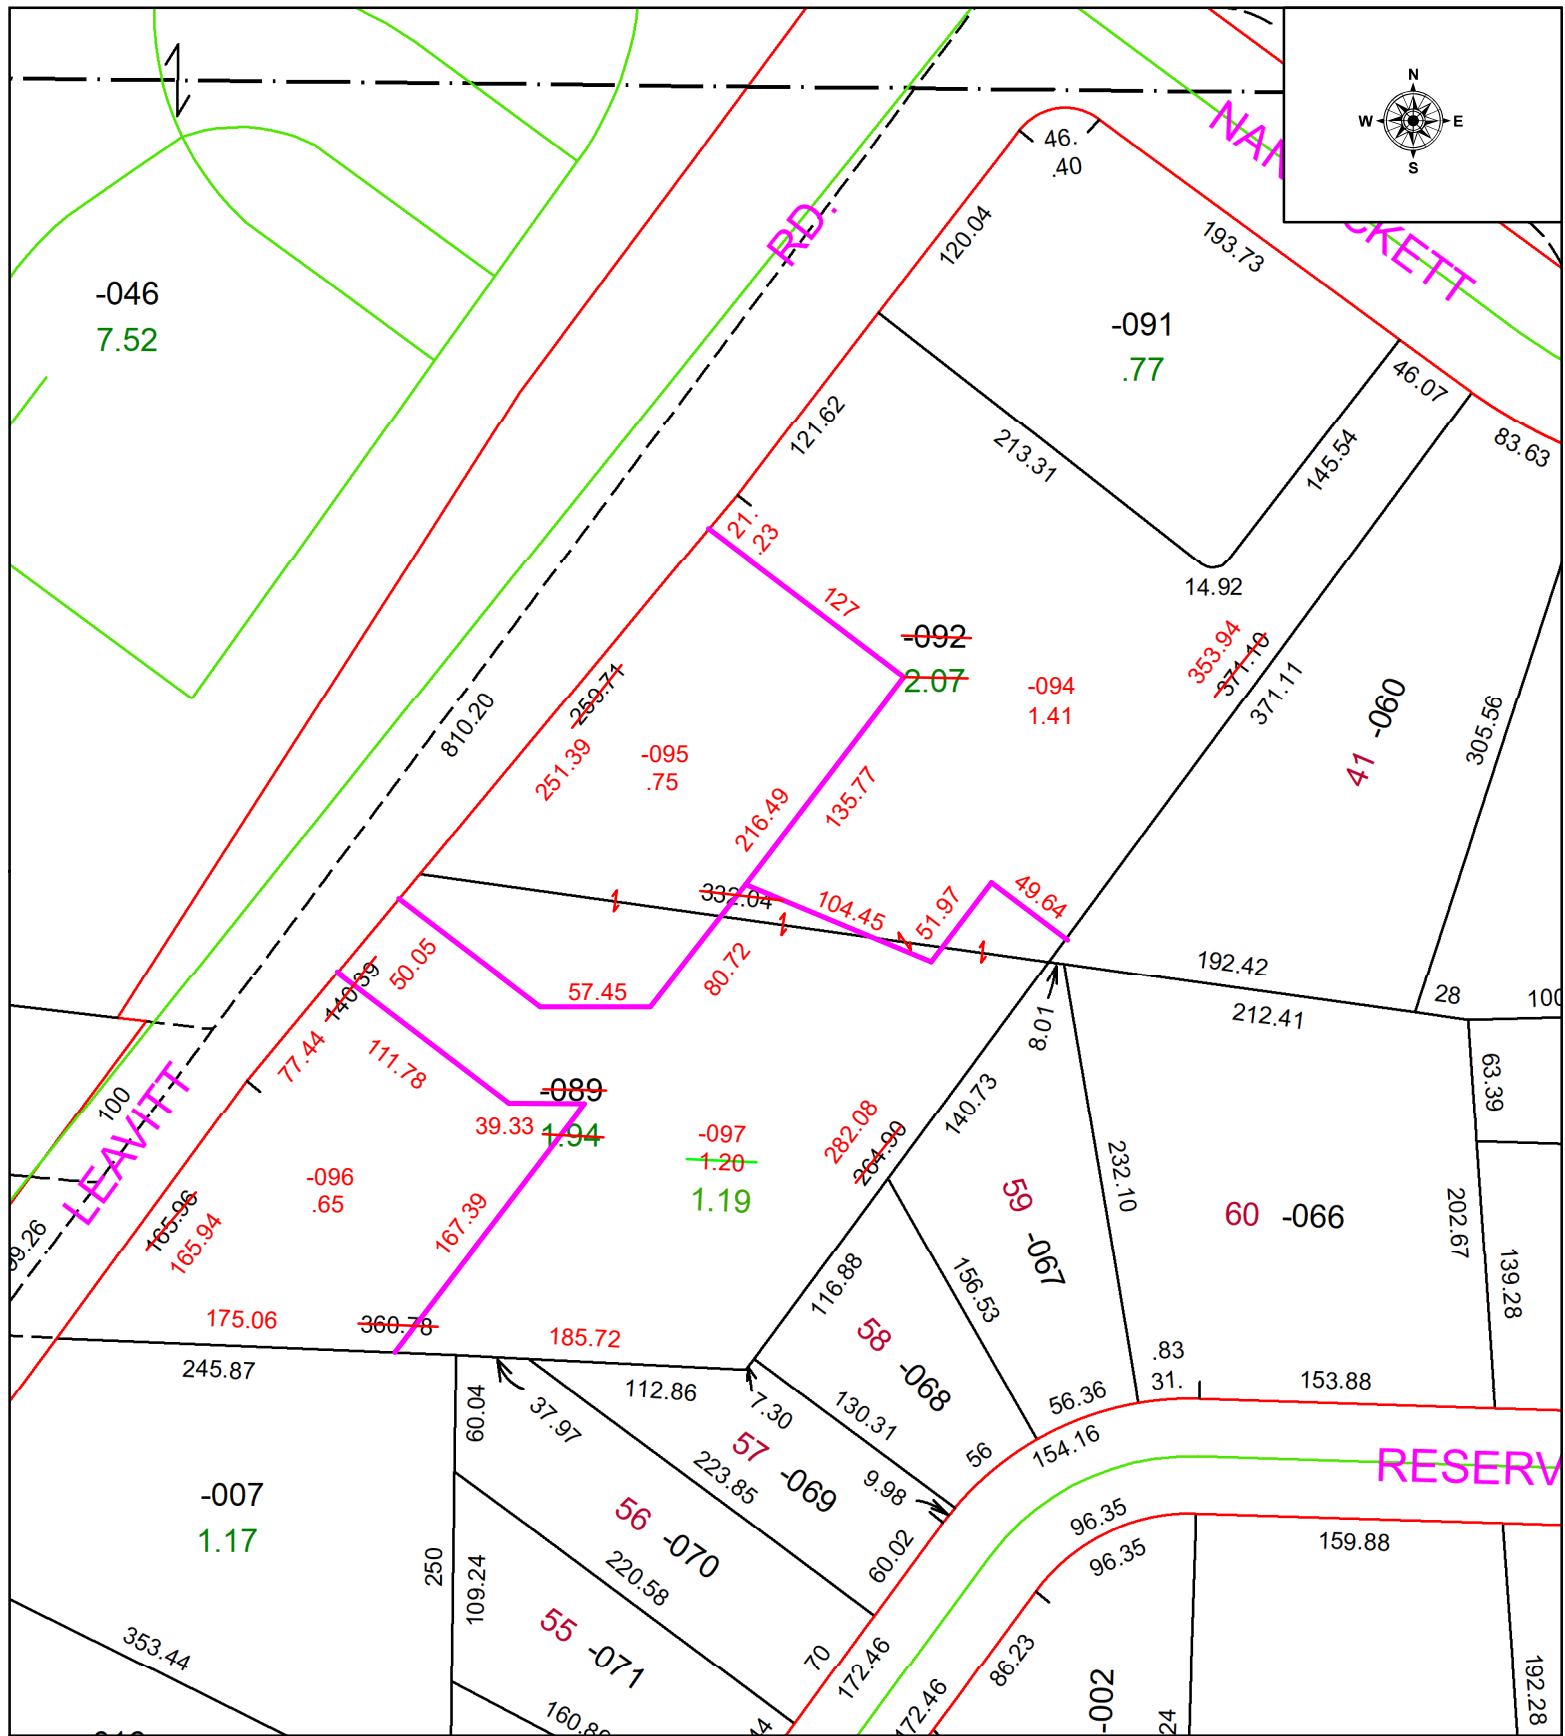

SPLITS/DEEDS PROCESSED

LORAIN COUNTY TAX MAP DEPARTMENT
226 MIDDLE AVE. ELYRIA, OH

SURVEYED BY: MICHAEL SPELLACY

SURVEY # 51544

CLOSURE: 1: 149407

MAP PAGE(S): 02-02-003

APPROVED BY: WRZ DATE: 9/19/2025

SCALE: 1" = 100 PRIOR INSTRUMENT: #2019-0722570