


PARENT PARCEL: 10-00-015-108-025 & -046

CHILD PARCEL: N/A FRONTAGE & DEPTH TO ACREAGE & ACREAGE CORRECTION

23-05066-A

STARTING POINT: INTERSECTION OF EASTERLY LINE OF EDGEWOOD DR & NORTHERLY LINE OF LAKEVIEW DR

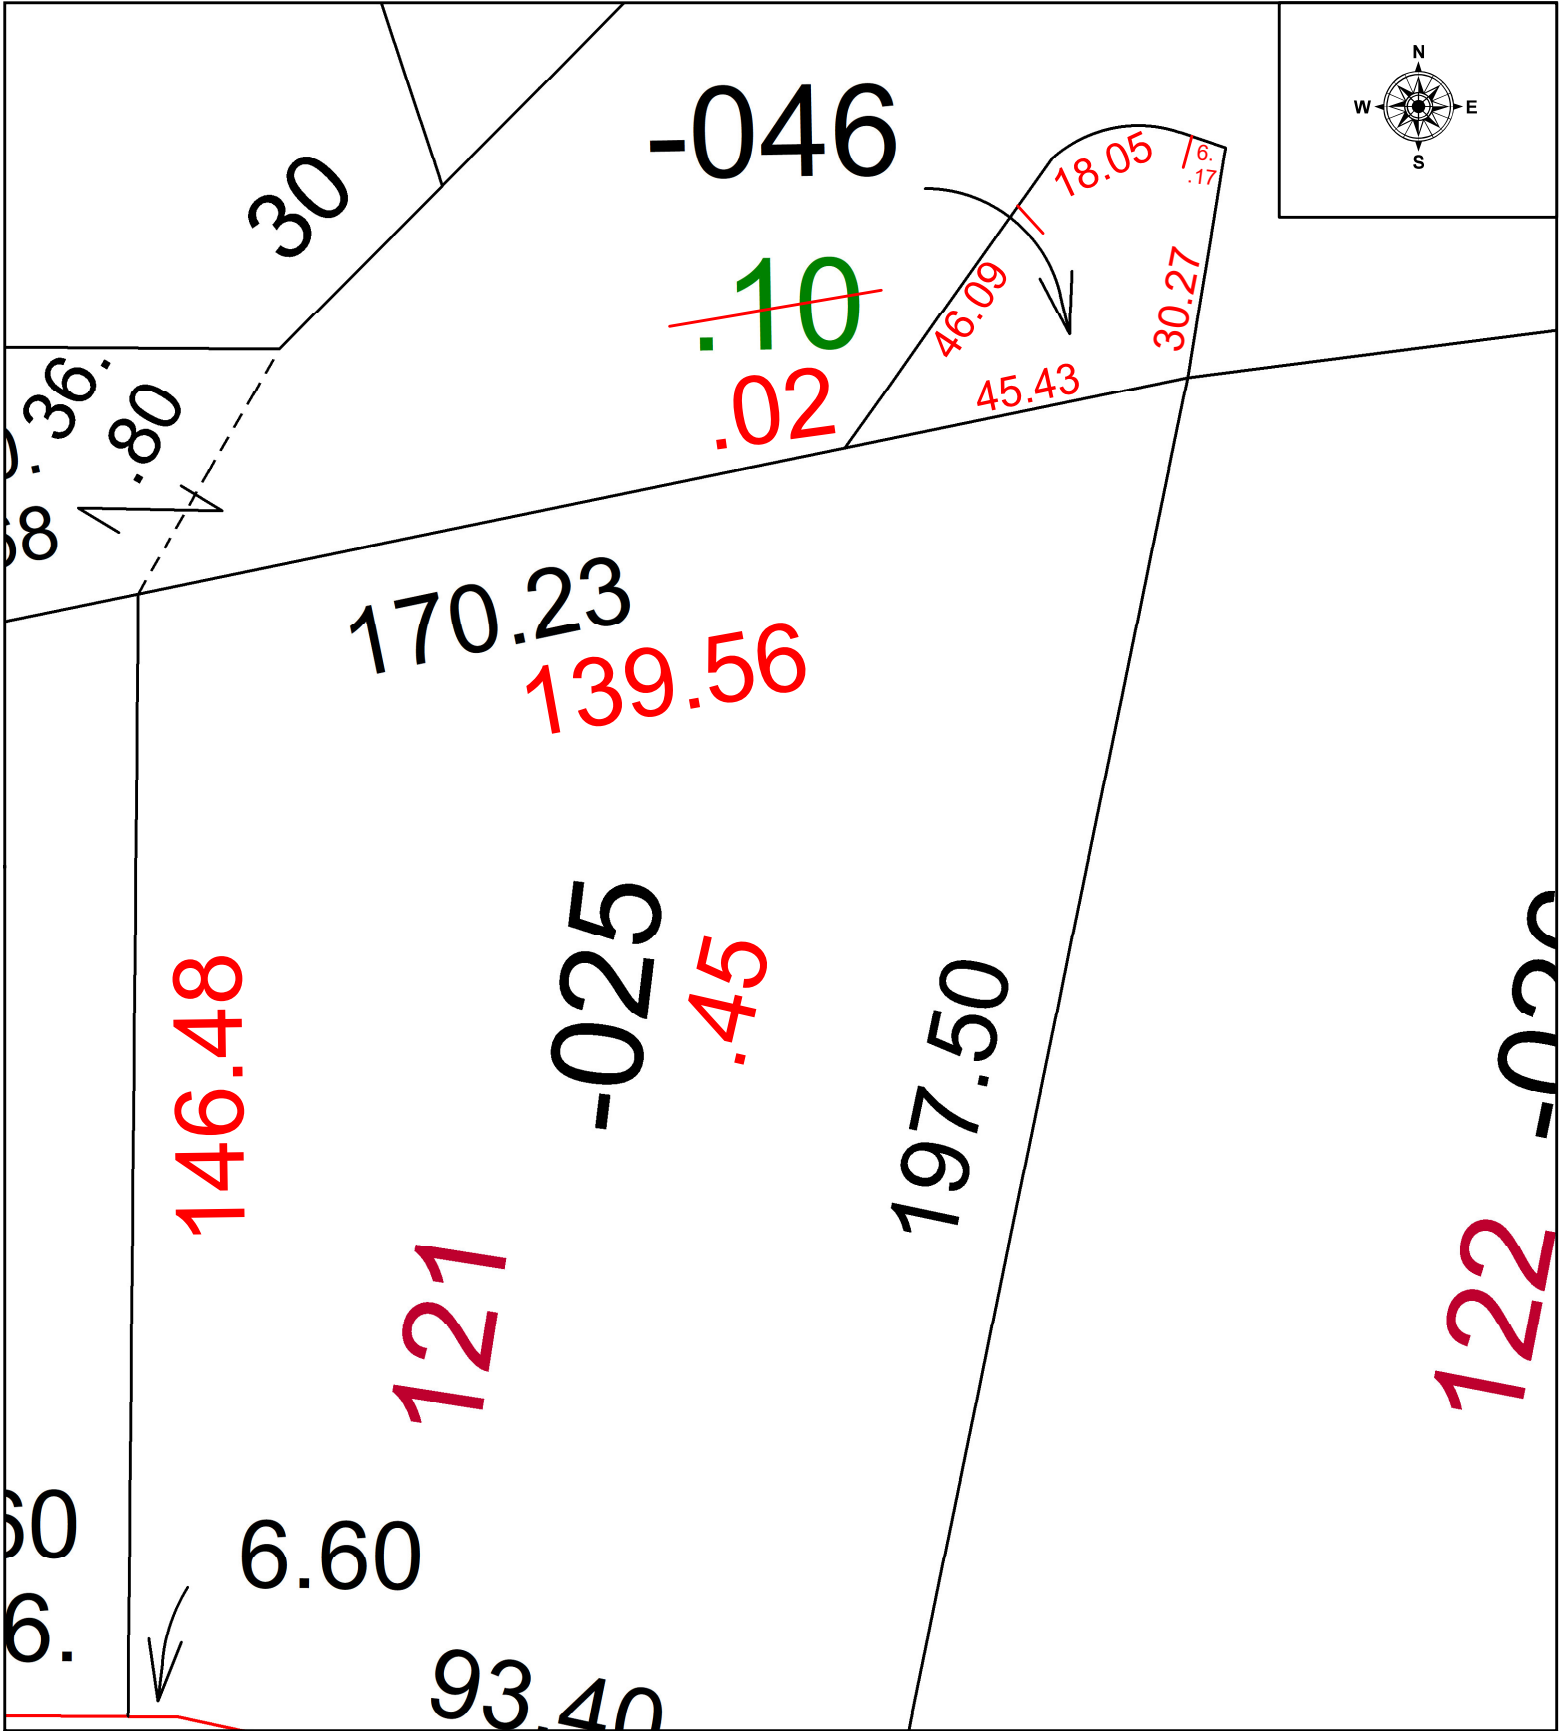

SPLITS/DEEDS PROCESSED
 LORAIN COUNTY TAX MAP DEPARTMENT
 226 MIDDLE AVE. ELYRIA, OH

SURVEYED BY: SEAN BOLAND SURVEY # 50855
 CLOSURE: 1: 127868
 MAP PAGE(S): 10-00-015
 APPROVED BY: WRZ DATE: 4/10/2023
 SCALE: 1" = 25' PRIOR INSTRUMENT: #2022-0896151