

PARENT PARCEL:

05-00-097-103-006 & -100

CHILD PARCEL:



05-00-097-103-153, -154, & -155

AC CORR PER SURVEYOR JOSHUA RIEDY

STARTING POINT:

C/LS OF TINA LN & NORTH RIDGE RD

25-05066

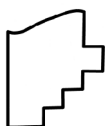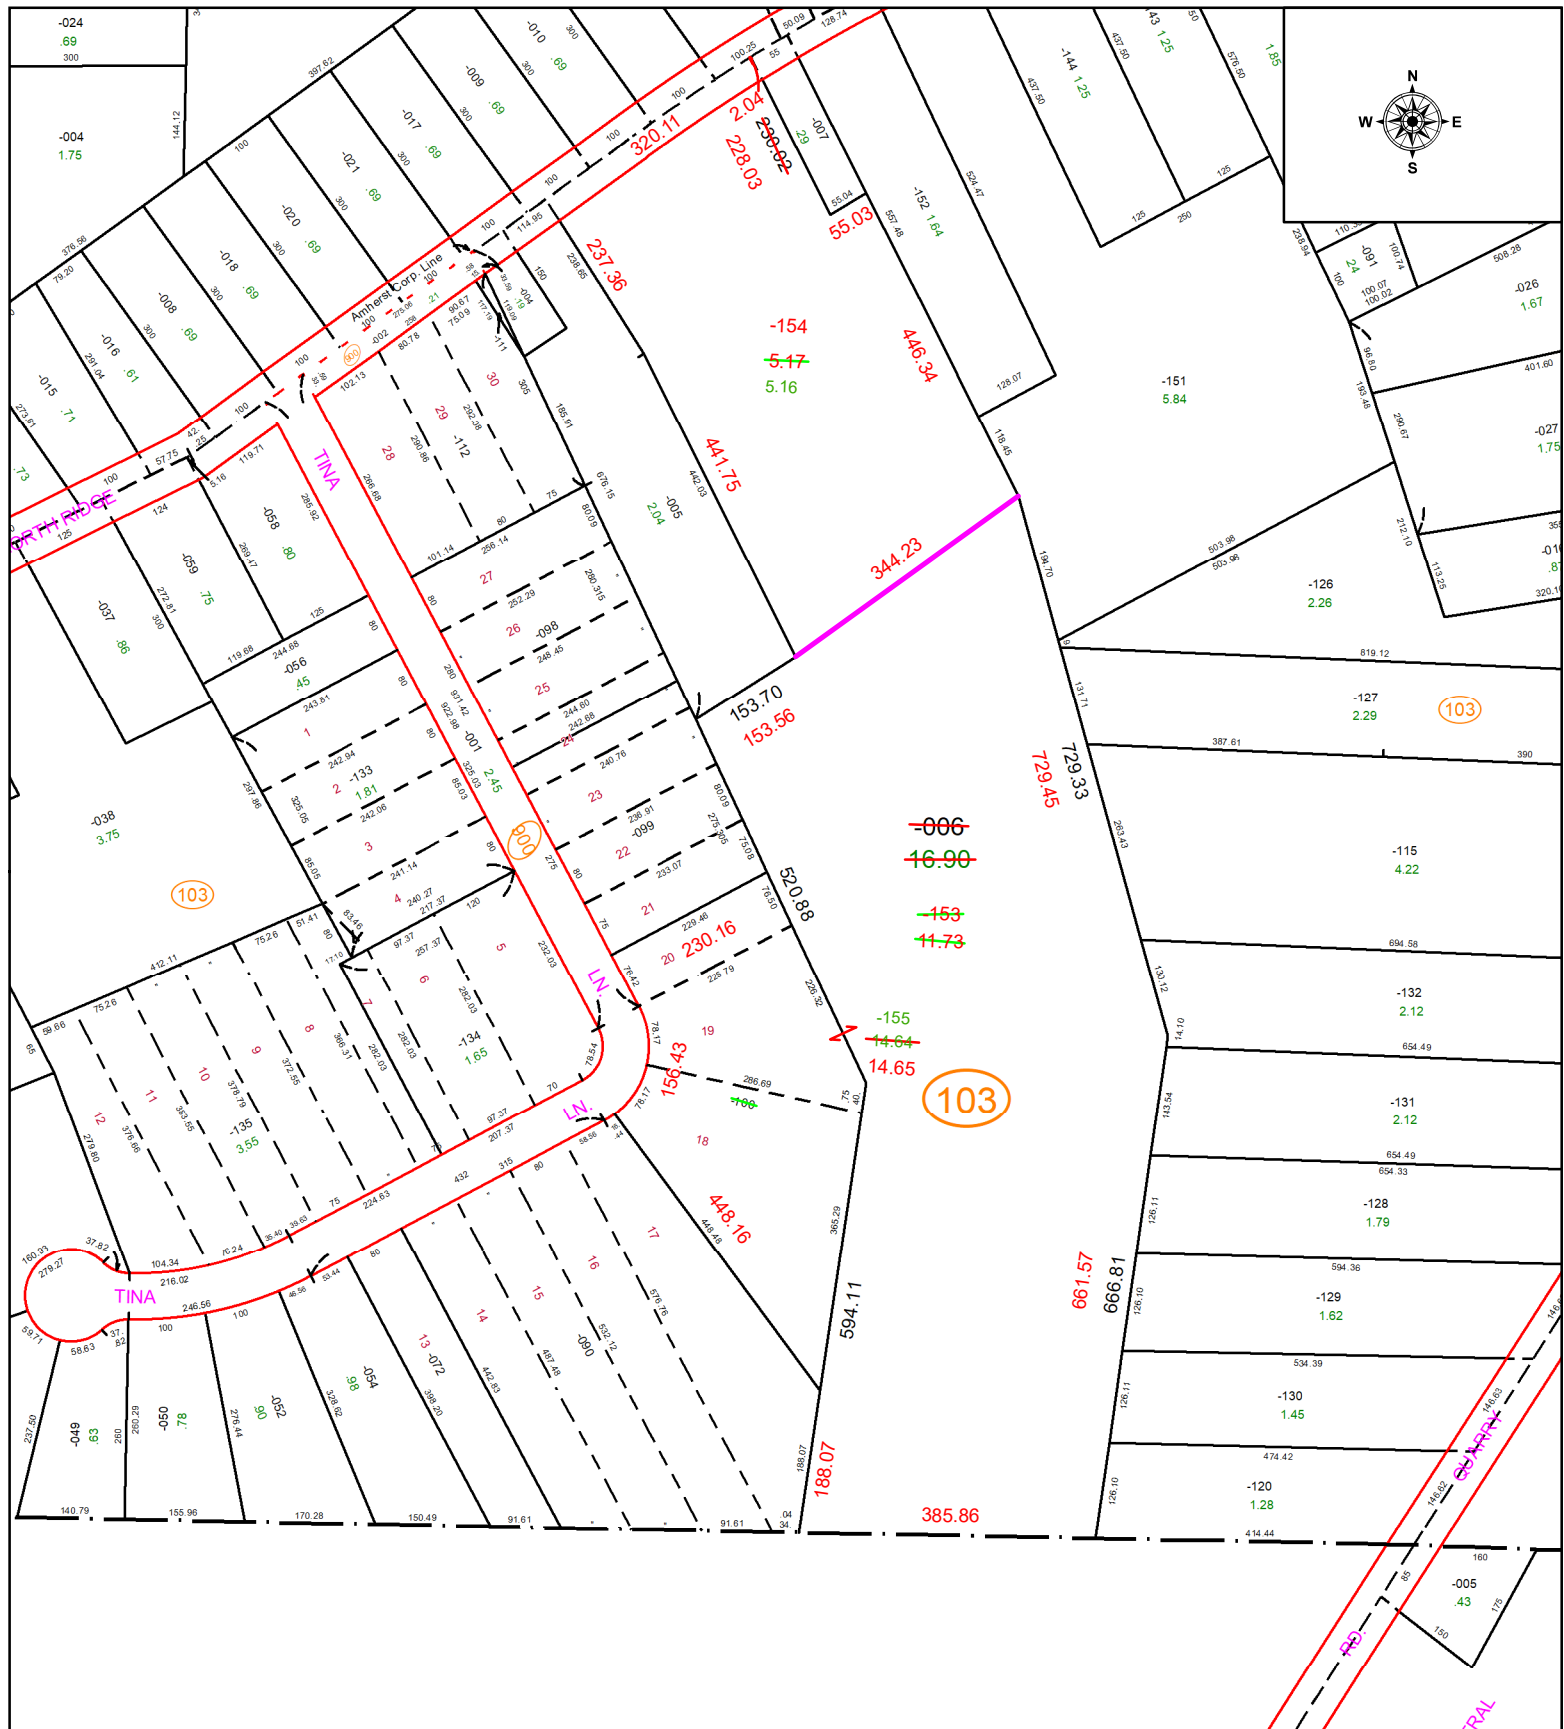

SPLITS/DEEDS PROCESSED

LORAIN COUNTY TAX MAP DEPARTMENT
226 MIDDLE AVE. ELYRIA, OH

SURVEYED BY: JOSHUA RIEDY

SURVEY # 51548

CLOSURE: 1: 325163

MAP PAGE(S): 05-00-097

APPROVED BY: WRZ DATE: 9/25/2025

SCALE: 1" = 250' PRIOR INSTRUMENT: #1999-0617197