
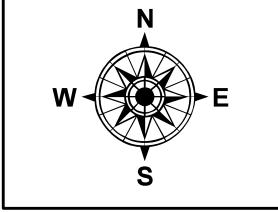


PARENT PARCEL: 02-01-006-105-028

CHILD PARCEL: **FR. & DEPTH TO AC. CORR. PER SURVEY PATRICK McGANNON**

STARTING POINT: INTERSECTION S. LINE OF 2ND ST. & W. LINE OF WASHINGTON AVE.

23-05067-C

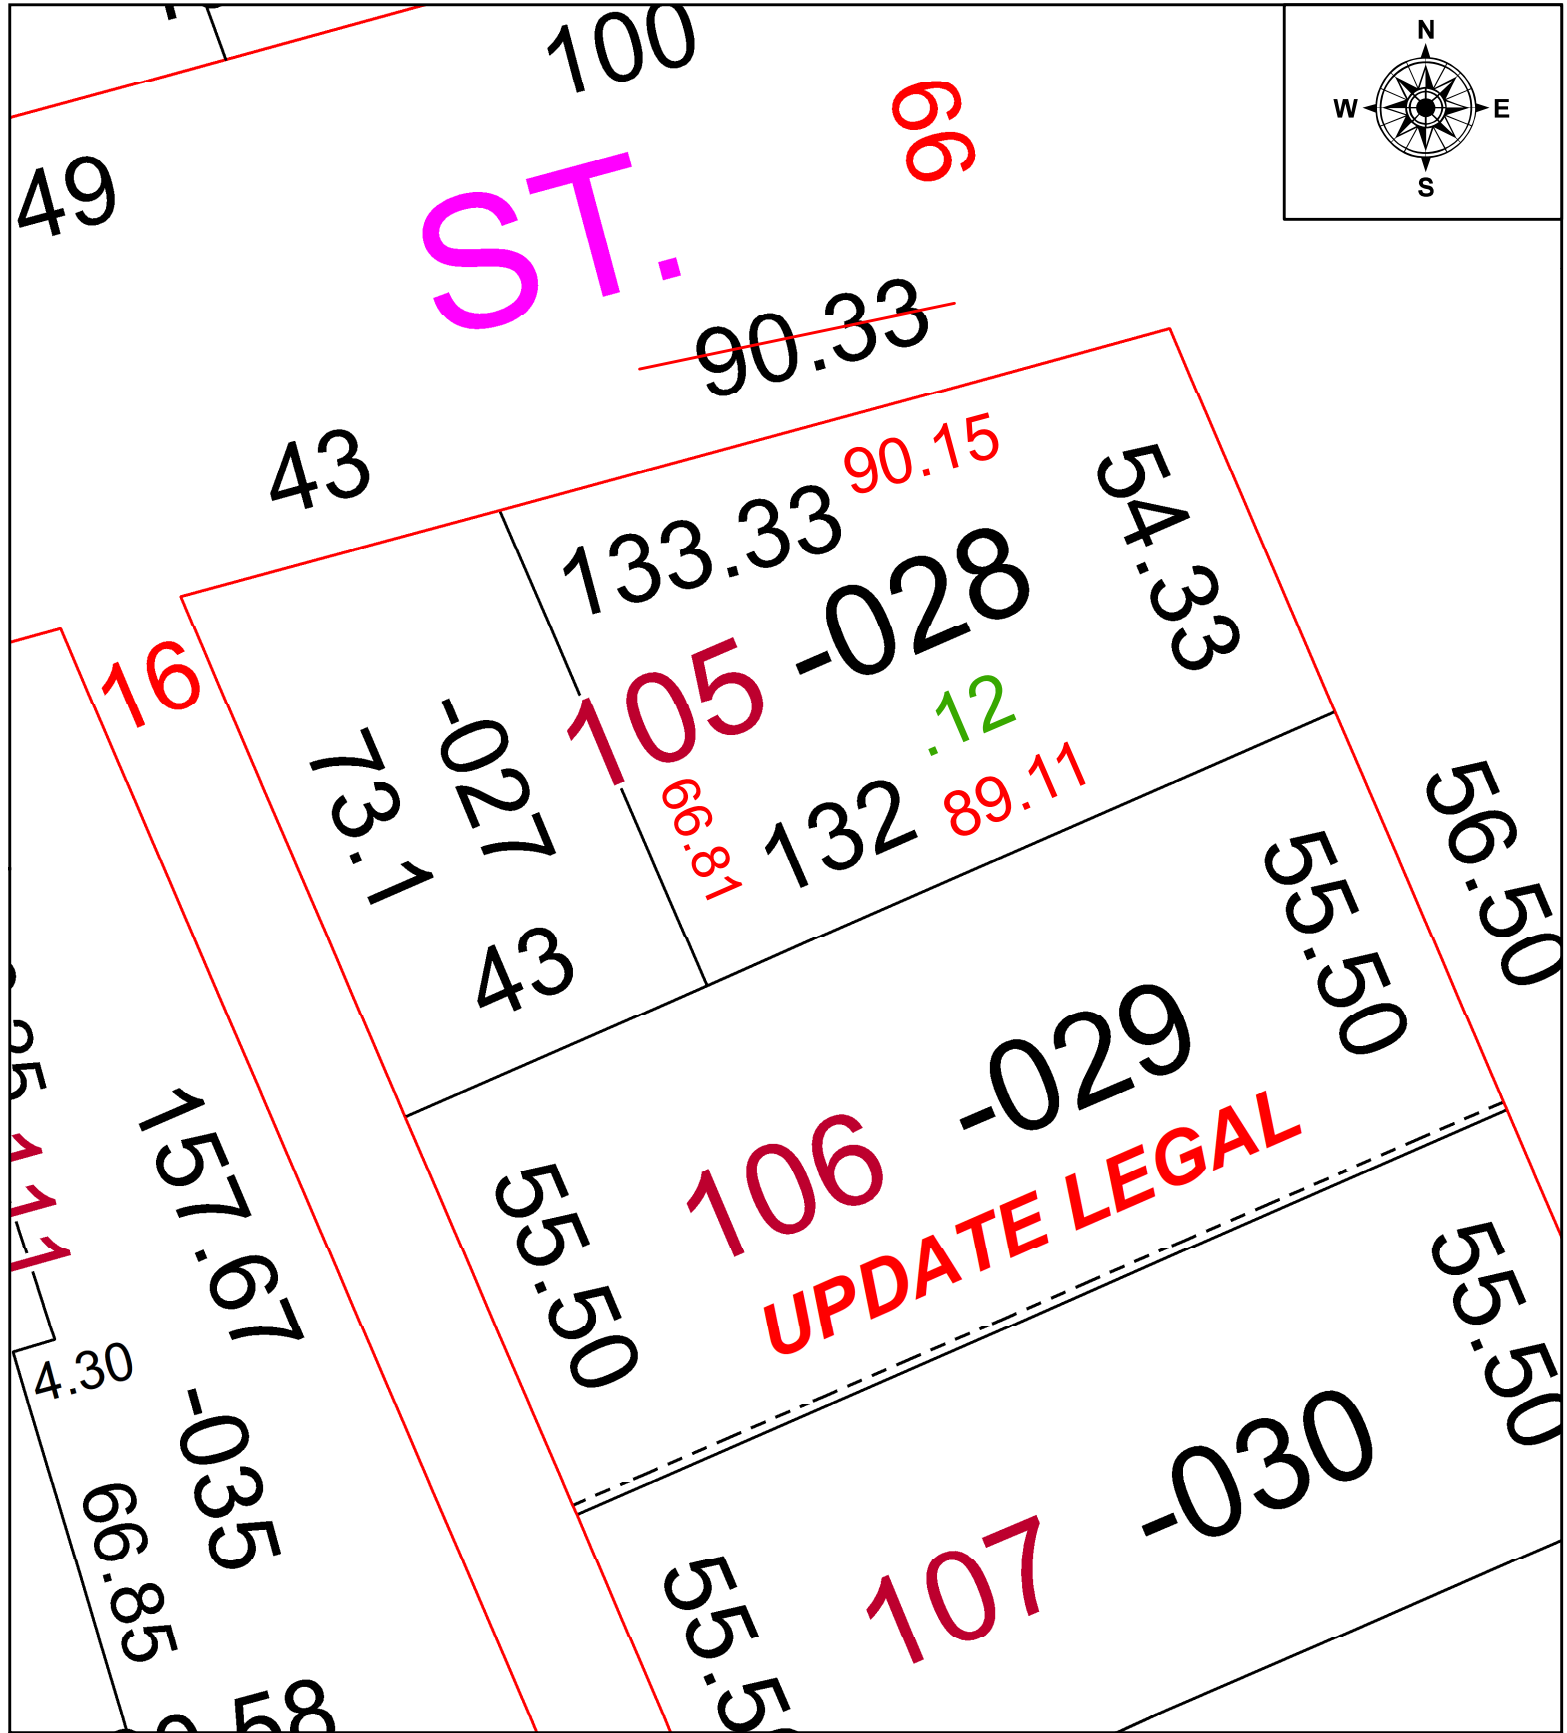

SPLITS/DEEDS PROCESSED
 LORAIN COUNTY TAX MAP DEPARTMENT
 226 MIDDLE AVE. ELYRIA, OH

SURVEYED BY: PATRICK McGANNON SURVEY #: 50654
 CLOSURE: 1:117124
 MAP PAGE(S): 02-01-006
 APPROVED BY: DMA DATE: 4/10/2023
 SCALE: 1" = 25' PRIOR INSTRUMENT: 2021-0808775