
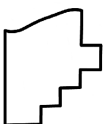
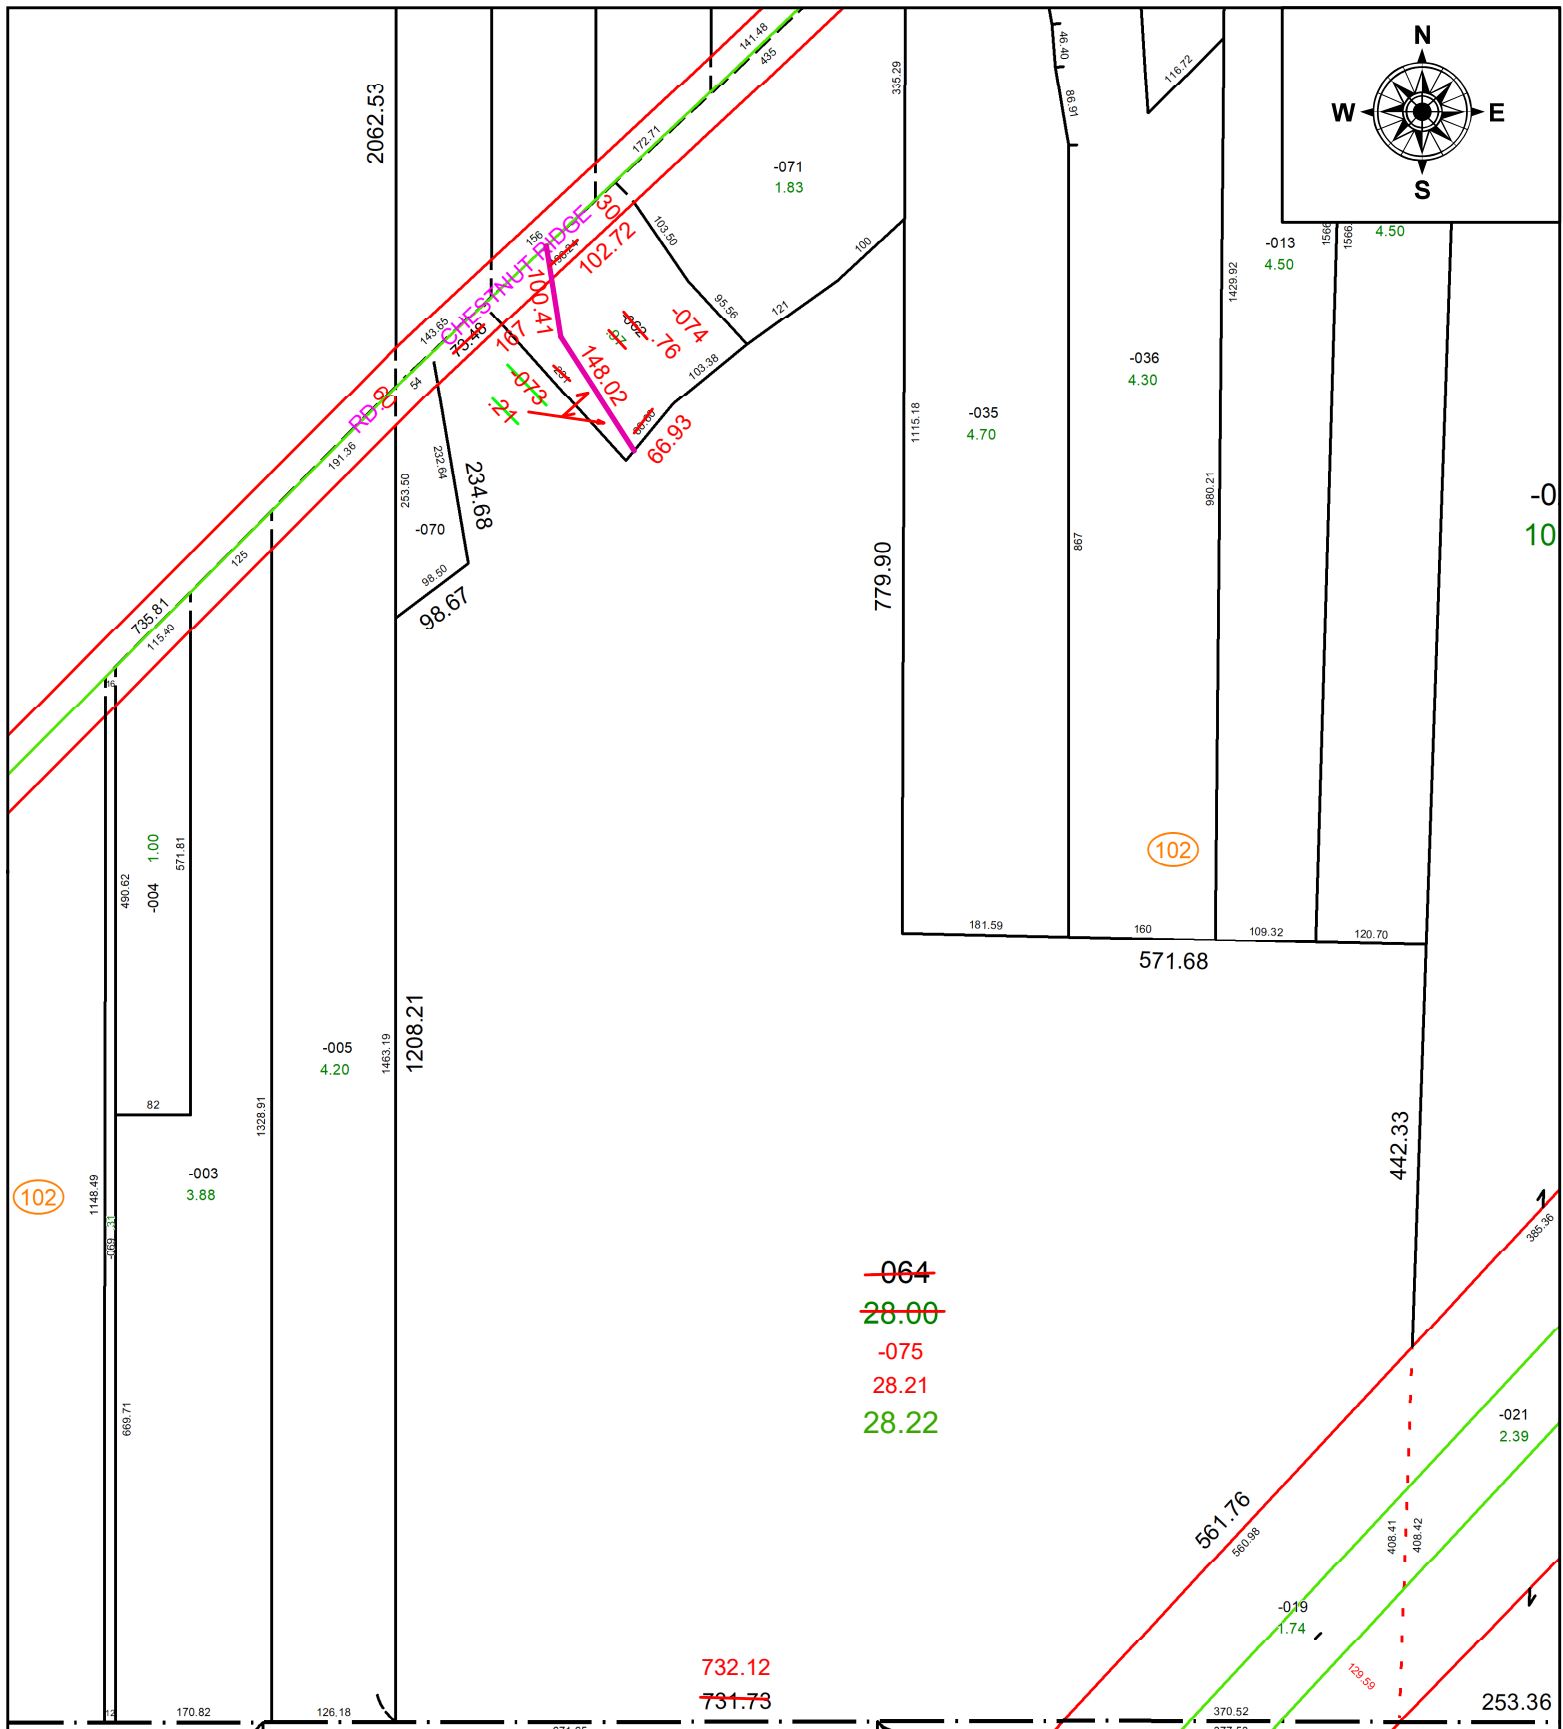


STARTING POINT: AC CORR PER SURV BY ERIC J. MISANKO

25-05067

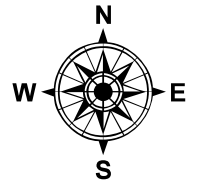

SPLITS/DEEDS PROCESSED
LORAIN COUNTY TAX MAP DEPARTMENT
226 MIDDLE AVE. ELYRIA, OH

SURVEYED BY: ERIC J. MISANKO

SURV # 51552

CLOSURE: 1: 96043

MAP PAGE(S): 07-00-023

APPROVED BY: AC **DATE:** September 29, 2025

SCALE: 1 in = 210 ft

PRIOR INSTRUMENT: 2022- 0866978