
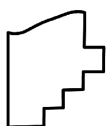


PARENT PARCEL: 04-00-010-112-016

CHILD PARCEL: **AC CORR PER SURV BY RAY E. HOLLIS**

STARTING POINT: C/L OF N RIDGE

23-05068-A

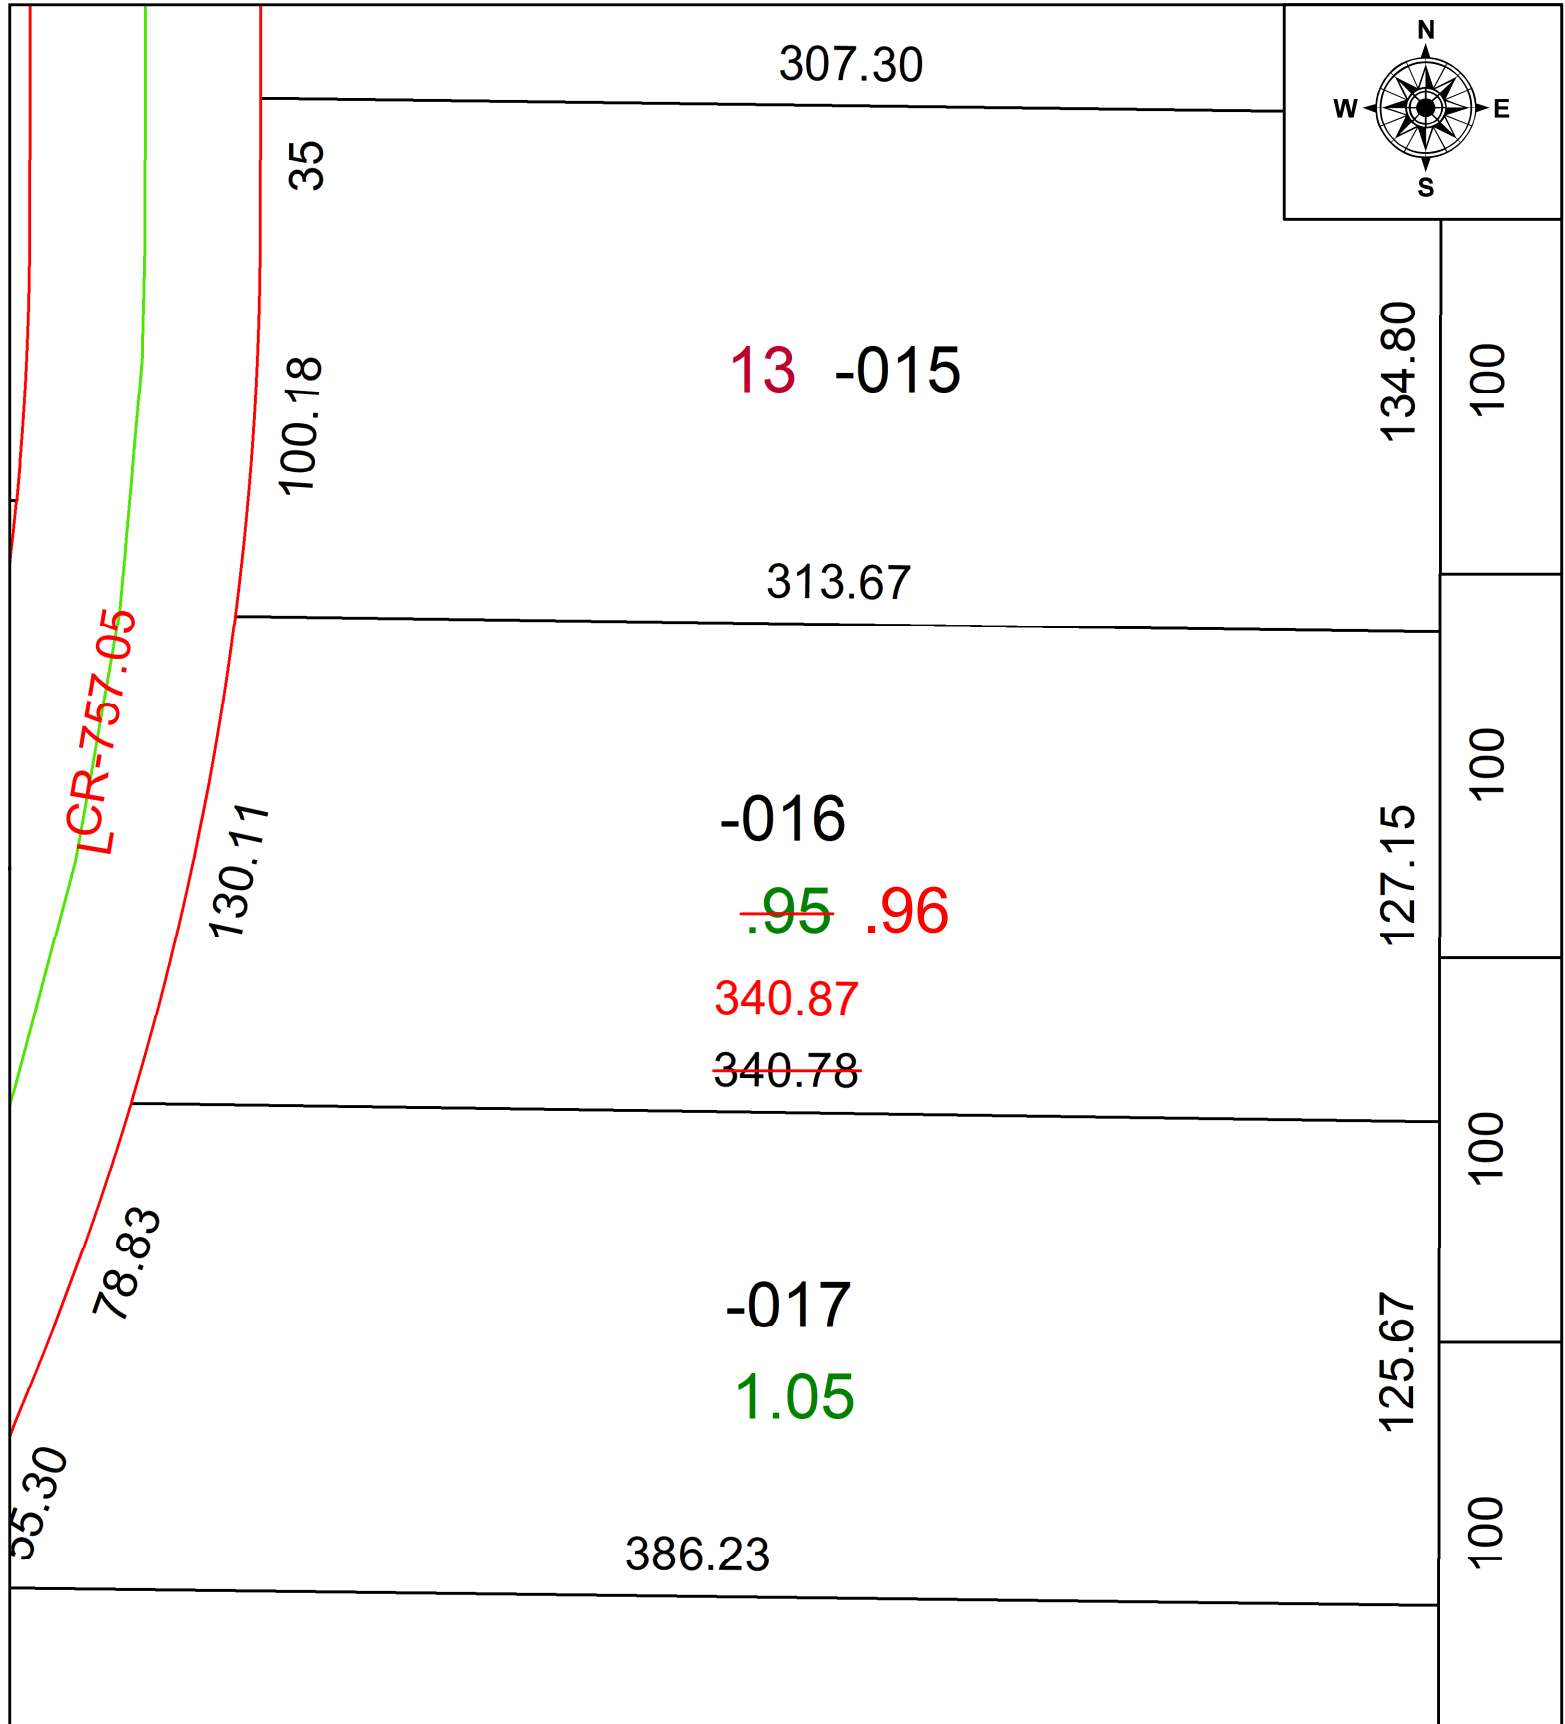

SPLITS/DEEDS PROCESSED
LORAIN COUNTY TAX MAP DEPARTMENT
226 MIDDLE AVE. ELYRIA, OH

SURVEYED BY: RAY E. HOLLIS	SURV # N/A
CLOSURE: N/A	
MAP PAGE(S): 04-00-010	
APPROVED BY: AC	DATE: April 21, 2023
SCALE: 1 in = 50 ft	PRIOR INSTRUMENT: 2008- 0252224