
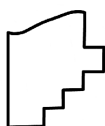
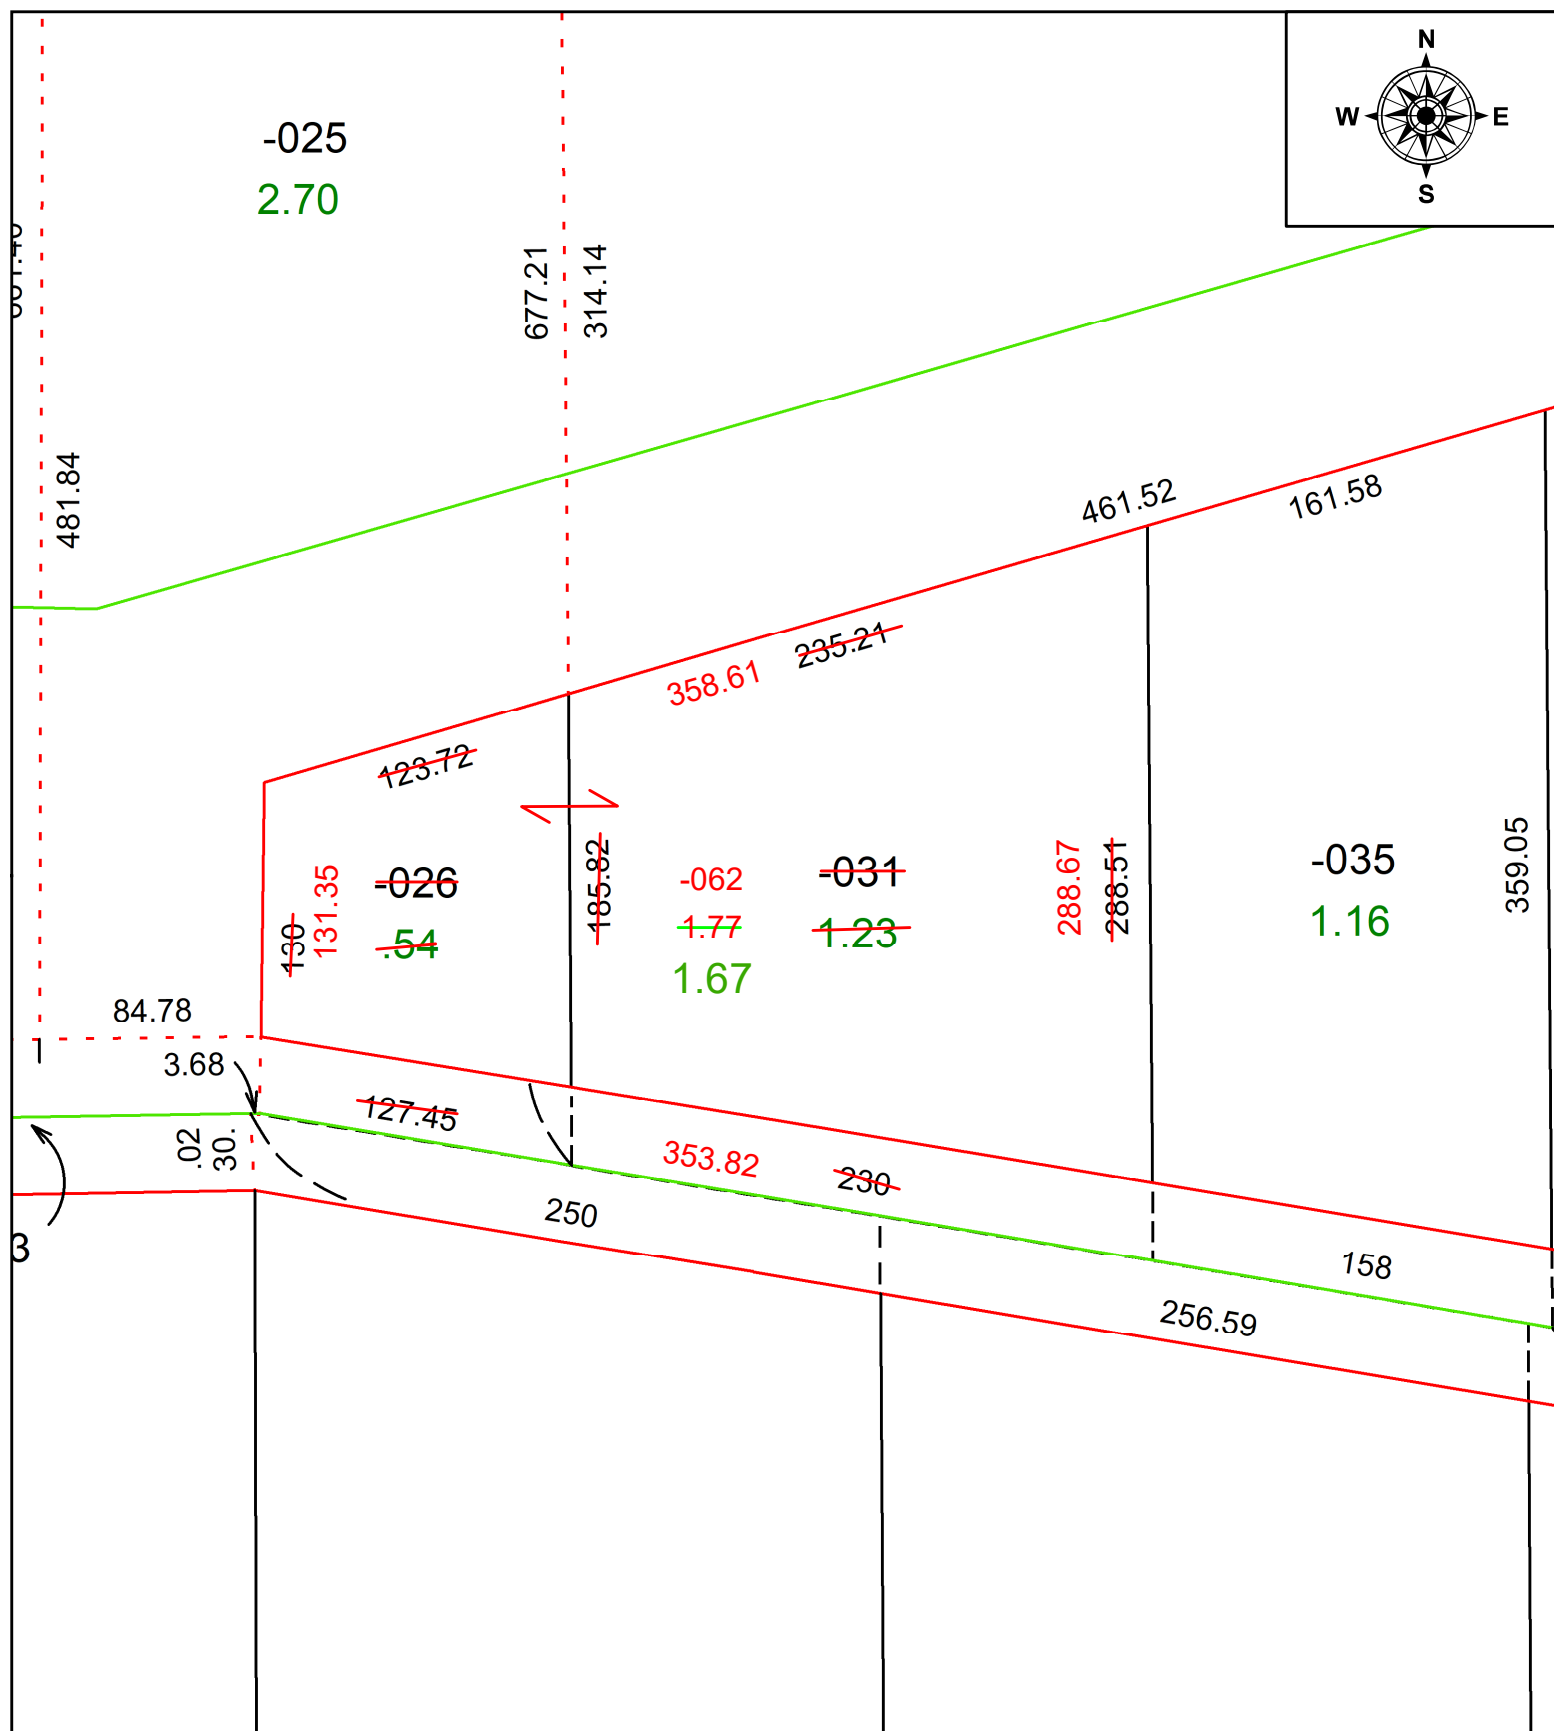


STARTING POINT:

C/L OF JERUSALEM CONNECTOR RD AND JERUSALEM RD

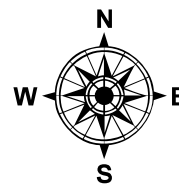

SPLITS/DEEDS PROCESSED

LORAIN COUNTY TAX MAP DEPARTMENT
226 MIDDLE AVE. ELYRIA, OH

SURVEYED BY: TIMOTHY D. HOZALSKI

SURV # 51557

CLOSURE: 1: 100789

MAP PAGE(S): 01-00-030

APPROVED BY: AC **DATE:** October 03, 2025

SCALE: 1 in = 75 ft **PRIOR INSTRUMENT:** 2023- 0922985