
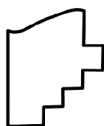
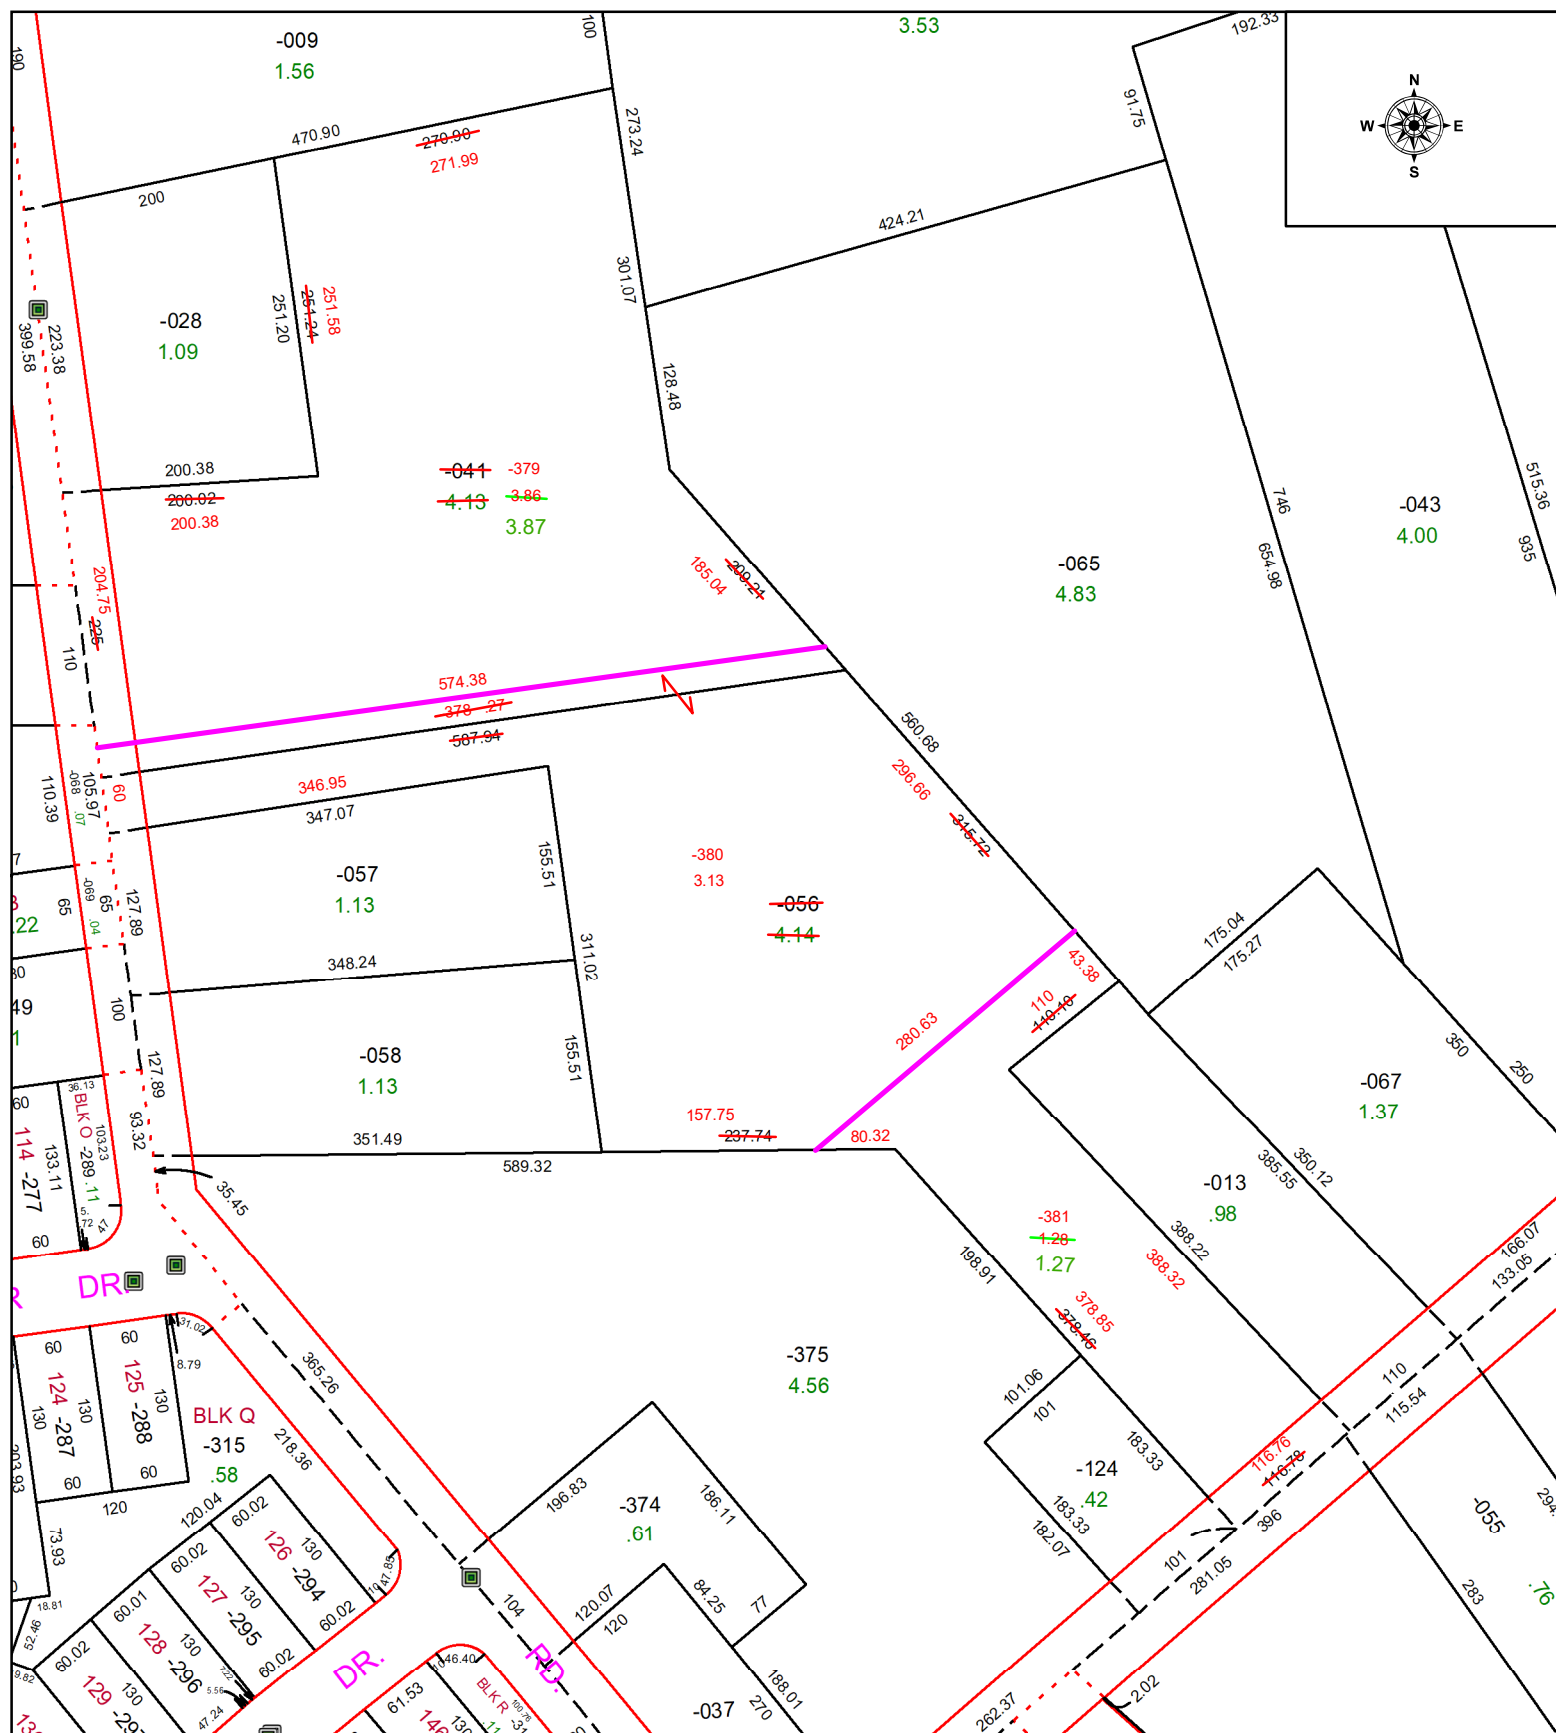


25-05069

C/LS OF CASE RD & MOON RD

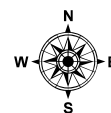

LORAIN COUNTY TAX MAP DEPARTMENT
226 MIDDLE AVE. ELYRIA, OH

SCALE: 1" = 150' **PRIOR INSTRUMENT:** #2014-0496538

DATE: 10/8/2025