
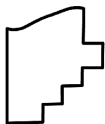


PARENT PARCEL: 10-00-004-131-034, -068 & -081

CHILD PARCEL: 10-00-004-131-086, -087, & -088

STARTING POINT: NE CORNER OF BLK A IN VOL 19, PG 39

25-05070

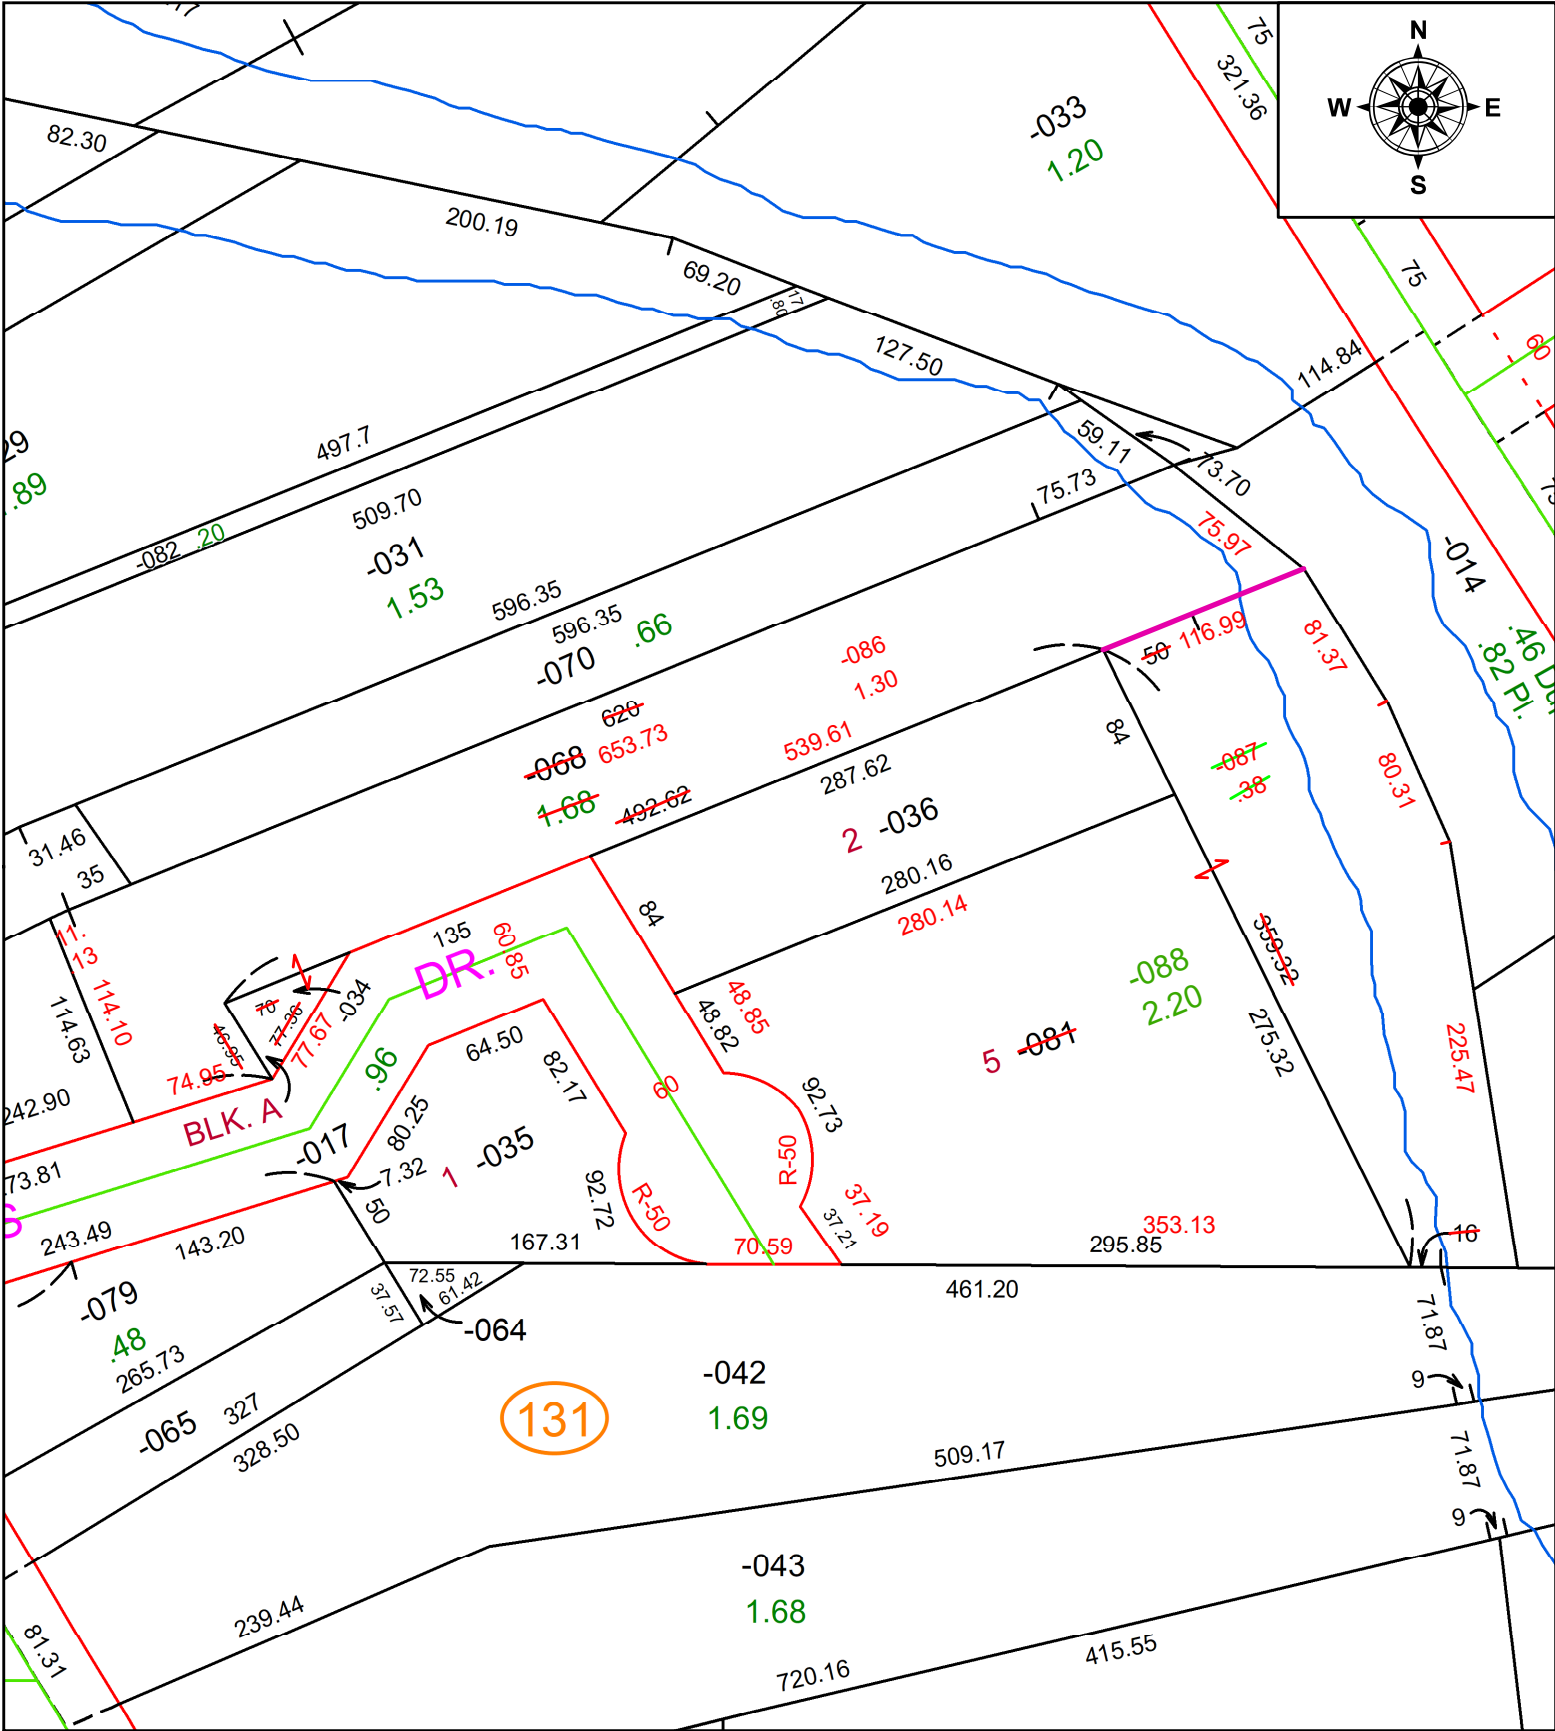

SPLITS/DEEDS PROCESSED
LORAIN COUNTY TAX MAP DEPARTMENT
226 MIDDLE AVE. ELYRIA, OH

SURVEYED BY: WILFREDO BARBOSA	SURV # 51559
CLOSURE: 1: 216069	
MAP PAGE(S): 10-00-004	
APPROVED BY: AC	DATE: October 03, 2025
SCALE: 1 in = 100 ft	PRIOR INSTRUMENT: 2021- 0832980