

PARENT PARCEL:

04-00-004-103-017

AC CORR PER SURVEYOR RYAN SNEZEK



CHILD PARCEL:

04-00-004-103-032 & -033

STARTING POINT:

SOUTHWEST CORNER OF O.L. SECTION NO. 4

25-05071

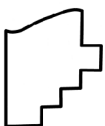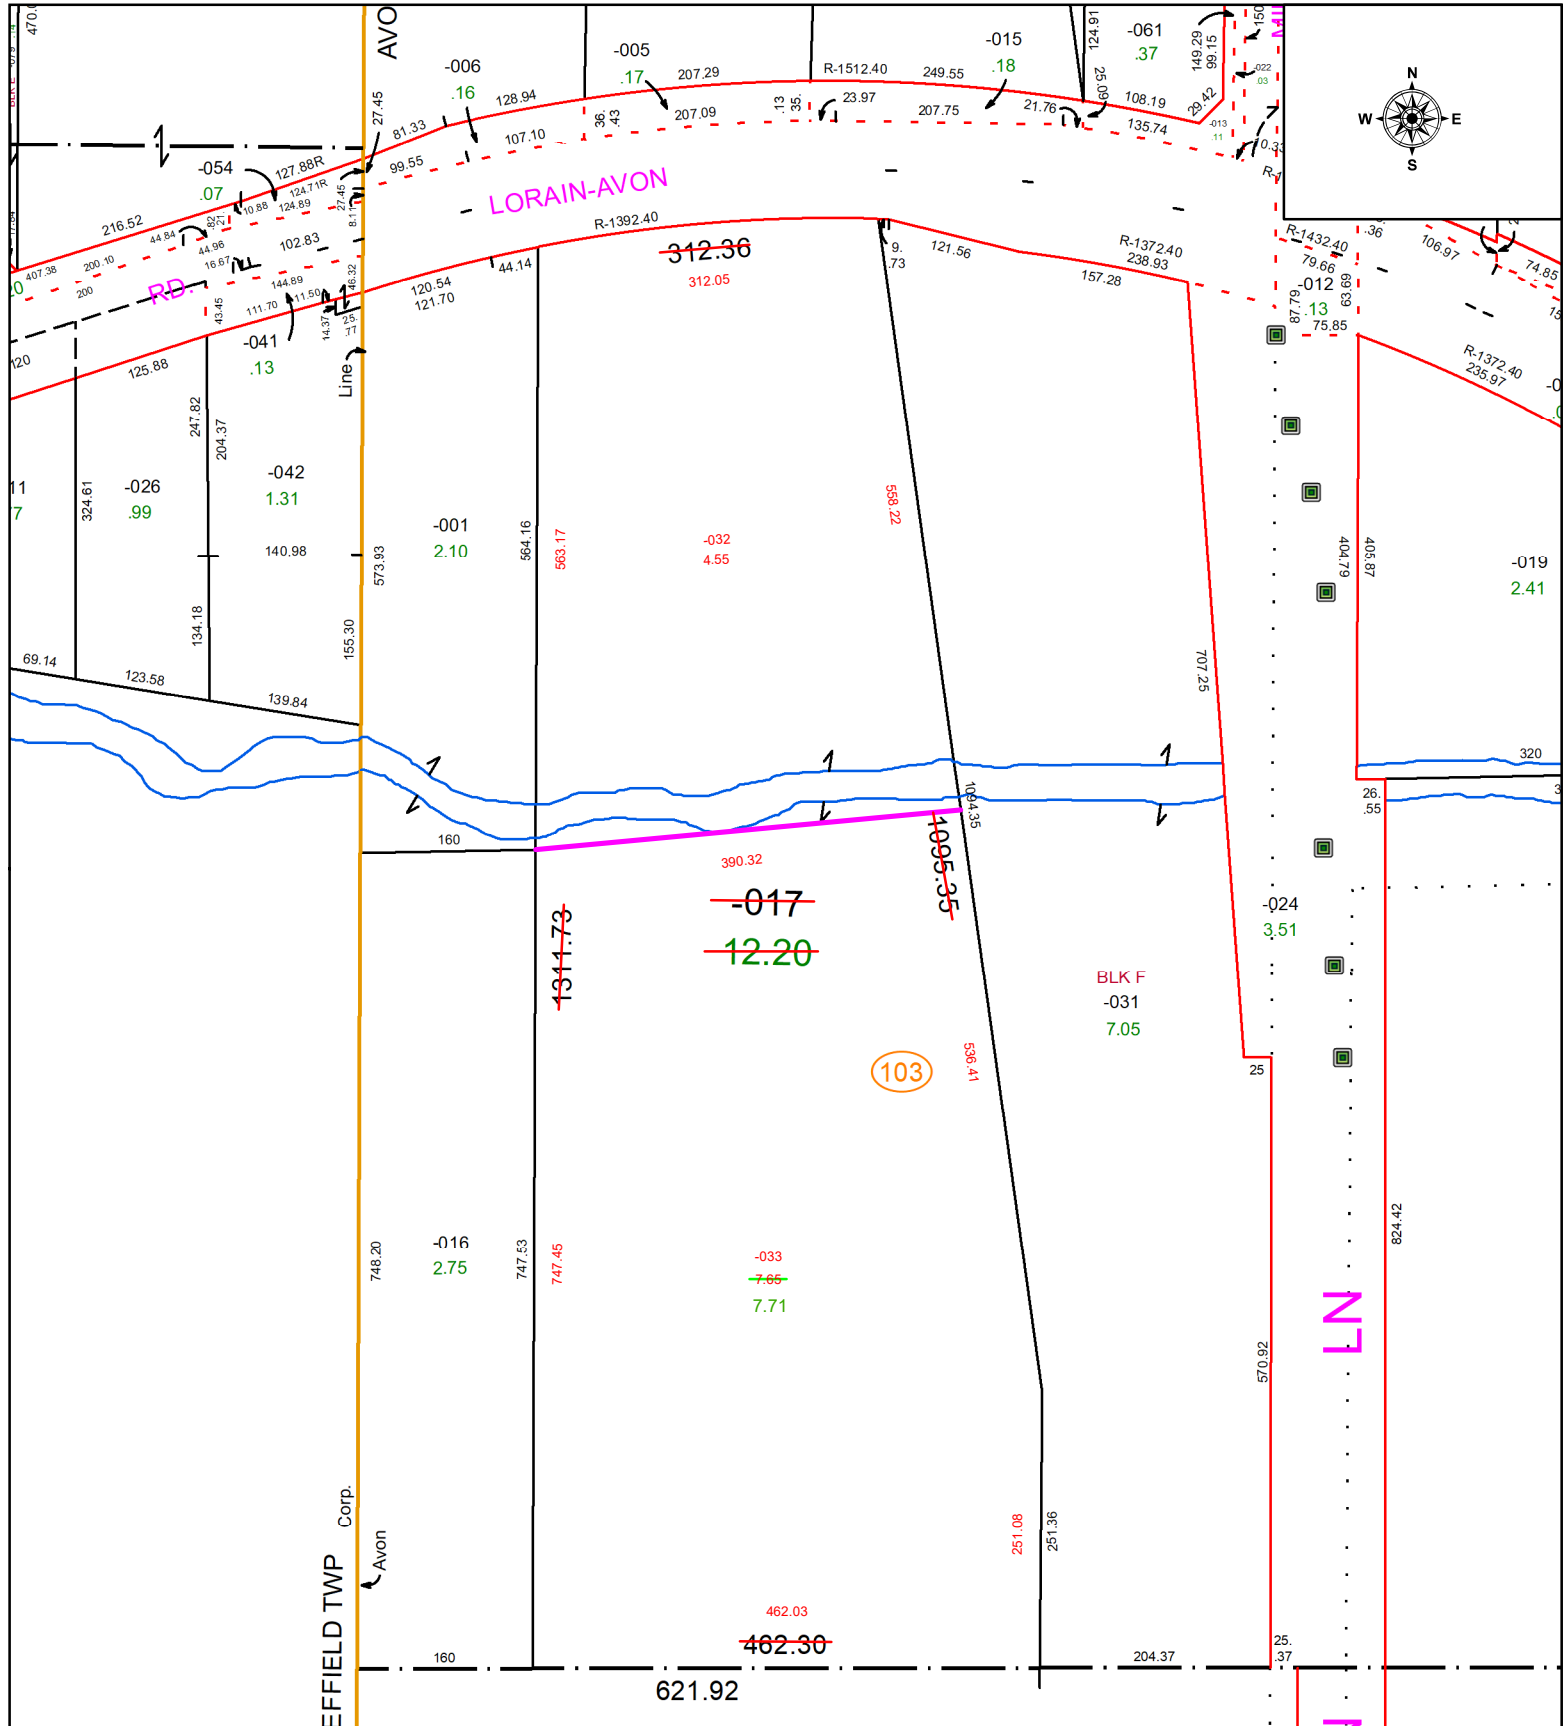

SPLITS/DEEDS PROCESSED

LORAIN COUNTY TAX MAP DEPARTMENT
226 MIDDLE AVE. ELYRIA, OH

SURVEYED BY: RYAN SNEZEK

SURVEY # 51560

CLOSURE: 1: 528096

MAP PAGE(S): 04-00-004

APPROVED BY: WRZ DATE: 10/6/2025

SCALE: 1" = 175 PRIOR INSTRUMENT: ORV 1330/800