
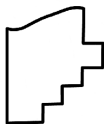


PARENT PARCEL: 16-00-036-105-004
CHILD PARCEL: 16-00-036-105-008 & -009
STARTING POINT: SW CORNER OF O/L 36

AC CORR PER SURVY BY THOMAS A. SIMON

25-05078

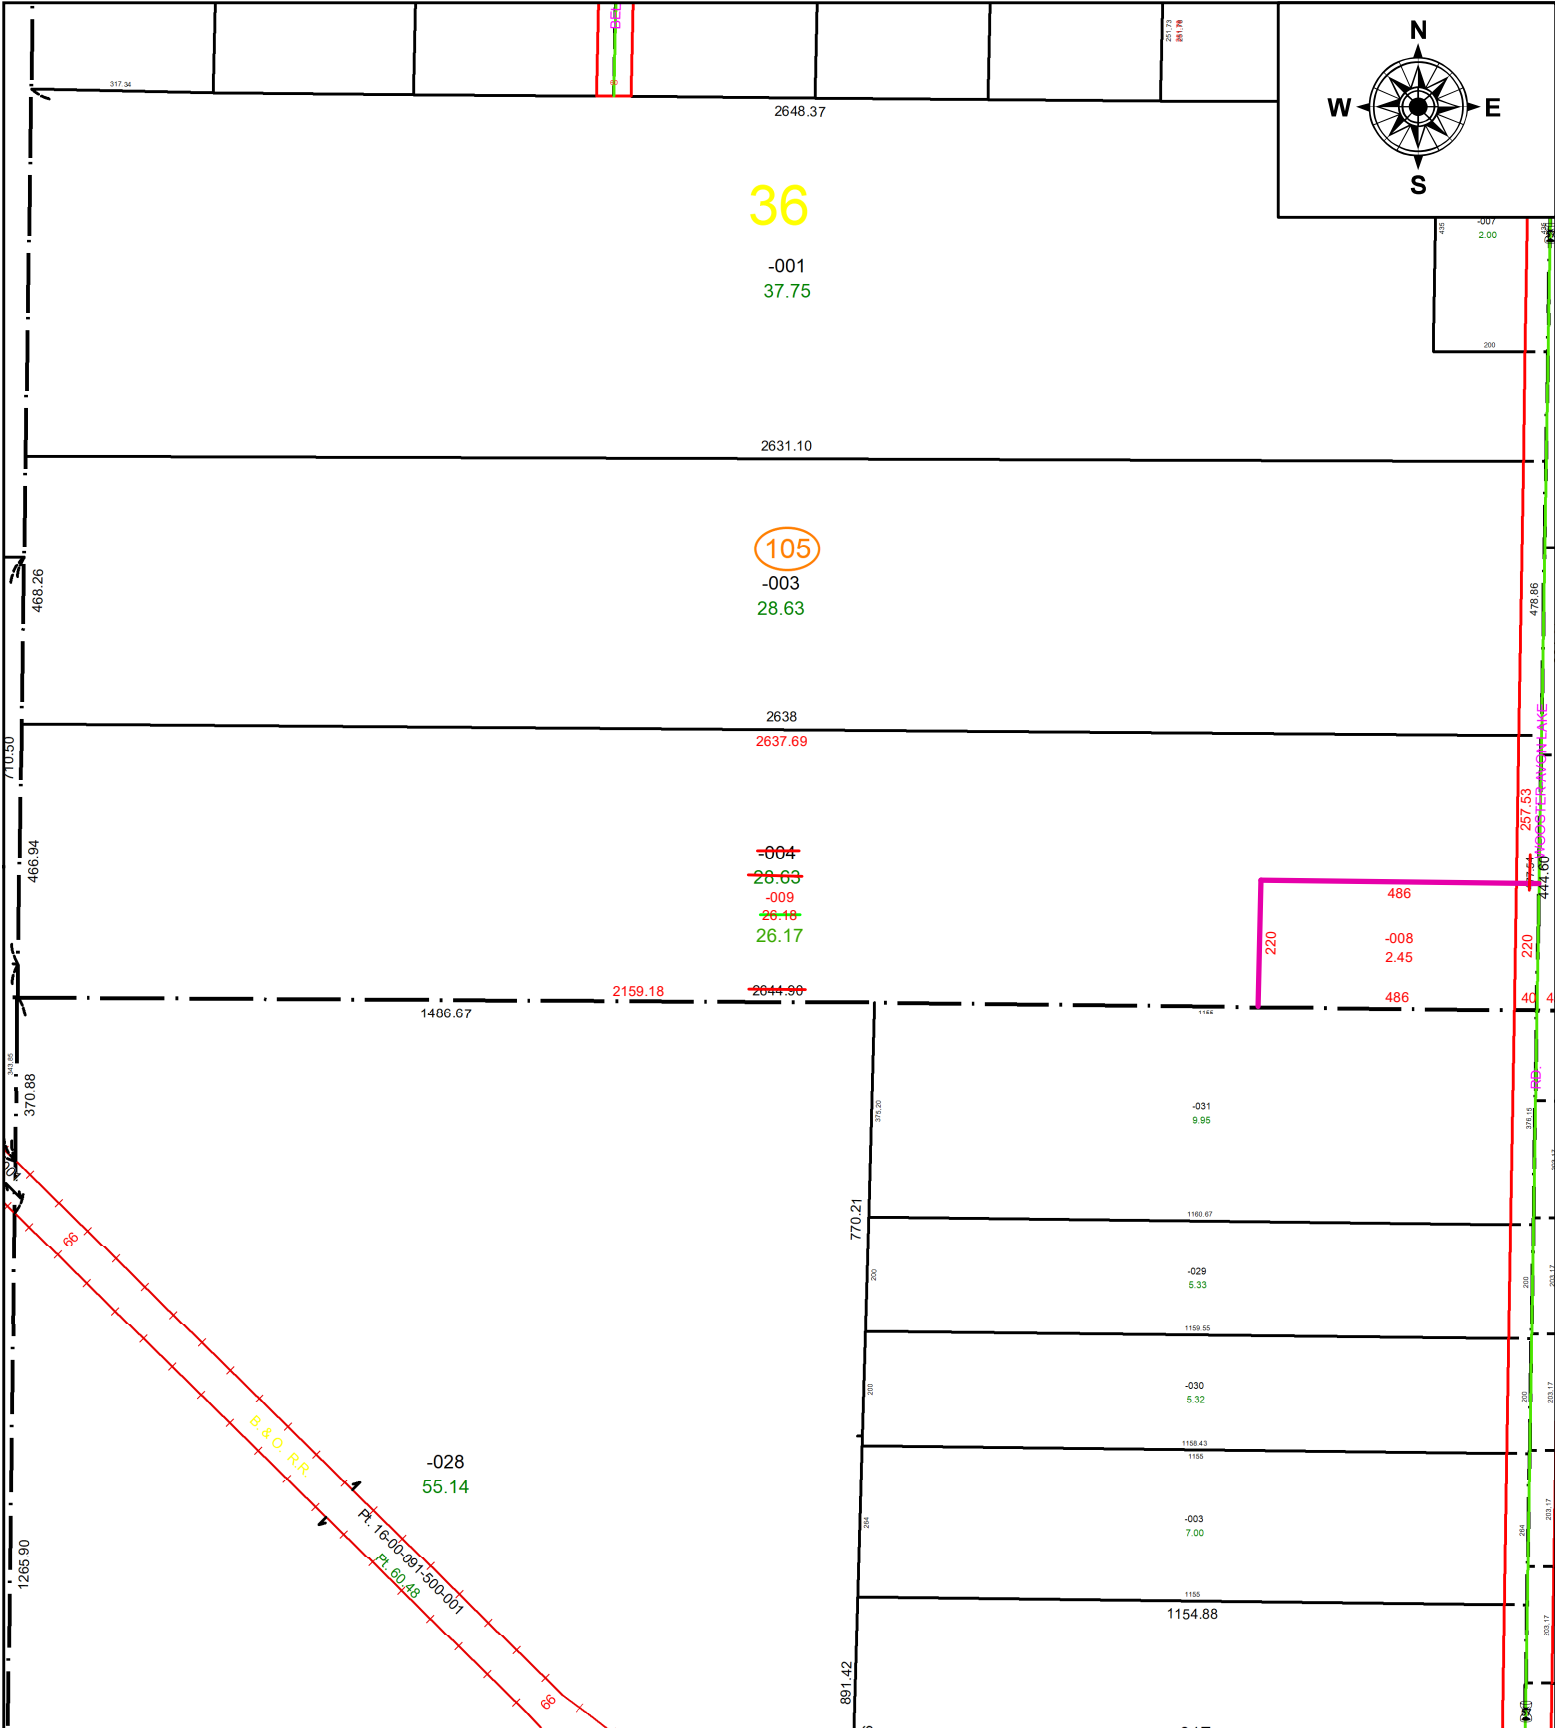

SPLITS/DEEDS PROCESSED
LORAIN COUNTY TAX MAP DEPARTMENT
226 MIDDLE AVE. ELYRIA, OH

SURVEYED BY: THOMAS A. SIMON SURV # 51574
CLOSURE: 1: INF
MAP PAGE(S): 16-00-036
APPROVED BY: AC DATE: October 22, 2025
SCALE: 1 in = 335 ft PRIOR INSTRUMENT: 2021- 0847296