
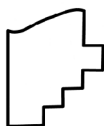
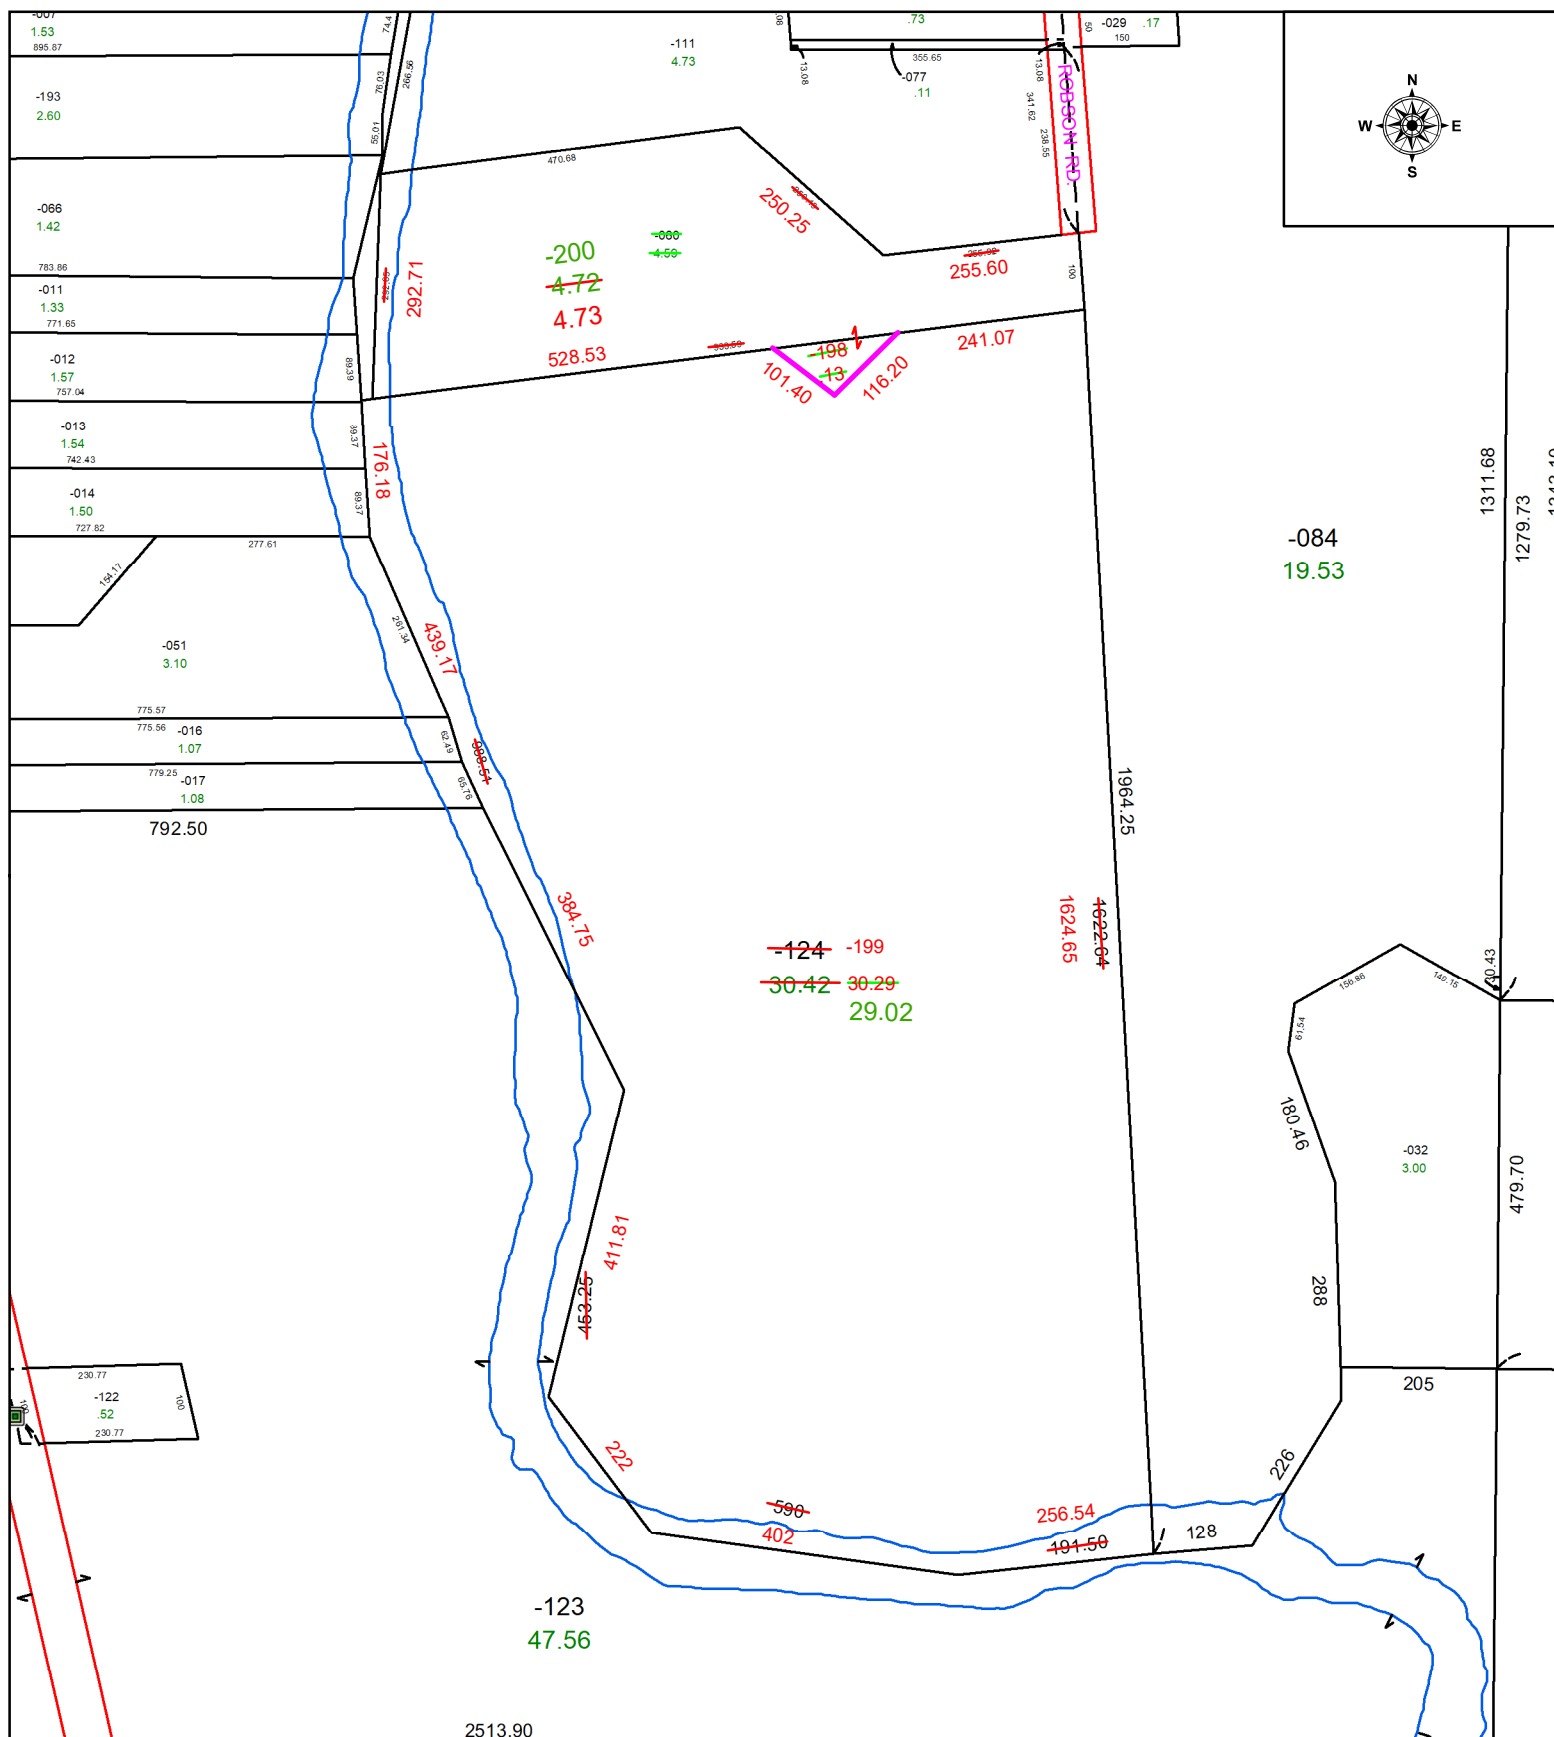


25-05082

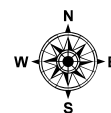

LORAIN COUNTY TAX MAP DEPARTMENT
226 MIDDLE AVE. ELYRIA, OH

SCALE: 1" = 250 **PRIOR INSTRUMENT:** ORV 35/428