
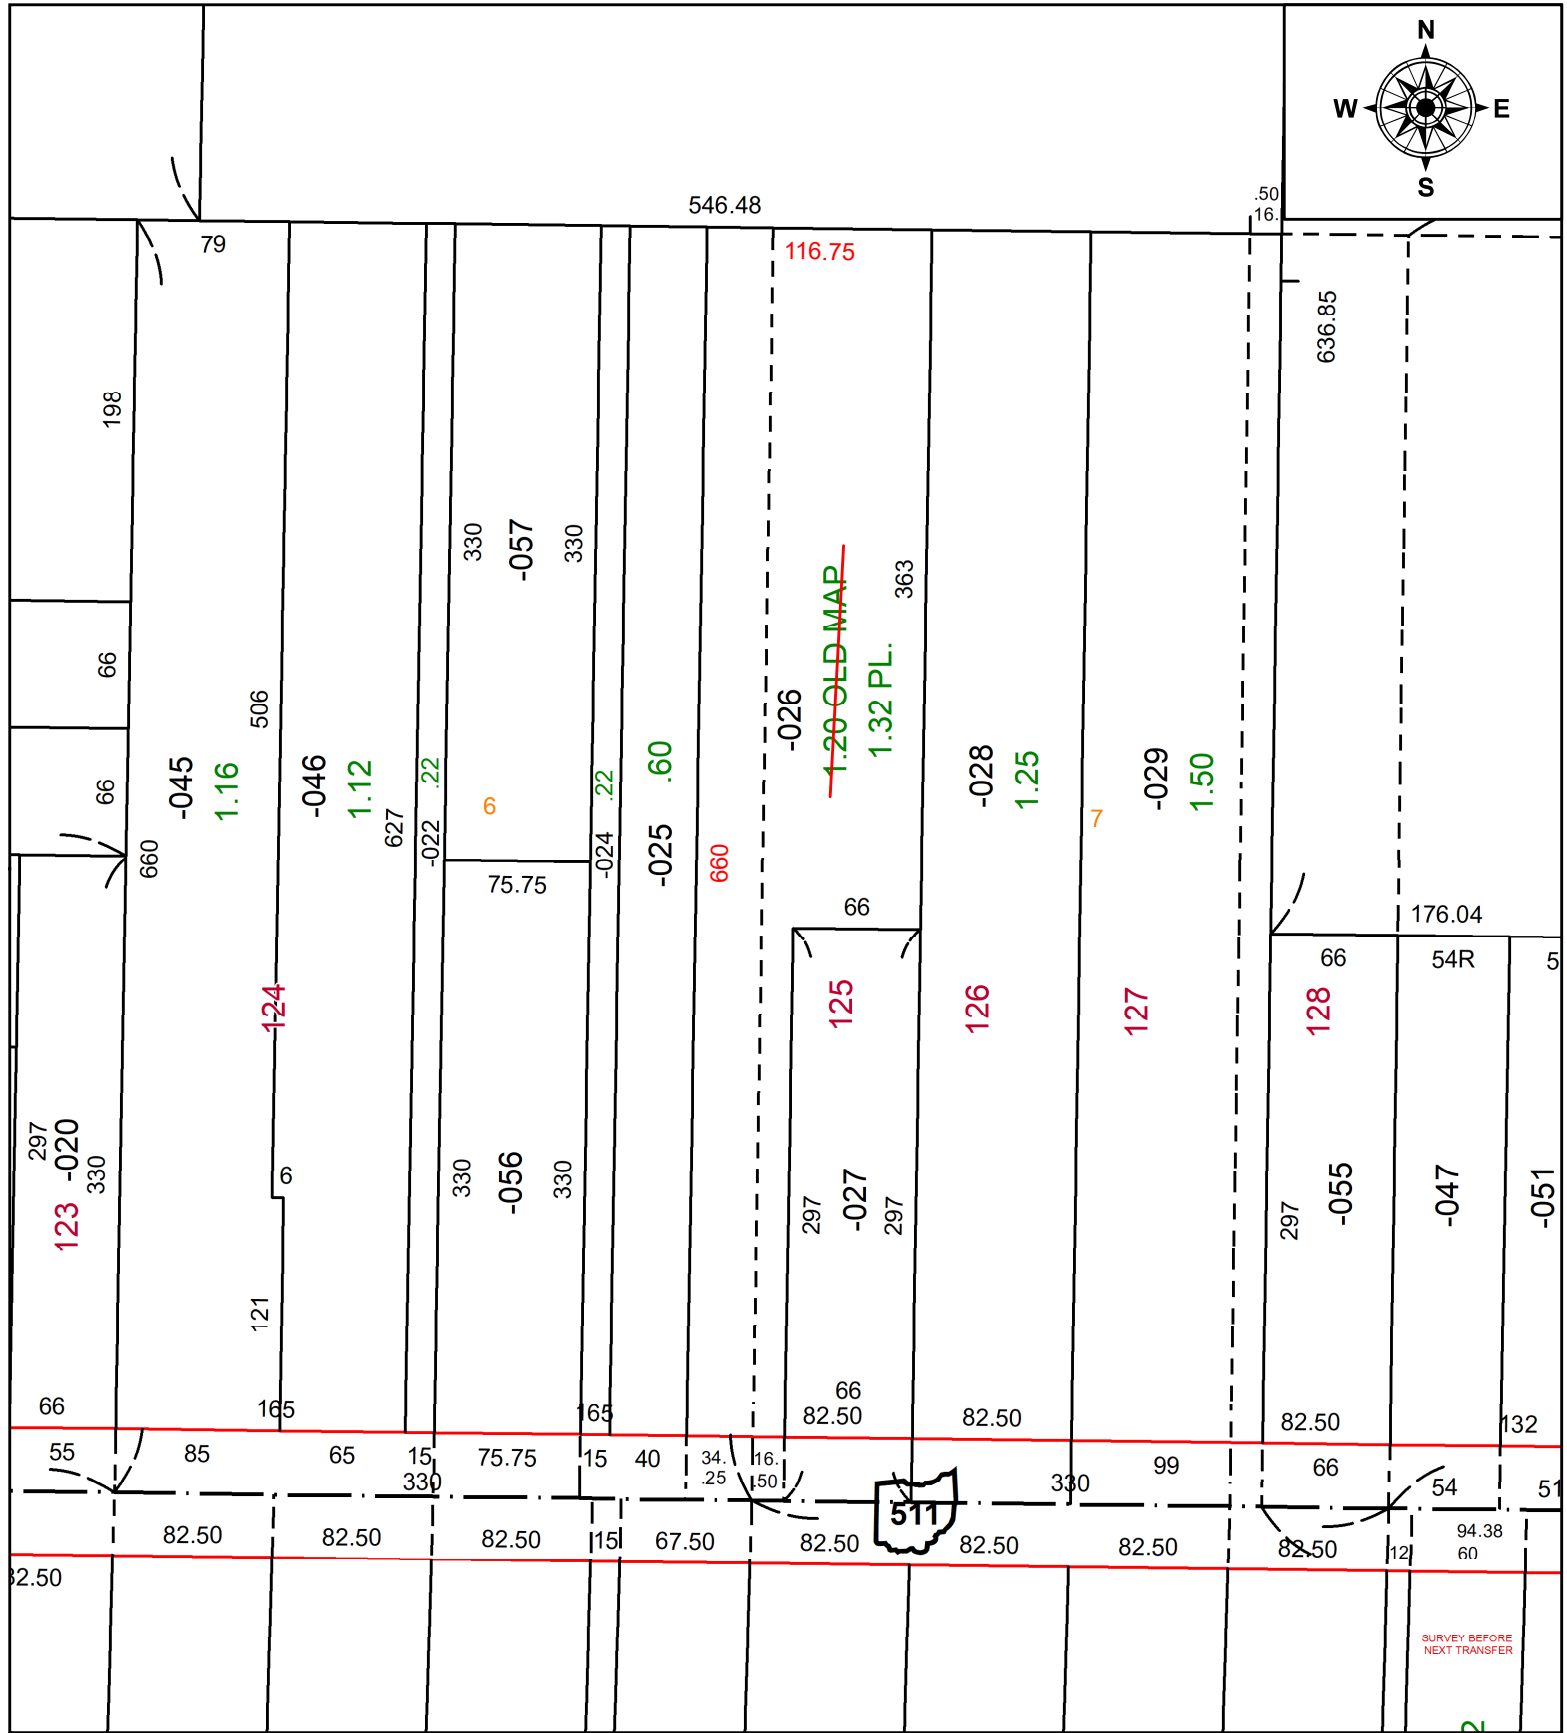


PARENT PARCEL: 09-00-076-104-026

CHILD PARCEL: AC. CORR. PER SURVEY C.E. PENFOUND 7/13/1956

STARTING POINT: N/A

23-05085-A

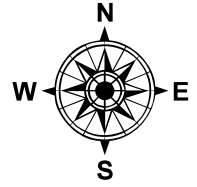

**SPLITS/DEEDS PROCESSED**  
LORAIN COUNTY TAX MAP DEPARTMENT  
226 MIDDLE AVE. ELYRIA, OH

SURVEYED BY: C.E. PENFOUND SURVEY #: 38646  
CLOSURE: N/A  
MAP PAGE(S): 09-000-76  
APPROVED BY: DMA DATE: 5/22/2023  
SCALE: 1" = 100' PRIOR INSTRUMENT: 1995-0362616