
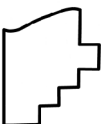
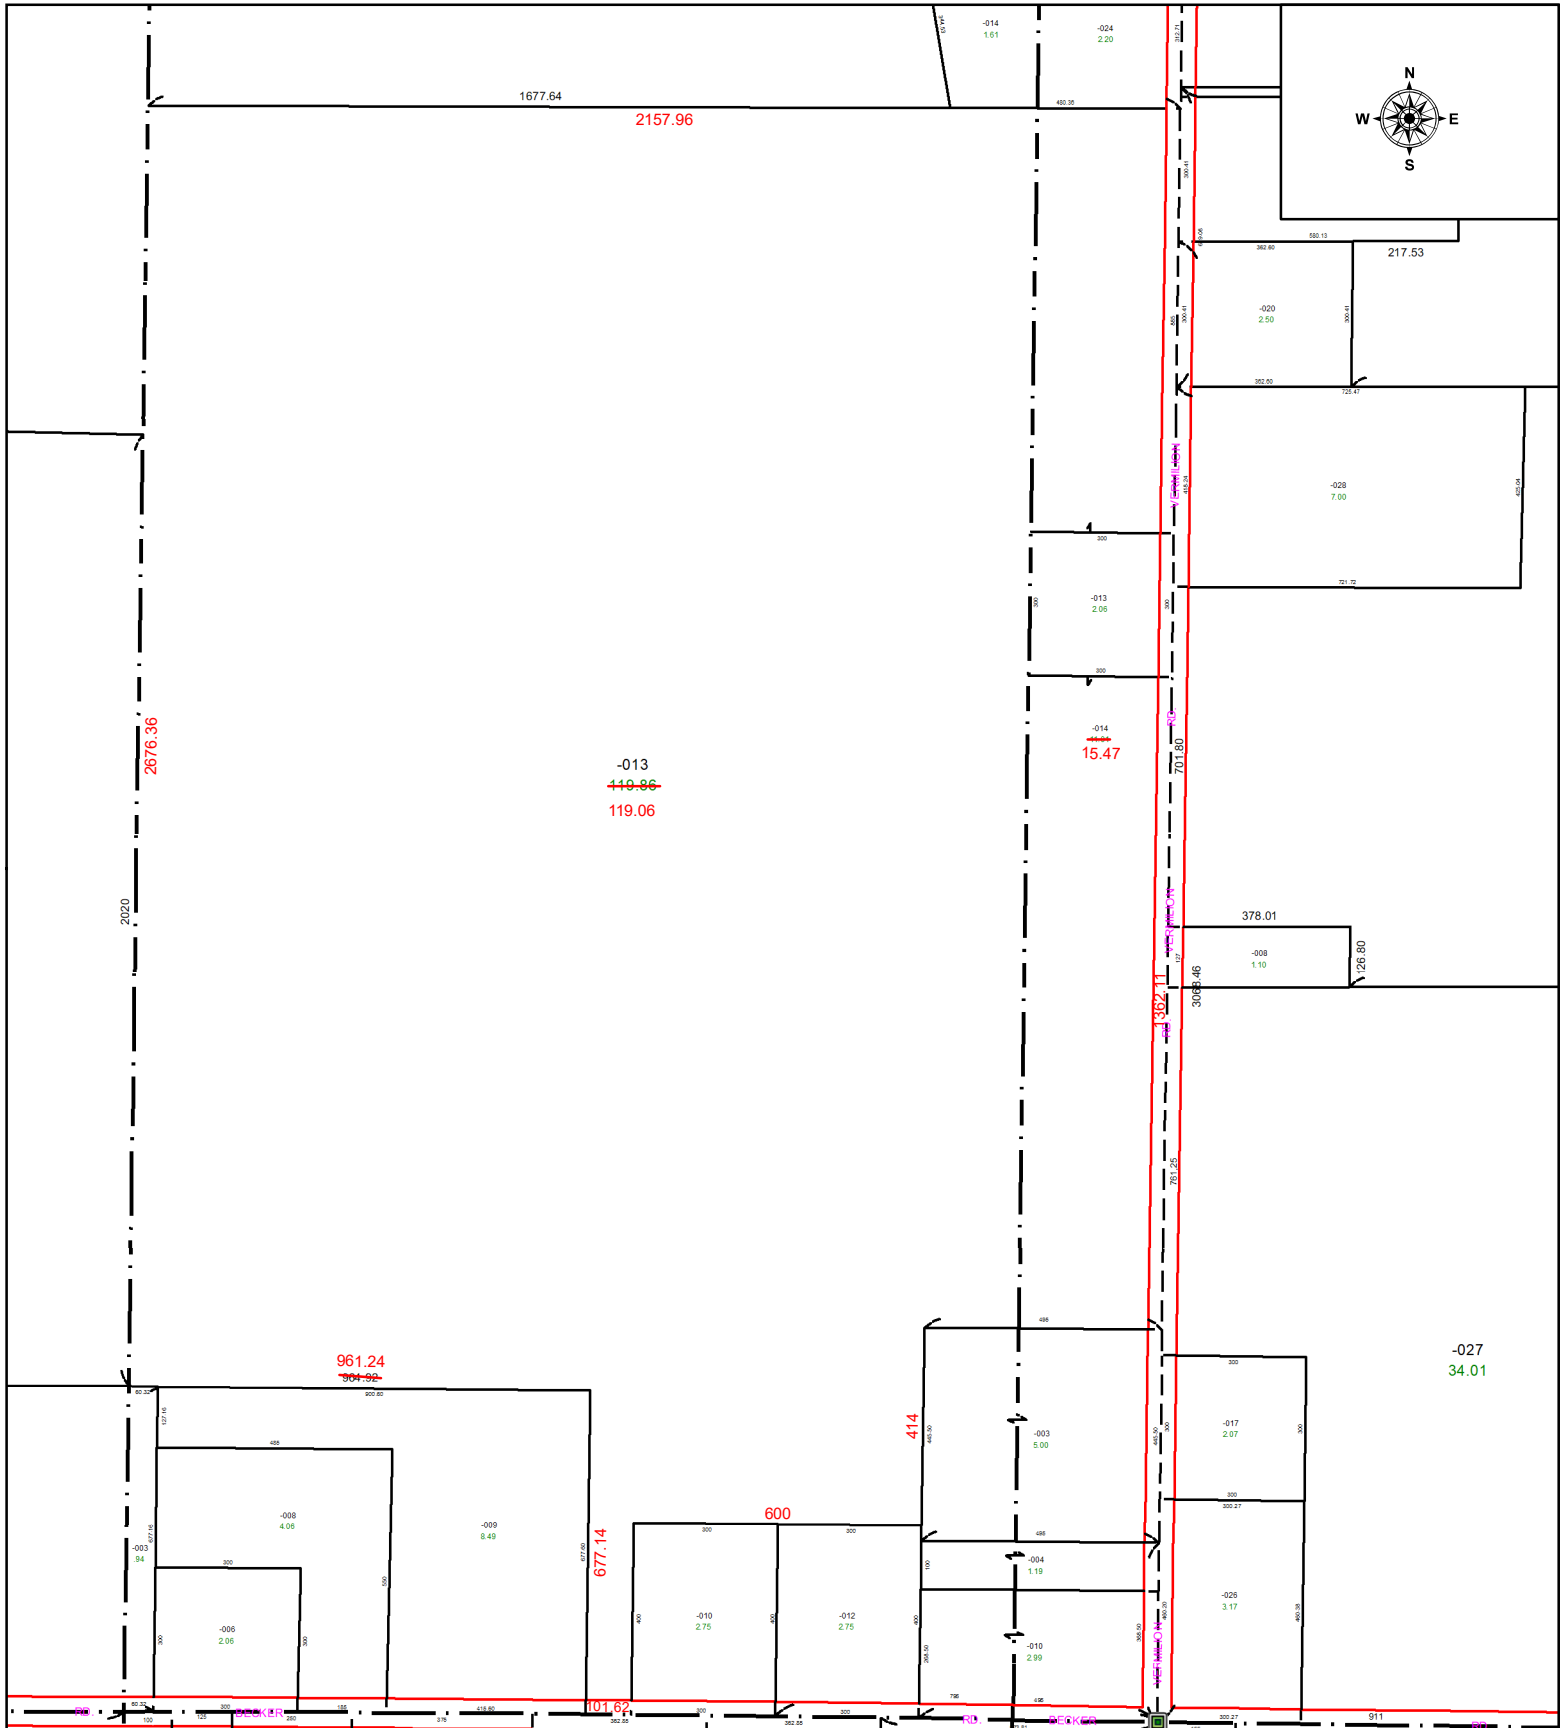


STARTING POINT: INTERSECTION OF C/LS OF BAIRD RD & BECKER RD

25-05086

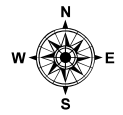

SPLITS/DEEDS PROCESSED
LORAIN COUNTY TAX MAP DEPARTMENT
226 MIDDLE AVE. ELYRIA, OH

SURVEYED BY: THOMAS SIMON **SURVEY #** 51600
CLOSURE: 1: 1724106
MAP PAGE(S): 08-12-005 & 08-12-006
APPROVED BY: WRZ **DATE:** 11/19/2025
SCALE: 1" = 400 **PRIOR INSTRUMENT:** ORV 1089/35 & 224/583