
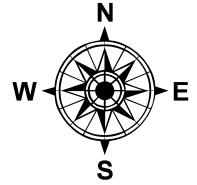


PARENT PARCEL: 06-26-070-000-019

CHILD PARCEL: FRONT & DEPTH TO AC CORR. PER SURVEYOR THOMAS SIMON

23-05088-C

STARTING POINT: IRON PIPE @ INTERSECTION EASTERLY LINE OF WATER ST & NORTHERLY LINE OF W BROAD ST

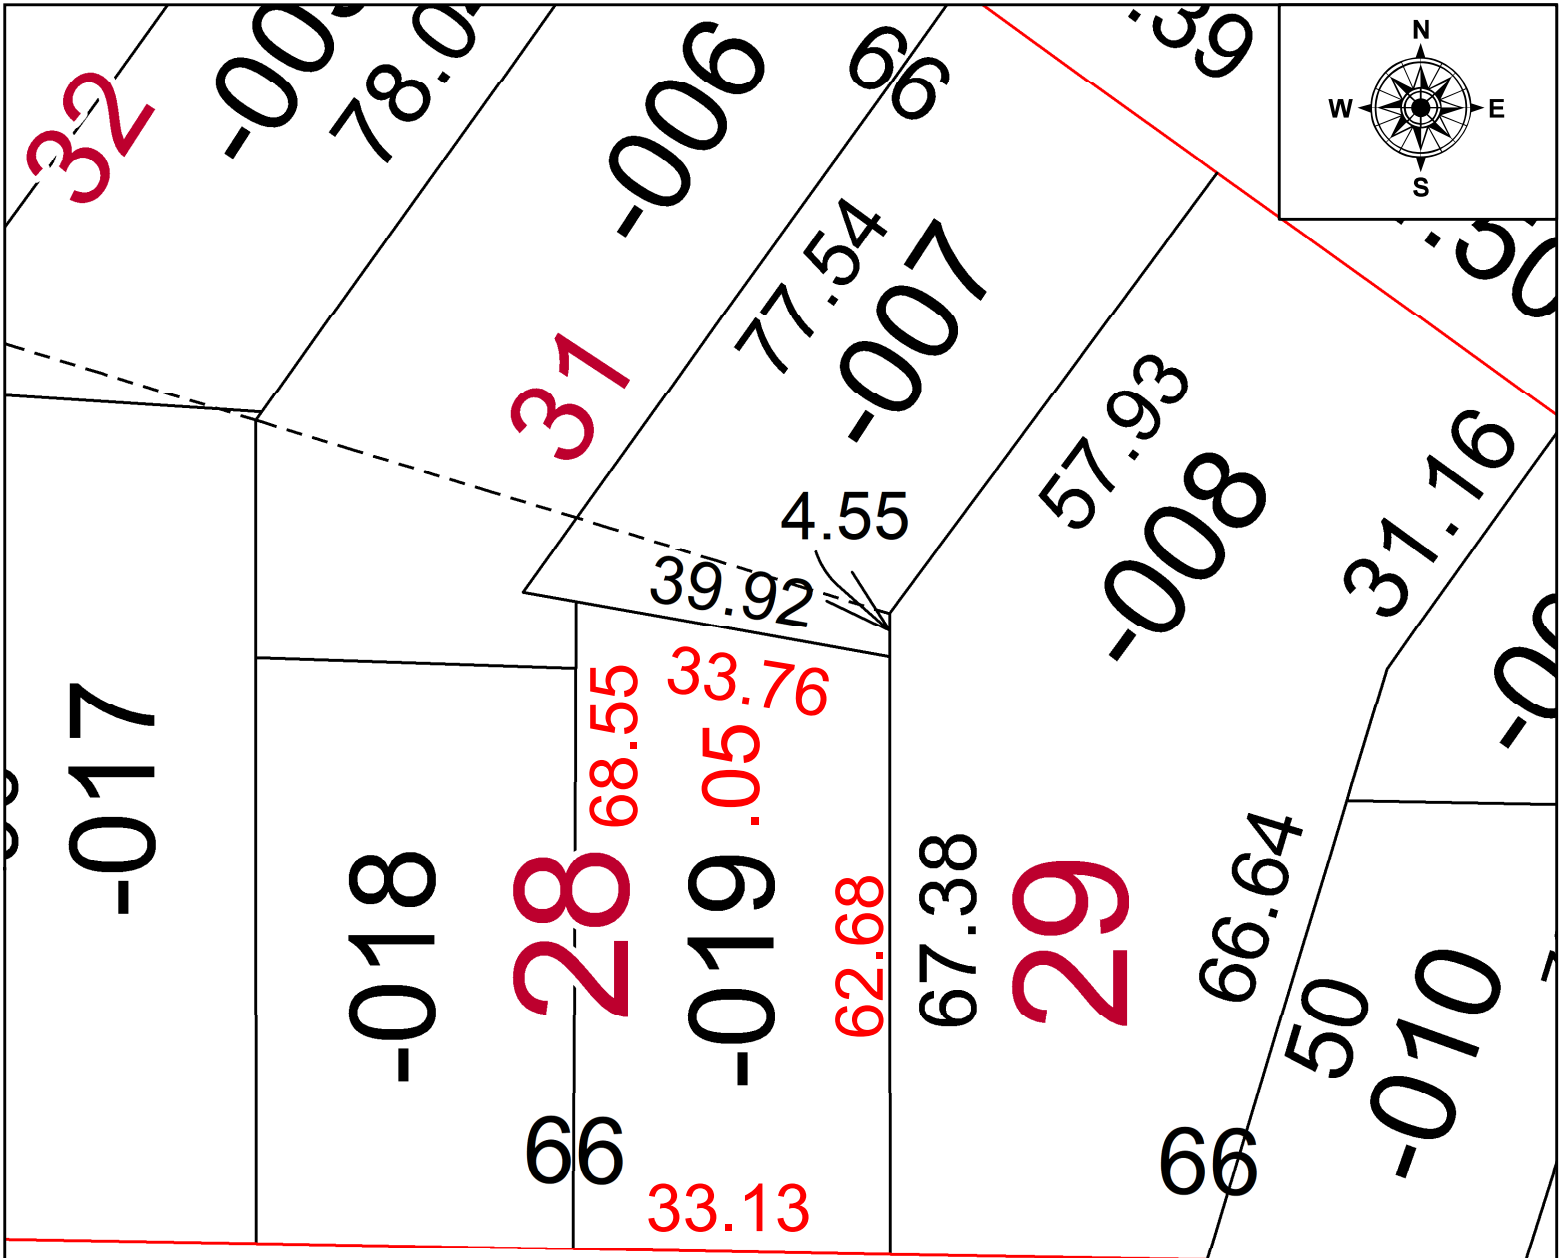


36

33

~~33~~

34.84

33

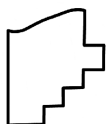

**SPLITS/DEEDS PROCESSED**  
 LORAIN COUNTY TAX MAP DEPARTMENT  
 226 MIDDLE AVE. ELYRIA, OH

SURVEYED BY: THOMAS SIMON SURVEY #: 50902  
 CLOSURE: 1: 64,996  
 MAP PAGE(S): 06-26-070  
 APPROVED BY: SP DATE: 5/25/2023  
 SCALE: 1" = 20' PRIOR INSTRUMENT: 2017-0644659