
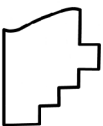


AC CORR PER SURVEYOR AMY KELLY

09-00-001-102-076, 09-00-002-000-058, 09-00-011-000-039, & 09-00-012-000-046

INTERSECTION OF C/L OF QUARRY RD & SOUTH LINE OF O.L. 2

25-05088

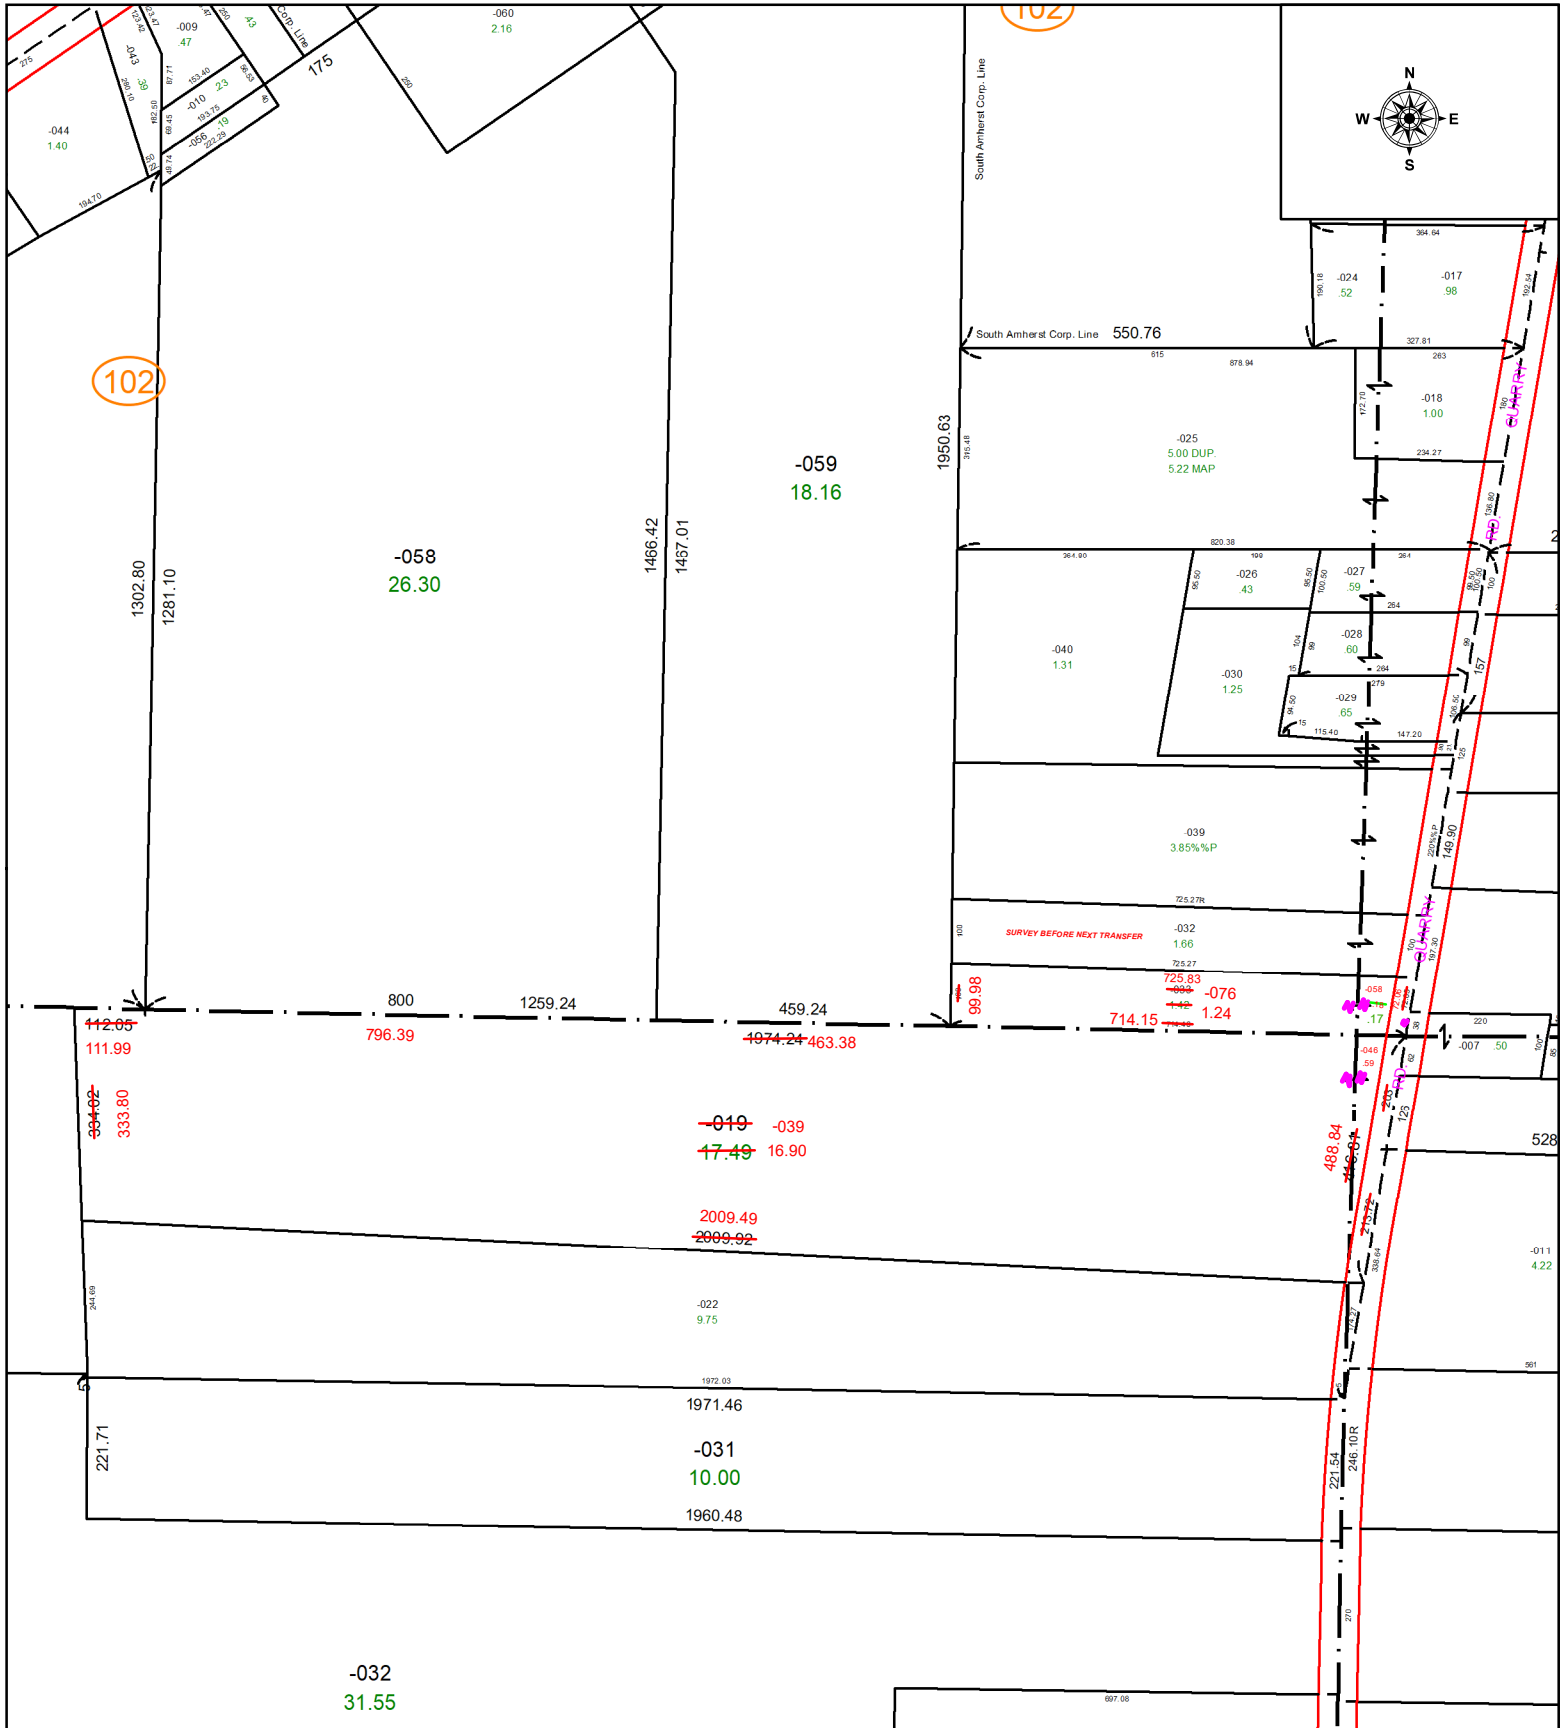

SPLITS/DEEDS PROCESSED
LORAIN COUNTY TAX MAP DEPARTMENT
226 MIDDLE AVE. ELYRIA, OH

SURVEYED BY: _____ AMY KELLY

SURVEY # 51592

CLOSURE: 1: 1165867

MAP PAGE(S): 09-00-001, 09-00-002, 09-00-011, & 09-00-012

APPROVED BY: WRZ **DATE:** 11/13/2025

SCALE: 1" = 300 PRIOR INSTRUMENT: #2013-0458328