
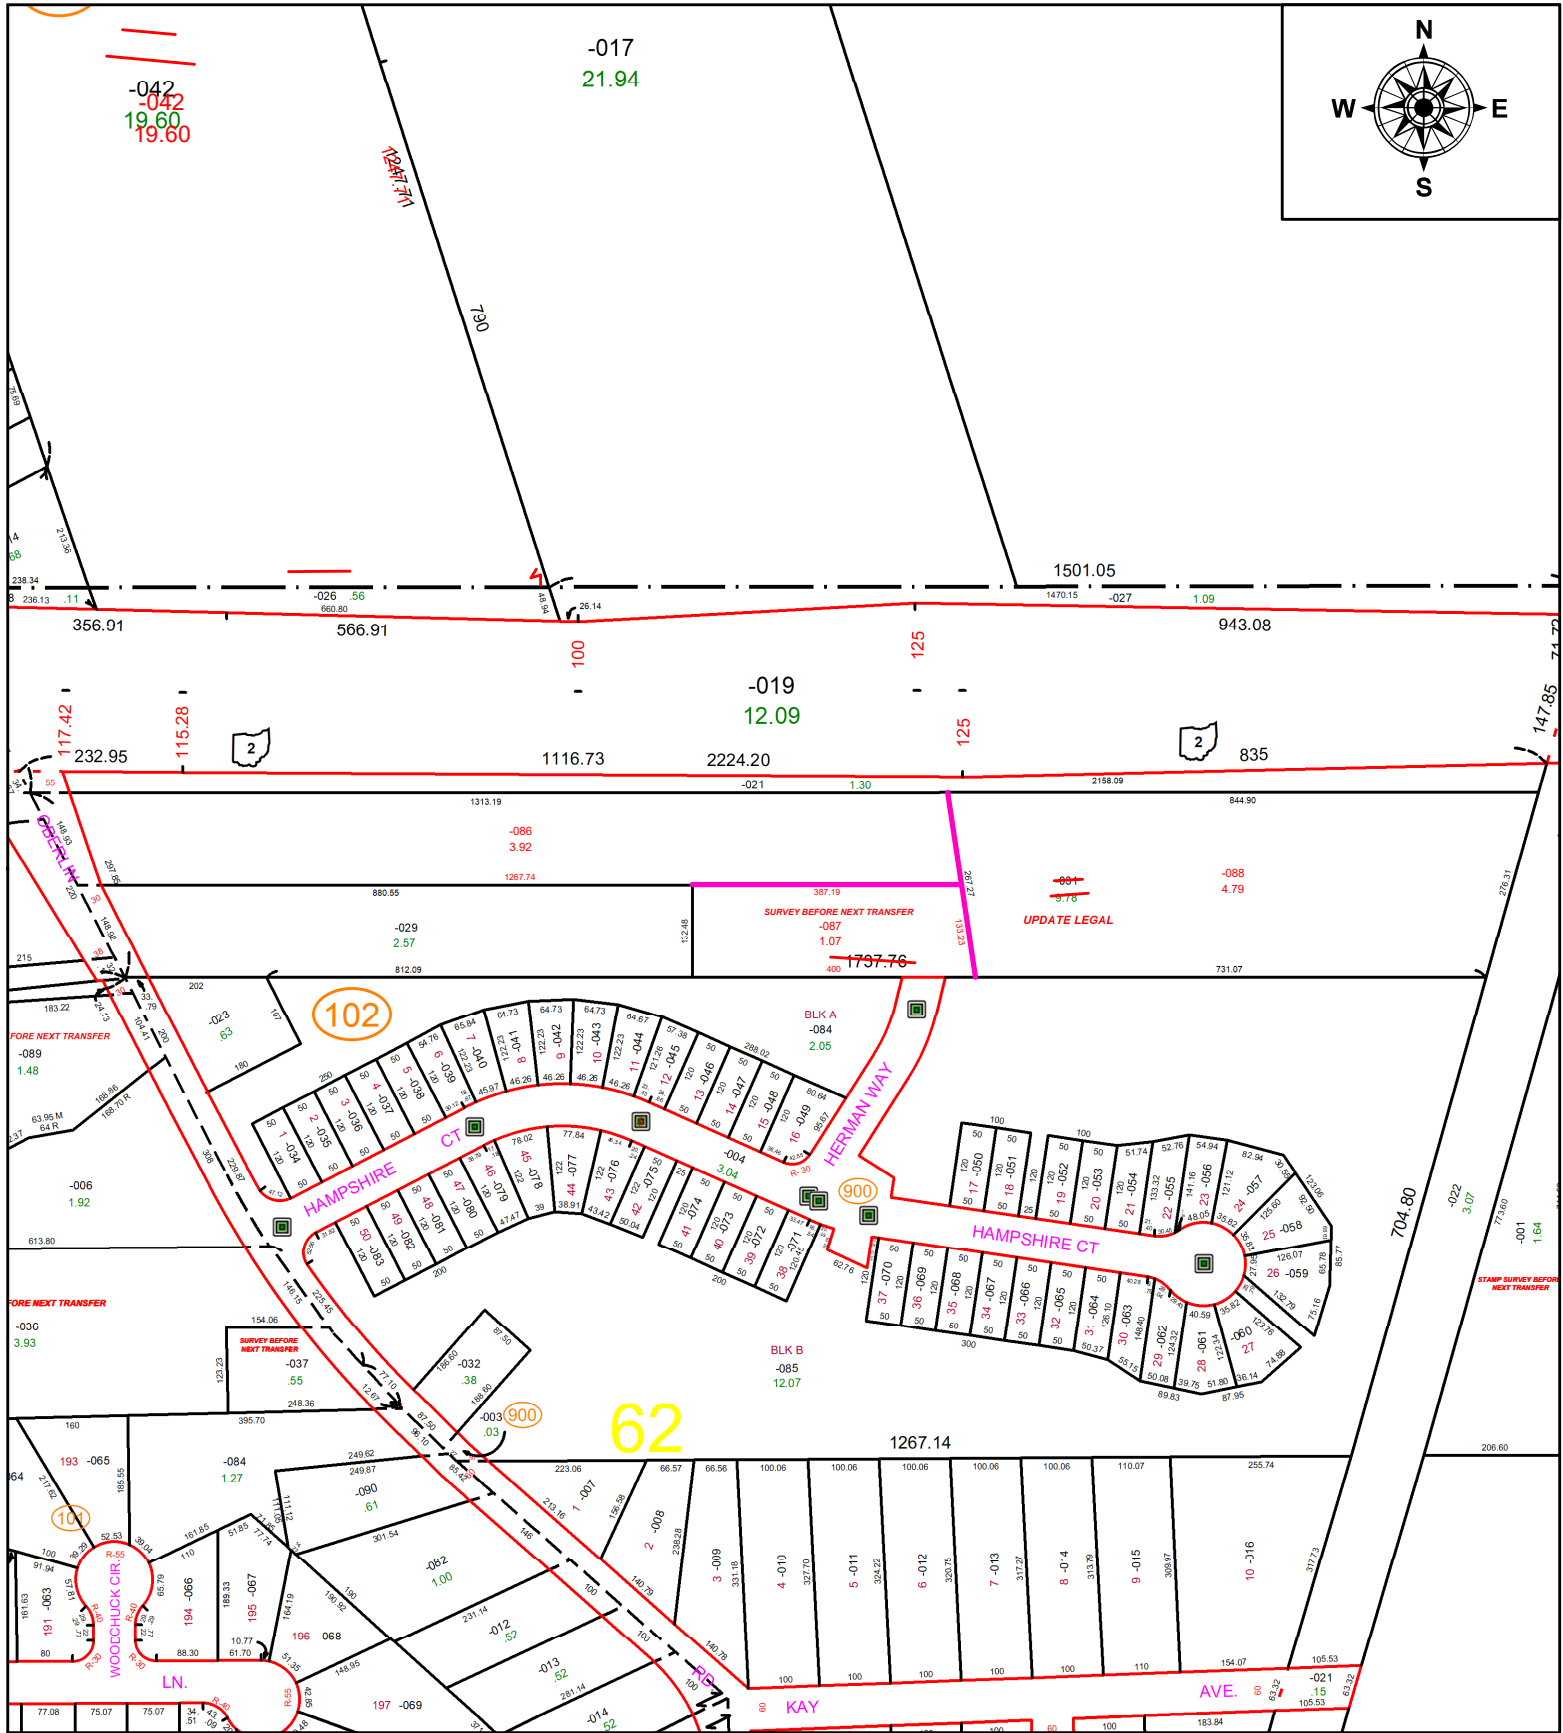


PARENT PARCEL: 05-00-062-102-031

CHILD PARCEL: 05-00-062-102-086 THRU -088

STARTING POINT: N/A

23-05090-U

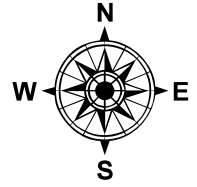

SPLITS/DEEDS PROCESSED

LORAIN COUNTY TAX MAP DEPARTMENT
226 MIDDLE AVE. ELYRIA, OH

SURVEYED BY: N/A SURVEY #: N/A

CLOSURE: N/A

MAP PAGE(S): 05-00-062

APPROVED BY: DMA DATE: 5/26/2023

SCALE: 1" = 275' PRIOR INSTRUMENT: 2018-0657692