
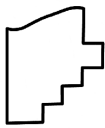


PARENT PARCEL: 01-00-043-000-083, -085, & -086

CHILD PARCEL: 01-00-043-000-087 THRU -089

STARTING POINT: C/L OF BAUMHART RD AND SE CORNER OF O/L 43

25-05091

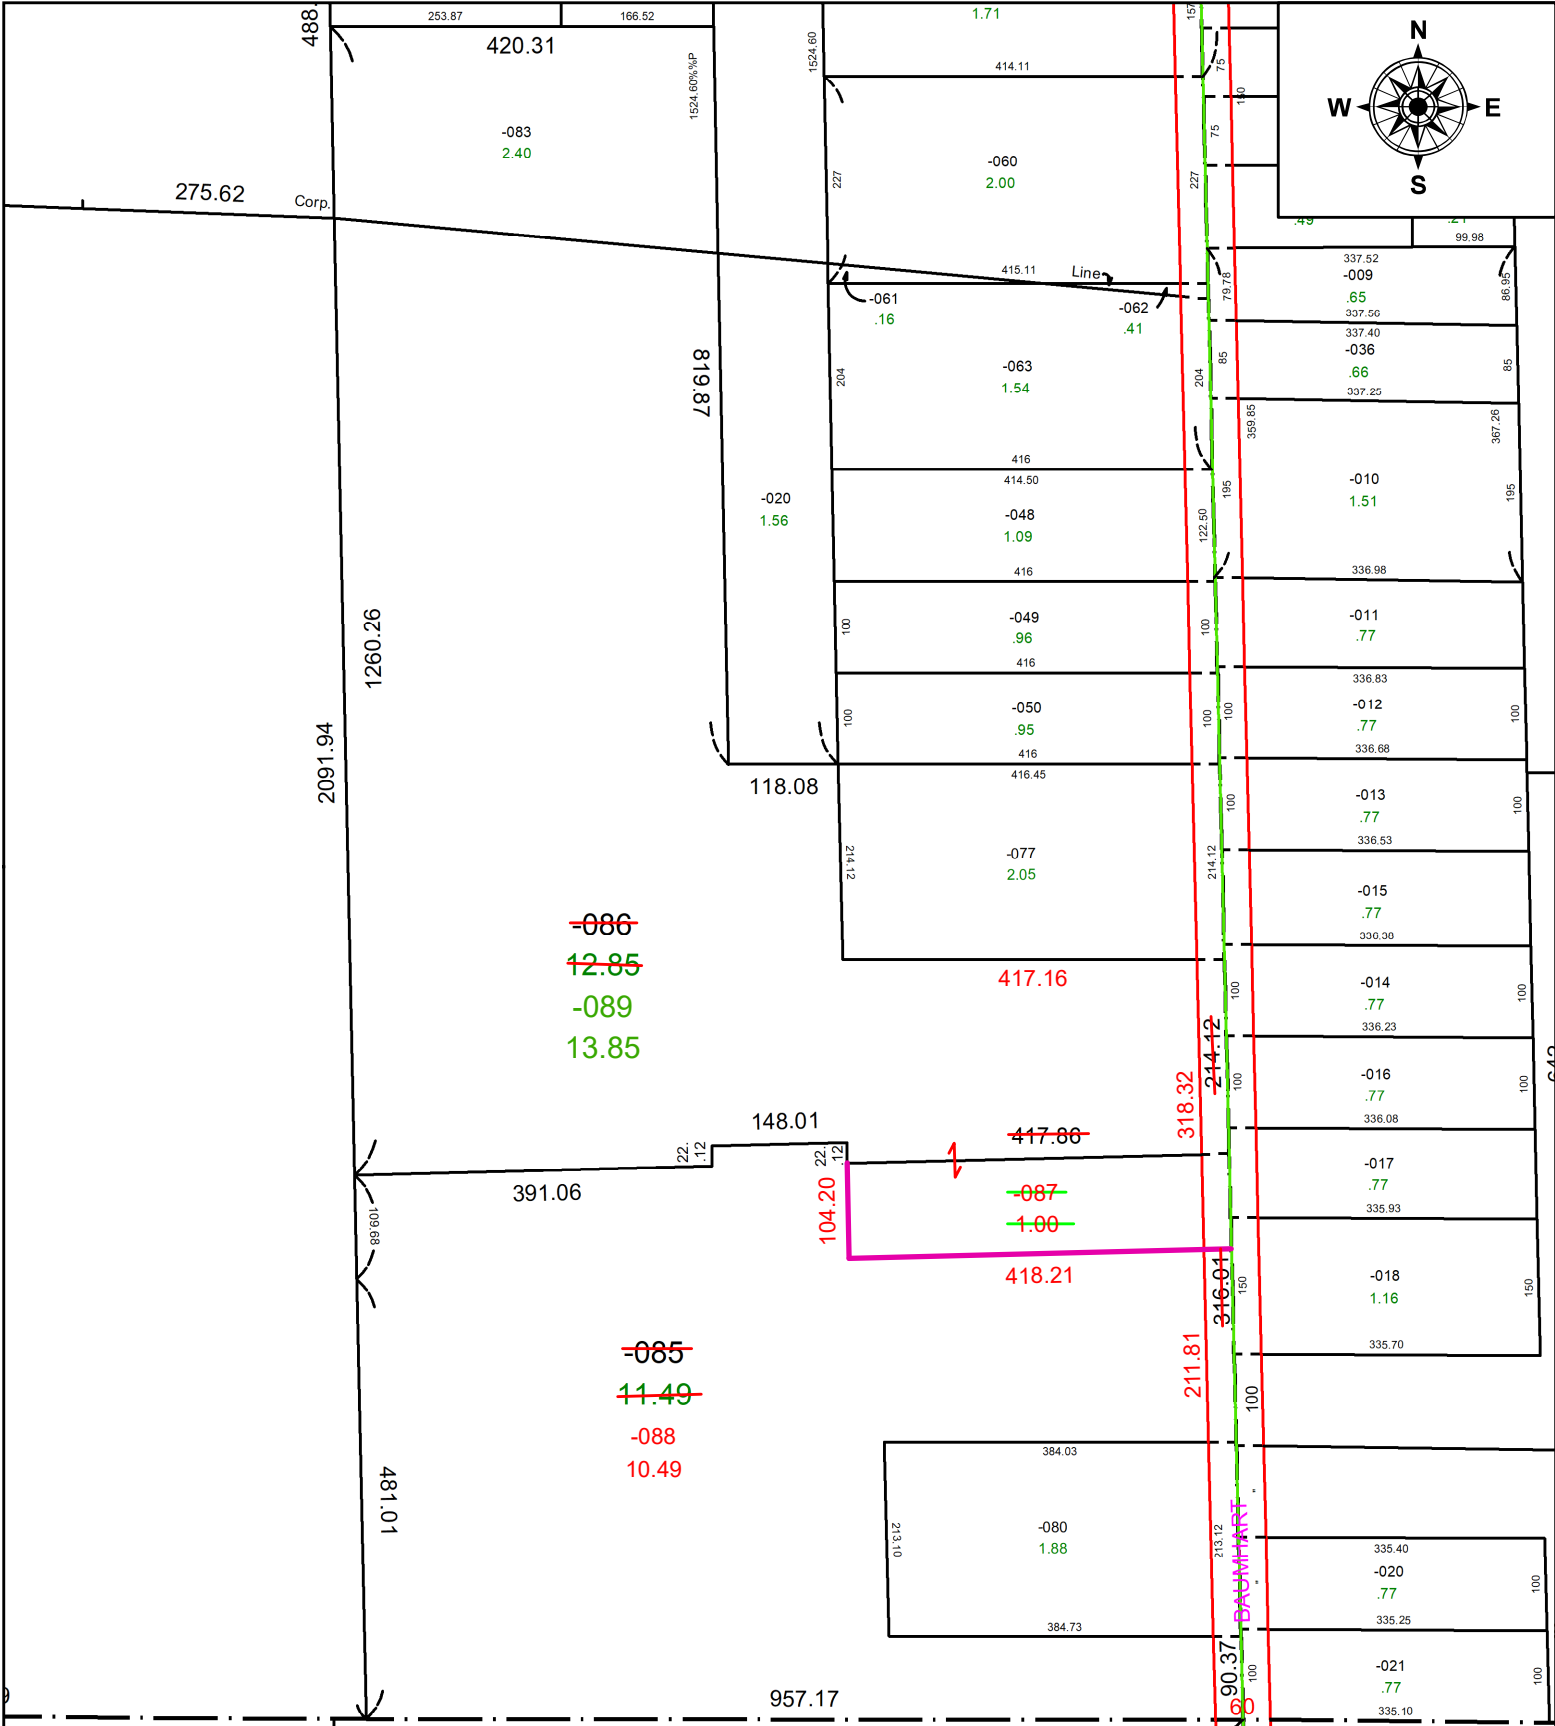

SPLITS/DEEDS PROCESSED
LORAIN COUNTY TAX MAP DEPARTMENT
226 MIDDLE AVE. ELYRIA, OH

SURVEYED BY: TIMOTHY D. HOZALSKI **SURV # 51596**
CLOSURE: 1: 172725
MAP PAGE(S): 01-00-043
APPROVED BY: AC **DATE:** November 17, 2025
SCALE: 1 in = 210 ft **PRIOR INSTRUMENT:** 2025- 0051623