
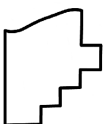
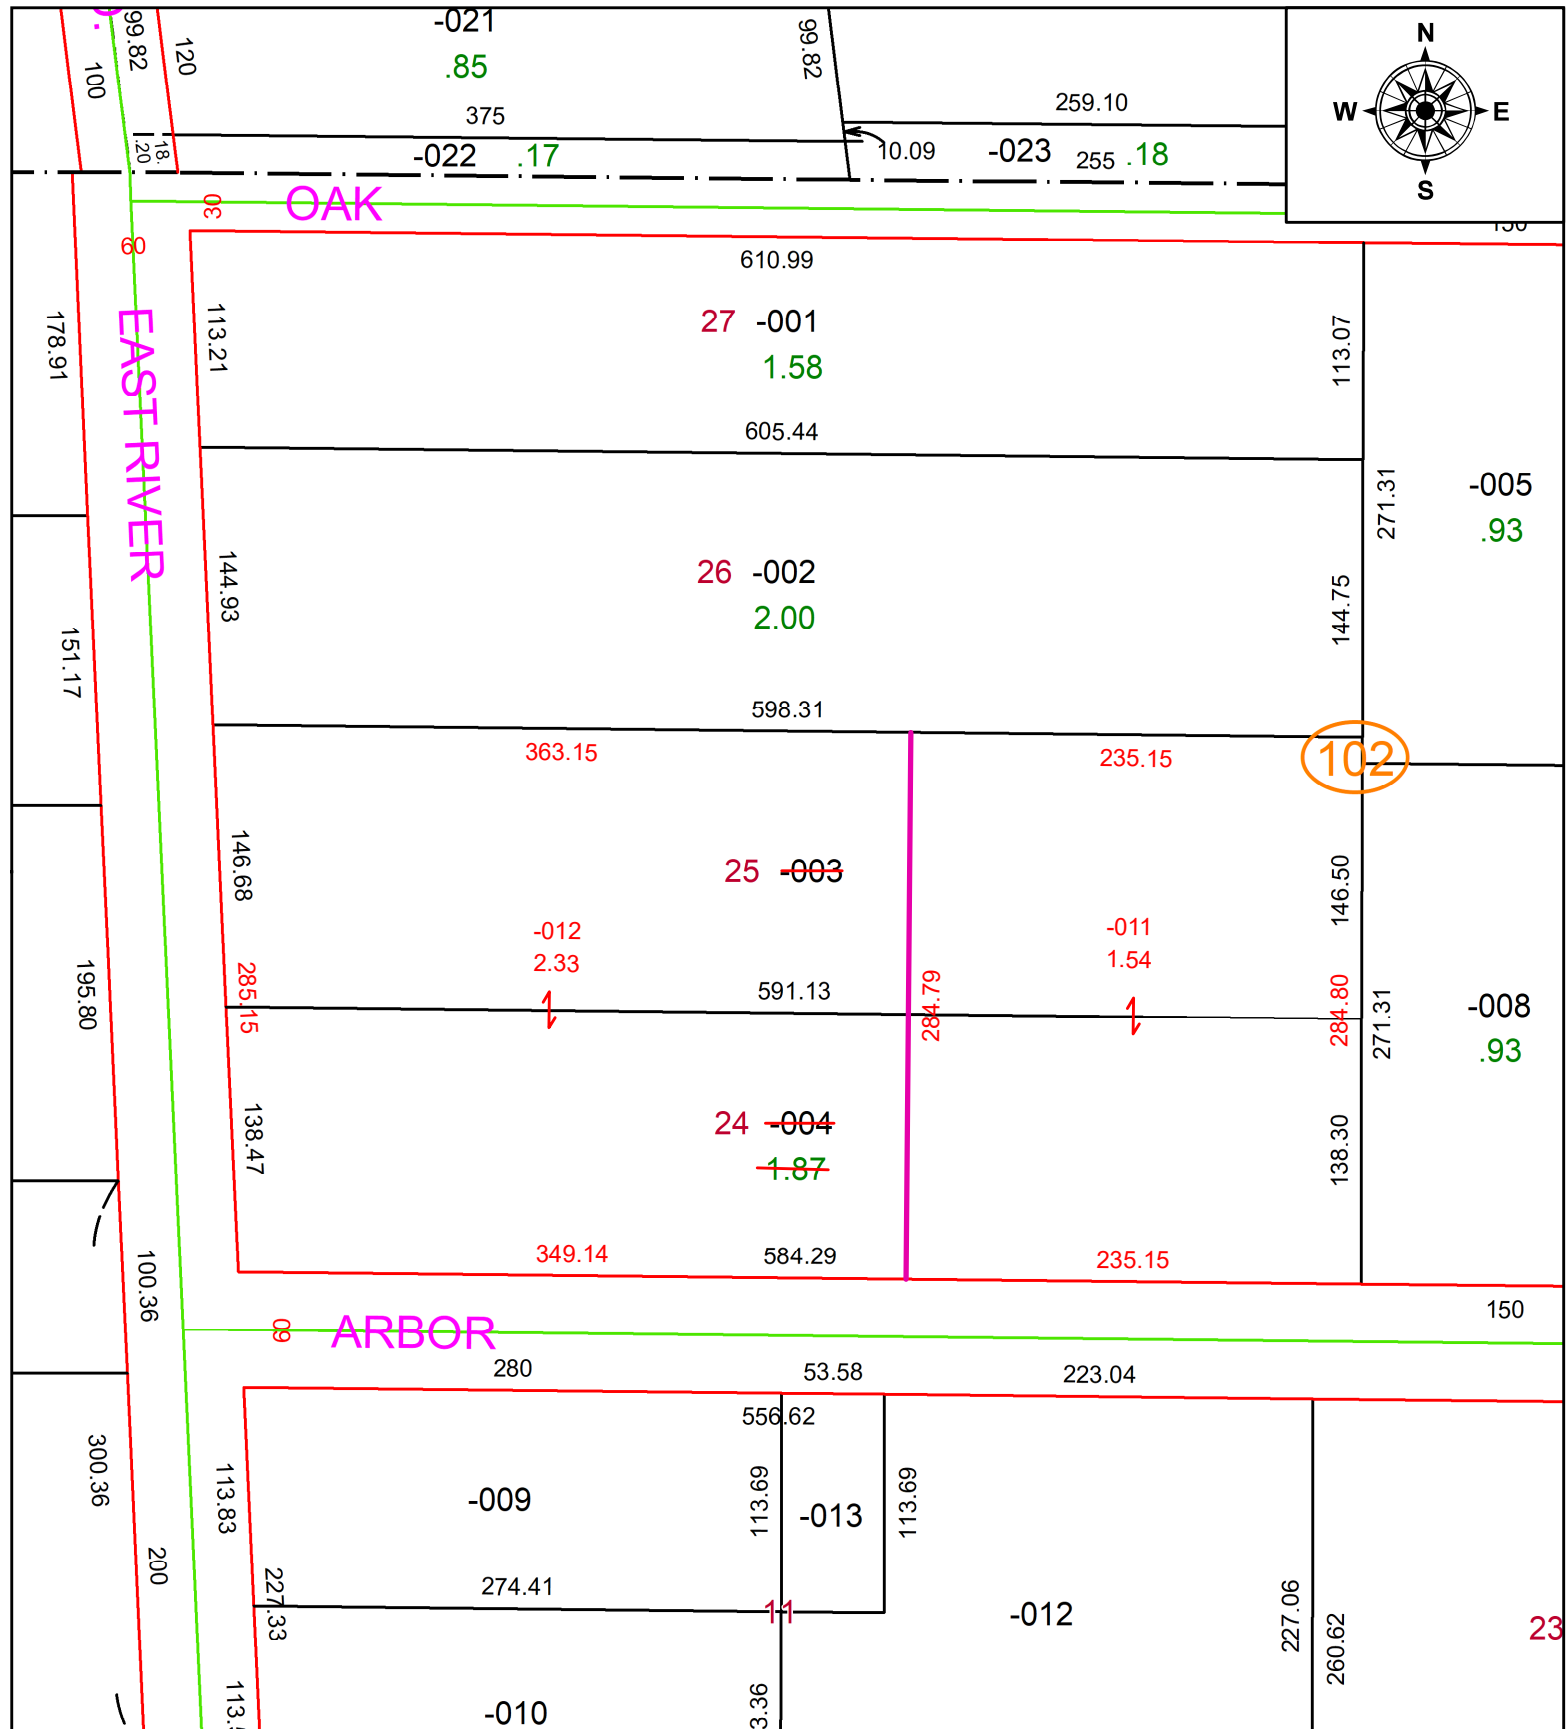


25-05092

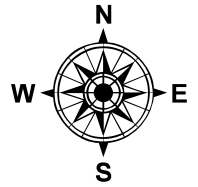

SPLITS/DEEDS PROCESSED

LORAIN COUNTY TAX MAP DEPARTMENT
226 MIDDLE AVE. ELYRIA, OH

SURVEYED BY: JAMES D. WELLERT **SURV # 51598**

CLOSURE: 1: 3979152

MAP PAGE(S): 03-00-071

APPROVED BY: AC **DATE:** November 18, 2025

SCALE: 1 in = 100 ft **PRIOR INSTRUMENT:** 2022-0873205