
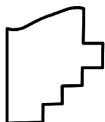
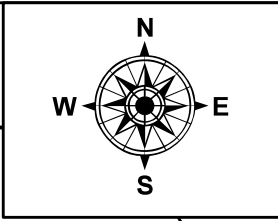


PARENT PARCEL: 01-00-064-000-045, & -044

CHILD PARCEL: 01-00-064-000-089

STARTING POINT: NE CORNER OF O/L NO. 64

23-05093-C

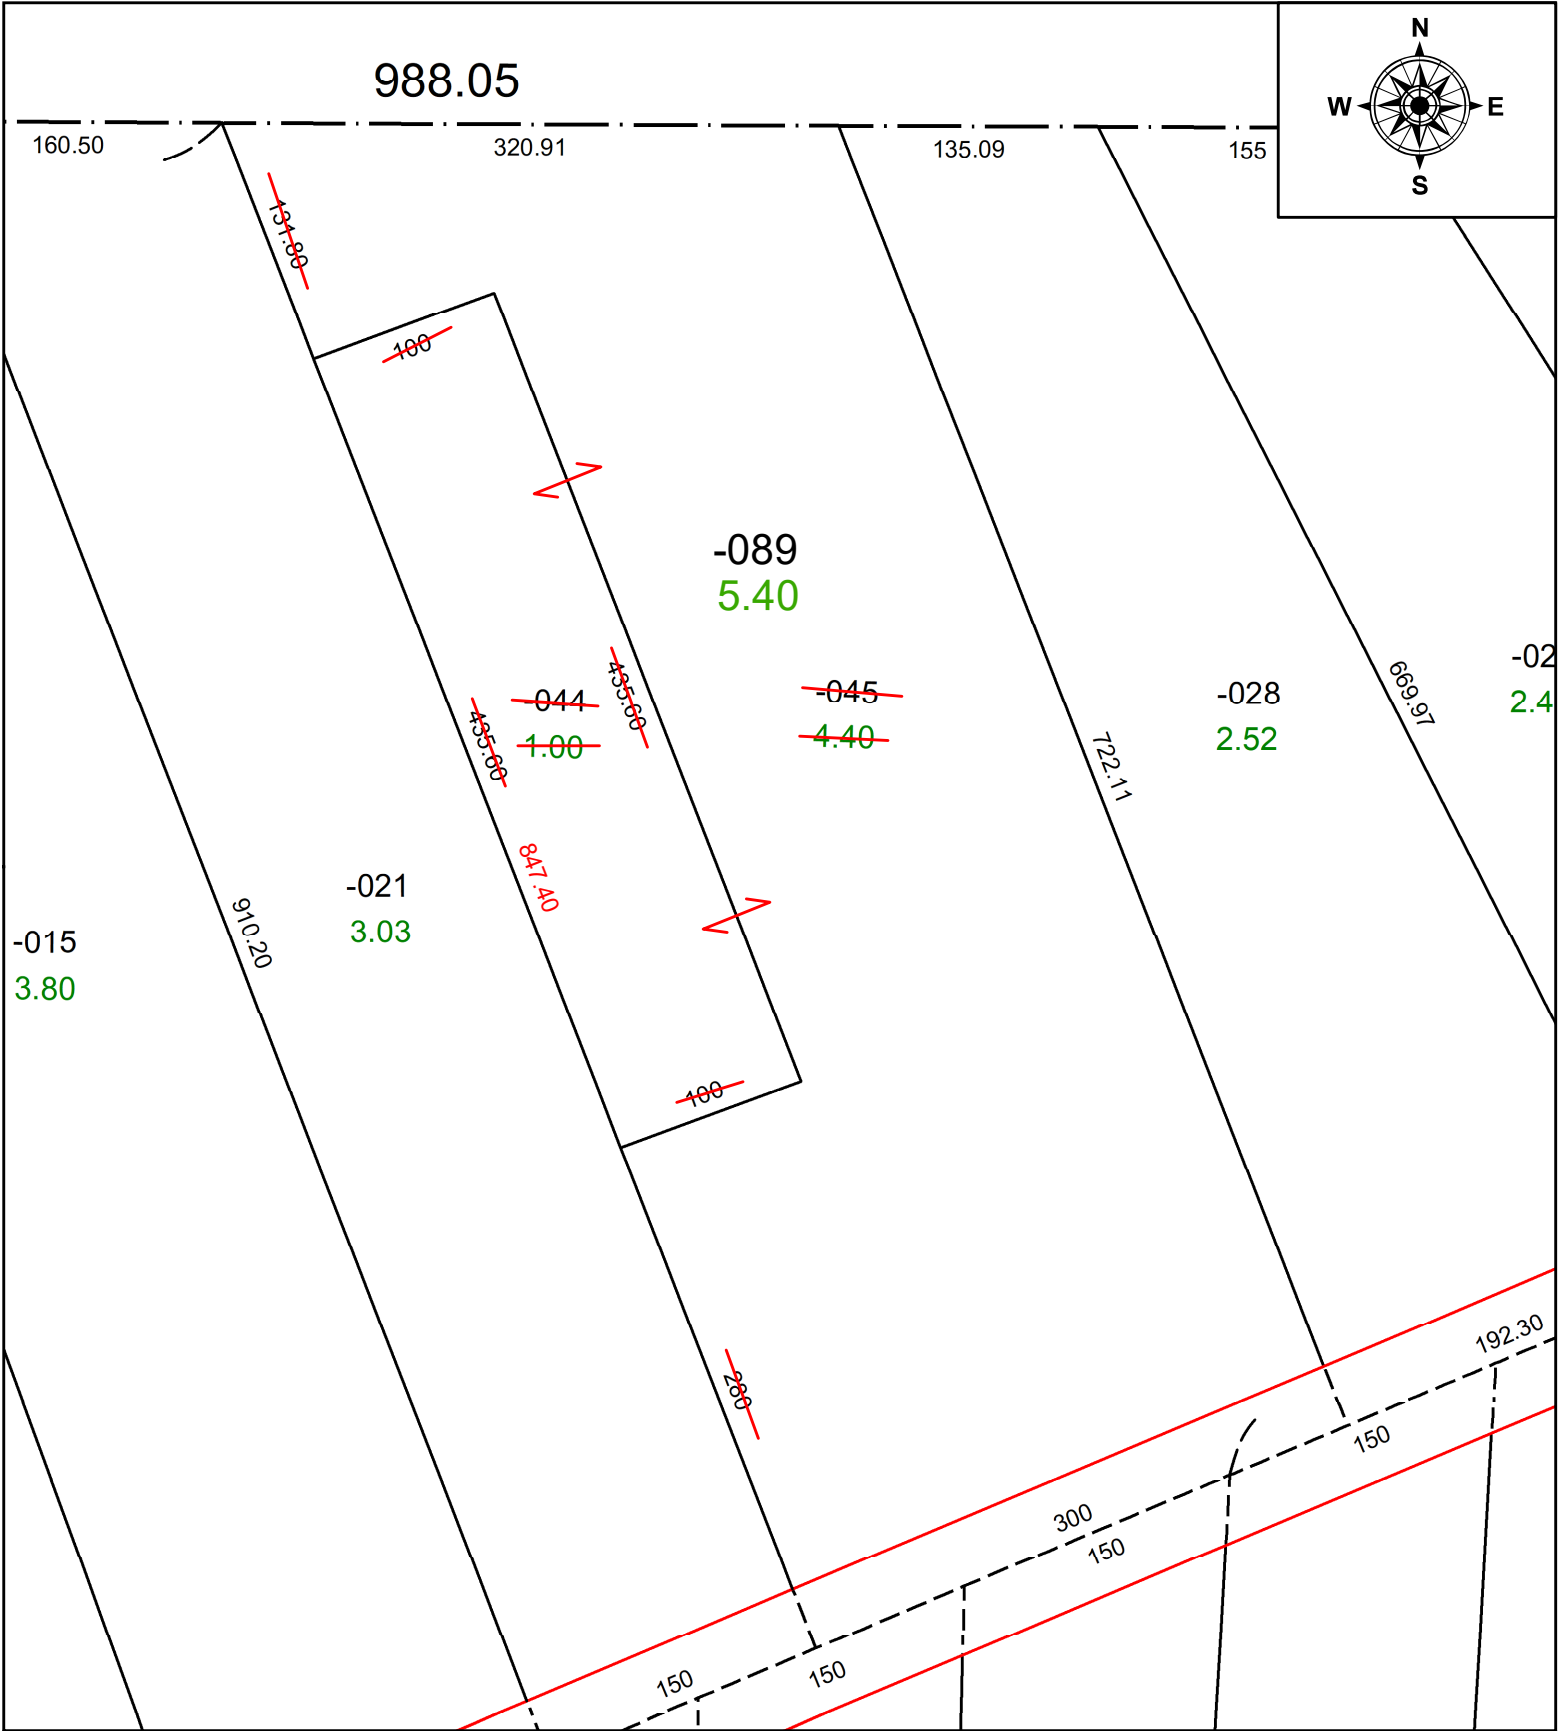

SPLITS/DEEDS PROCESSED
 LORAIN COUNTY TAX MAP DEPARTMENT
 226 MIDDLE AVE. ELYRIA, OH

SURVEYED BY: Ray E Hollis **SURVEY #:** N/A
CLOSURE: 1: 7600
MAP PAGE(S): 01-00-064
APPROVED BY: SP **DATE:** 6/5/2023
SCALE: 1" = 100' **PRIOR INSTRUMENT:** 2023-0916868