
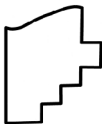
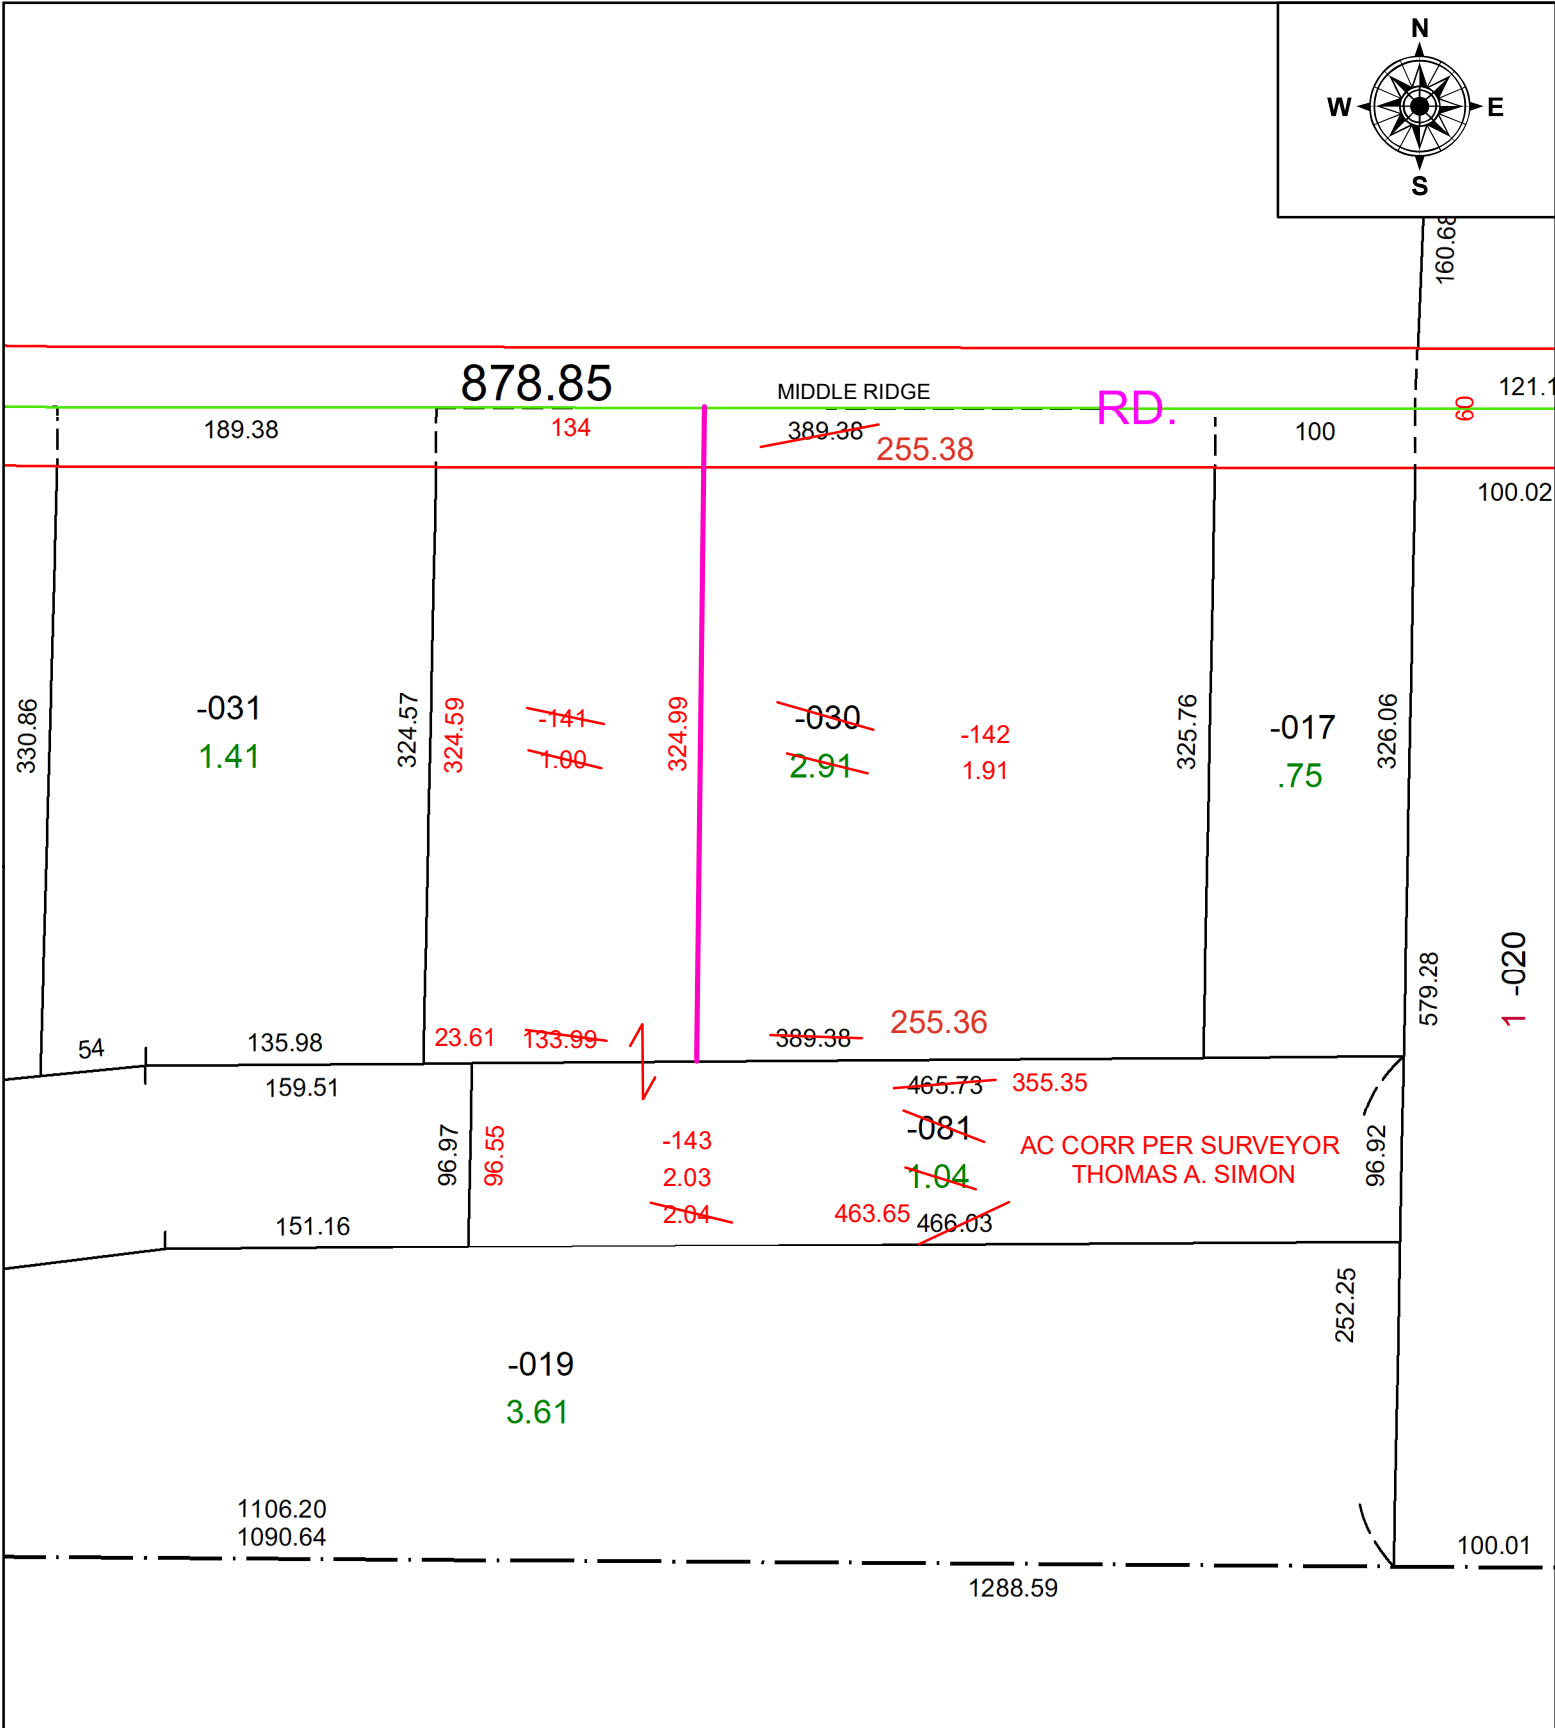


PARENT PARCEL: 05-00-015-000-030 & -081
CHILD PARCEL: 05-00-015-000-141 & -142 & -143
STARTING POINT: INTERSECTION OF C/L PYLE-SOUTH AMHERST RD AND MIDDLE RIDGE RD

25-05093

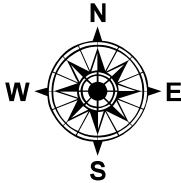

SPLITS/DEEDS PROCESSED
LORAIN COUNTY TAX MAP DEPARTMENT
226 MIDDLE AVE. ELYRIA, OH

SURVEYED BY: THOMAS A. SIMON **SURVEY #:** 51599
CLOSURE: 1: 18992
MAP PAGE(S): 05-00-015
APPROVED BY: BB **DATE:** 11/19/2025
SCALE: 1" = 60' **PRIOR INSTRUMENT:** #20200747842