


PARENT PARCEL: 03-00-079-103-030

CHILD PARCEL: 03-00-079-103-031, -032

STARTING POINT: UNCOMBINATION PER PRIOR INSTRU. #2021-0843609

23-05094-C

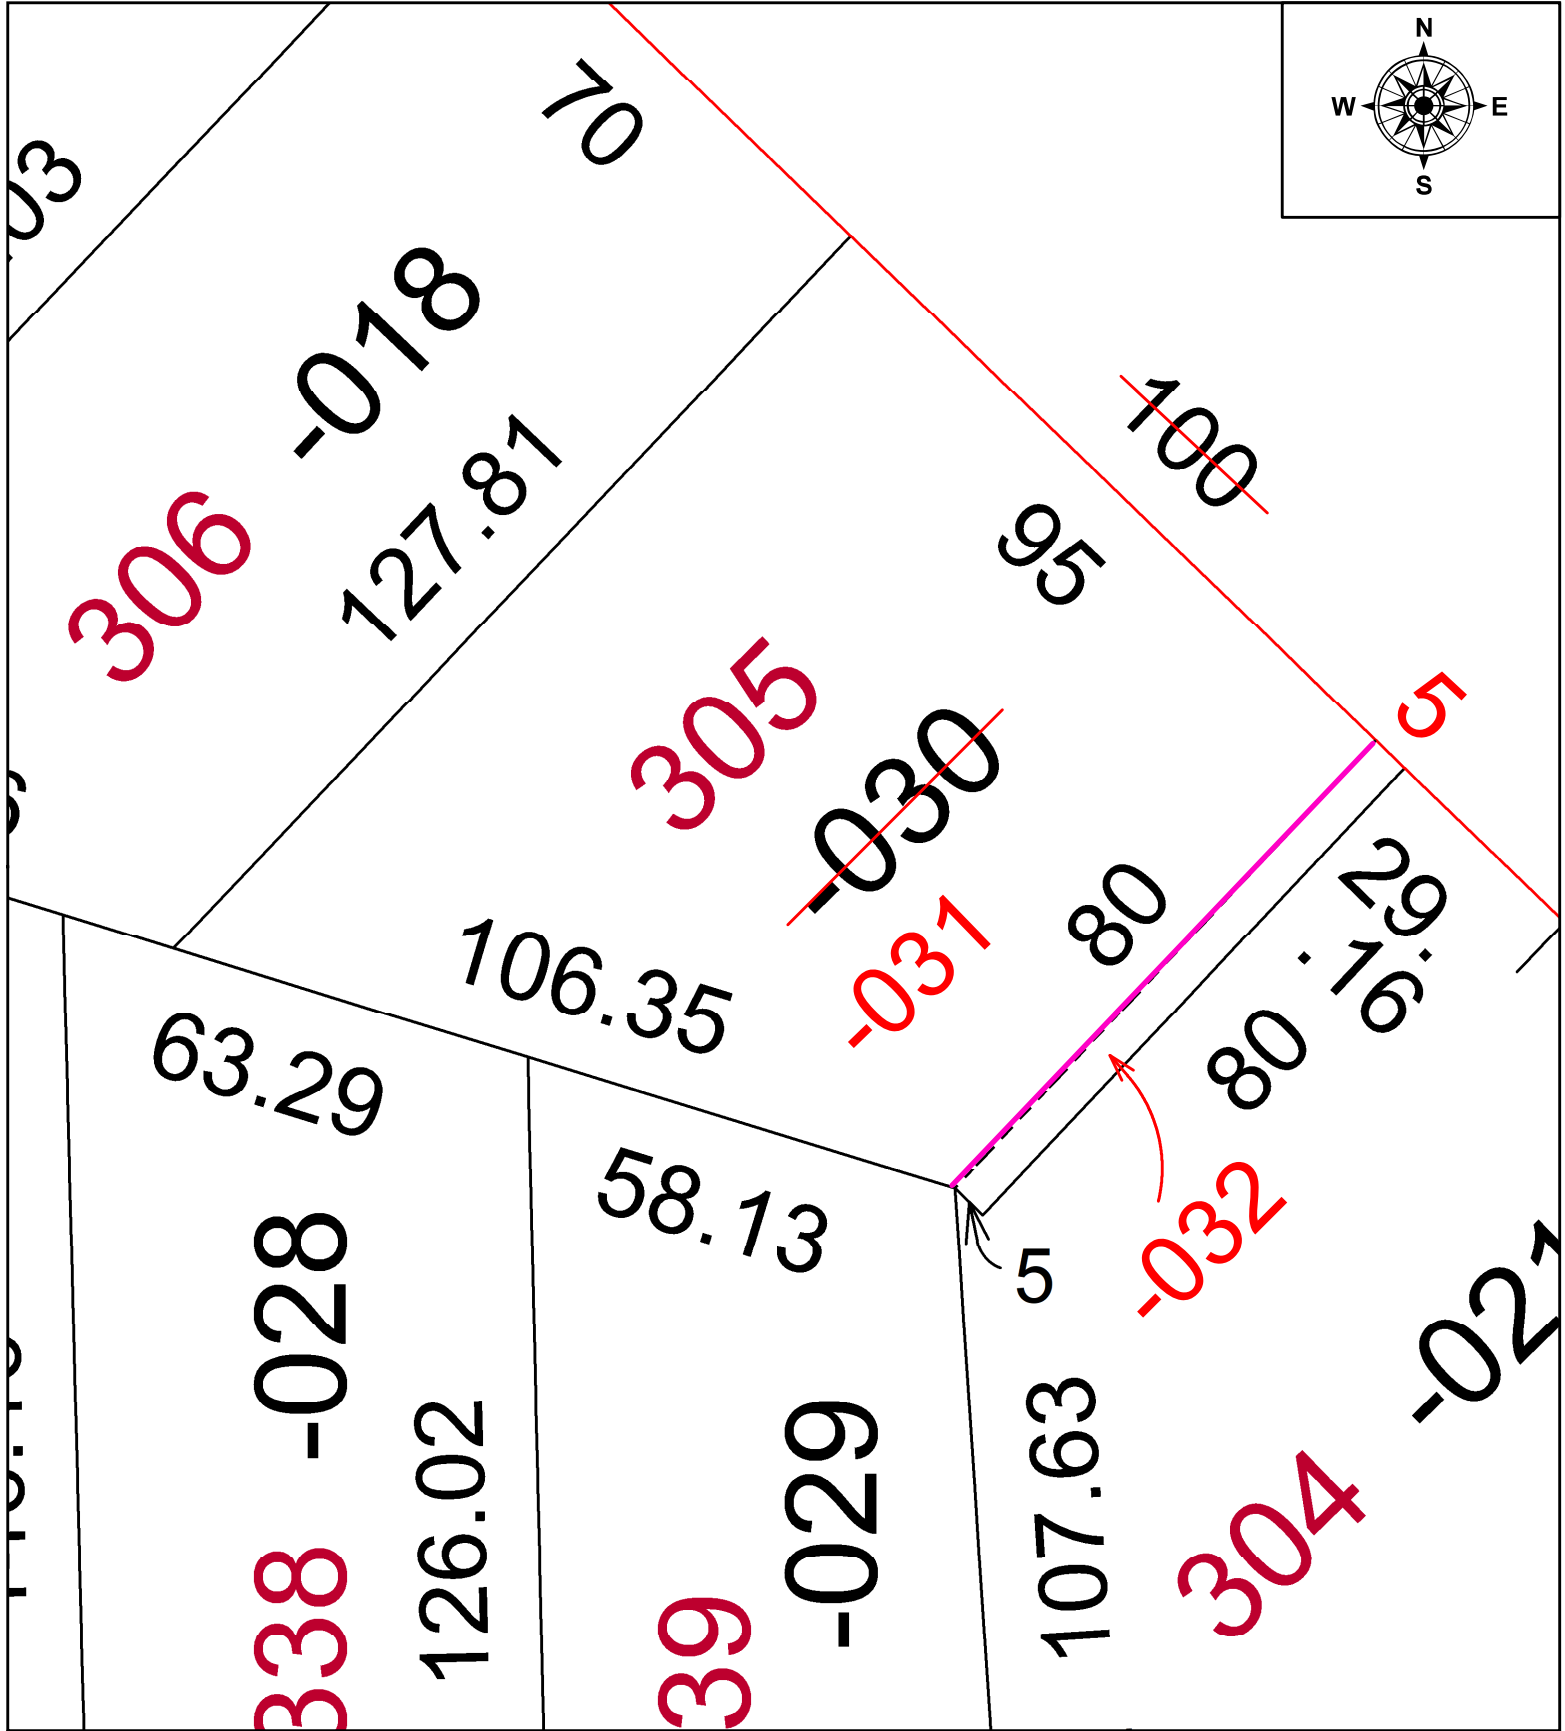

SPLITS/DEEDS PROCESSED
 LORAIN COUNTY TAX MAP DEPARTMENT
 226 MIDDLE AVE. ELYRIA, OH

SURVEYED BY:	N/A	SURVEY #:	N/A
CLOSURE:	1: N/A		
MAP PAGE(S):	03-00-079		
APPROVED BY:	SP	DATE:	6/6/2023
SCALE:	1" = 25'	PRIOR INSTRUMENT:	2021-0843609