



10-00-005-102-010 & -015

10-00-005-102-514 & 11-00-091-000-018 (S.T.)

AC CORR PER SURVEYOR AMY KELLY

INTERSECTION OF EASTERLY LINE OF O.S. CARLISLE TWP & EATON TWP O.L. 92

25-05097

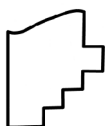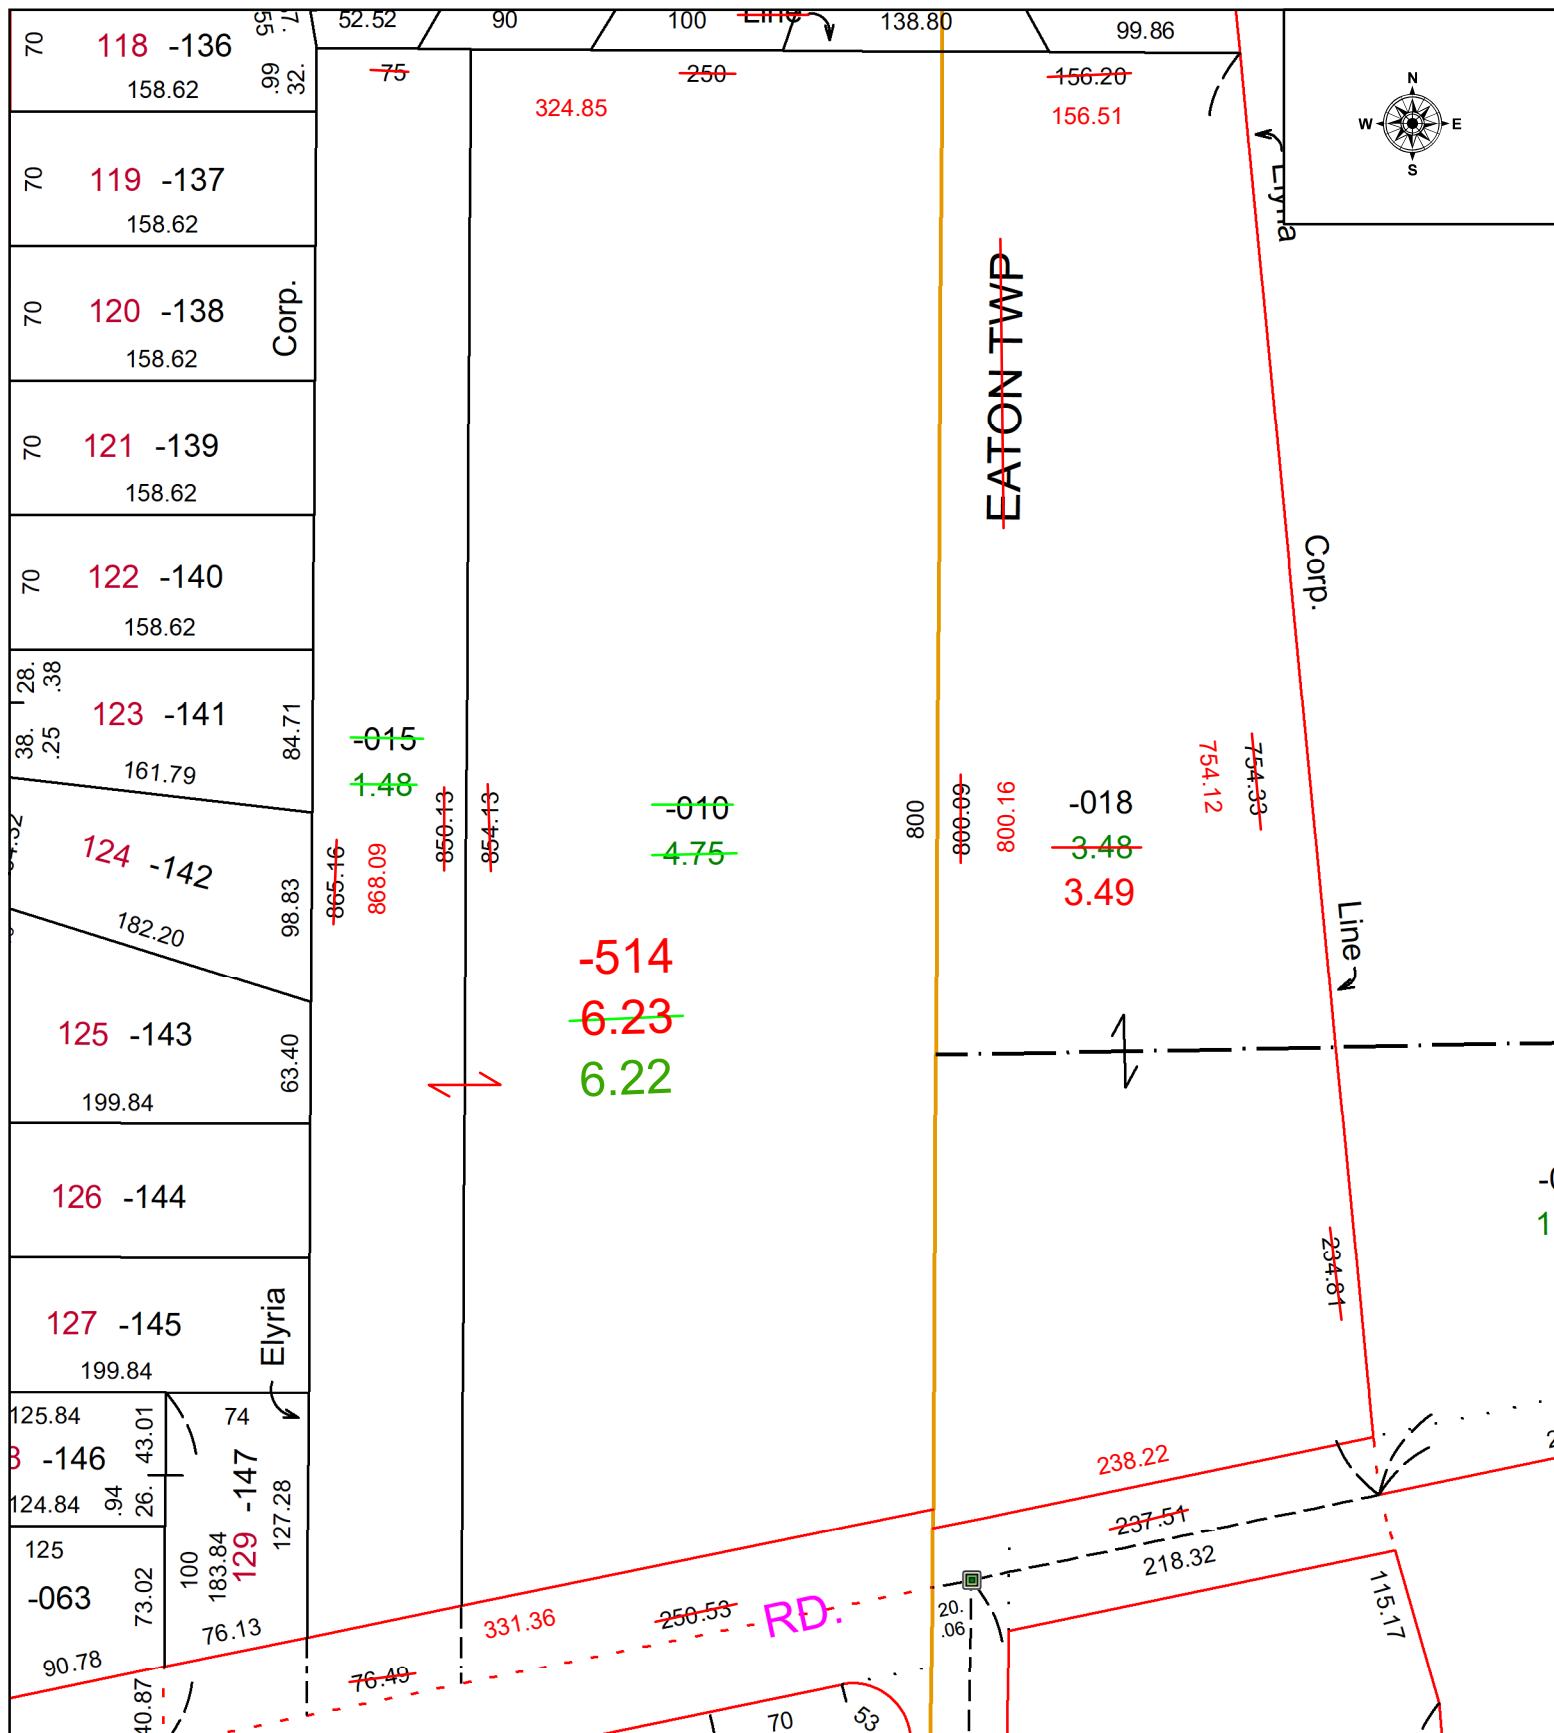

SPLITS/DEEDS PROCESSED

LORAIN COUNTY TAX MAP DEPARTMENT
226 MIDDLE AVE. ELYRIA, OH

AMY KELLY

SURVEY # 51604

1: 247695

10-00-005 & 11-00-091

DATE: 11/21/2025

$$1'' = \overline{100}$$

PRIOR INSTRUMENT: DV 842/83