
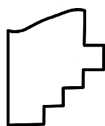
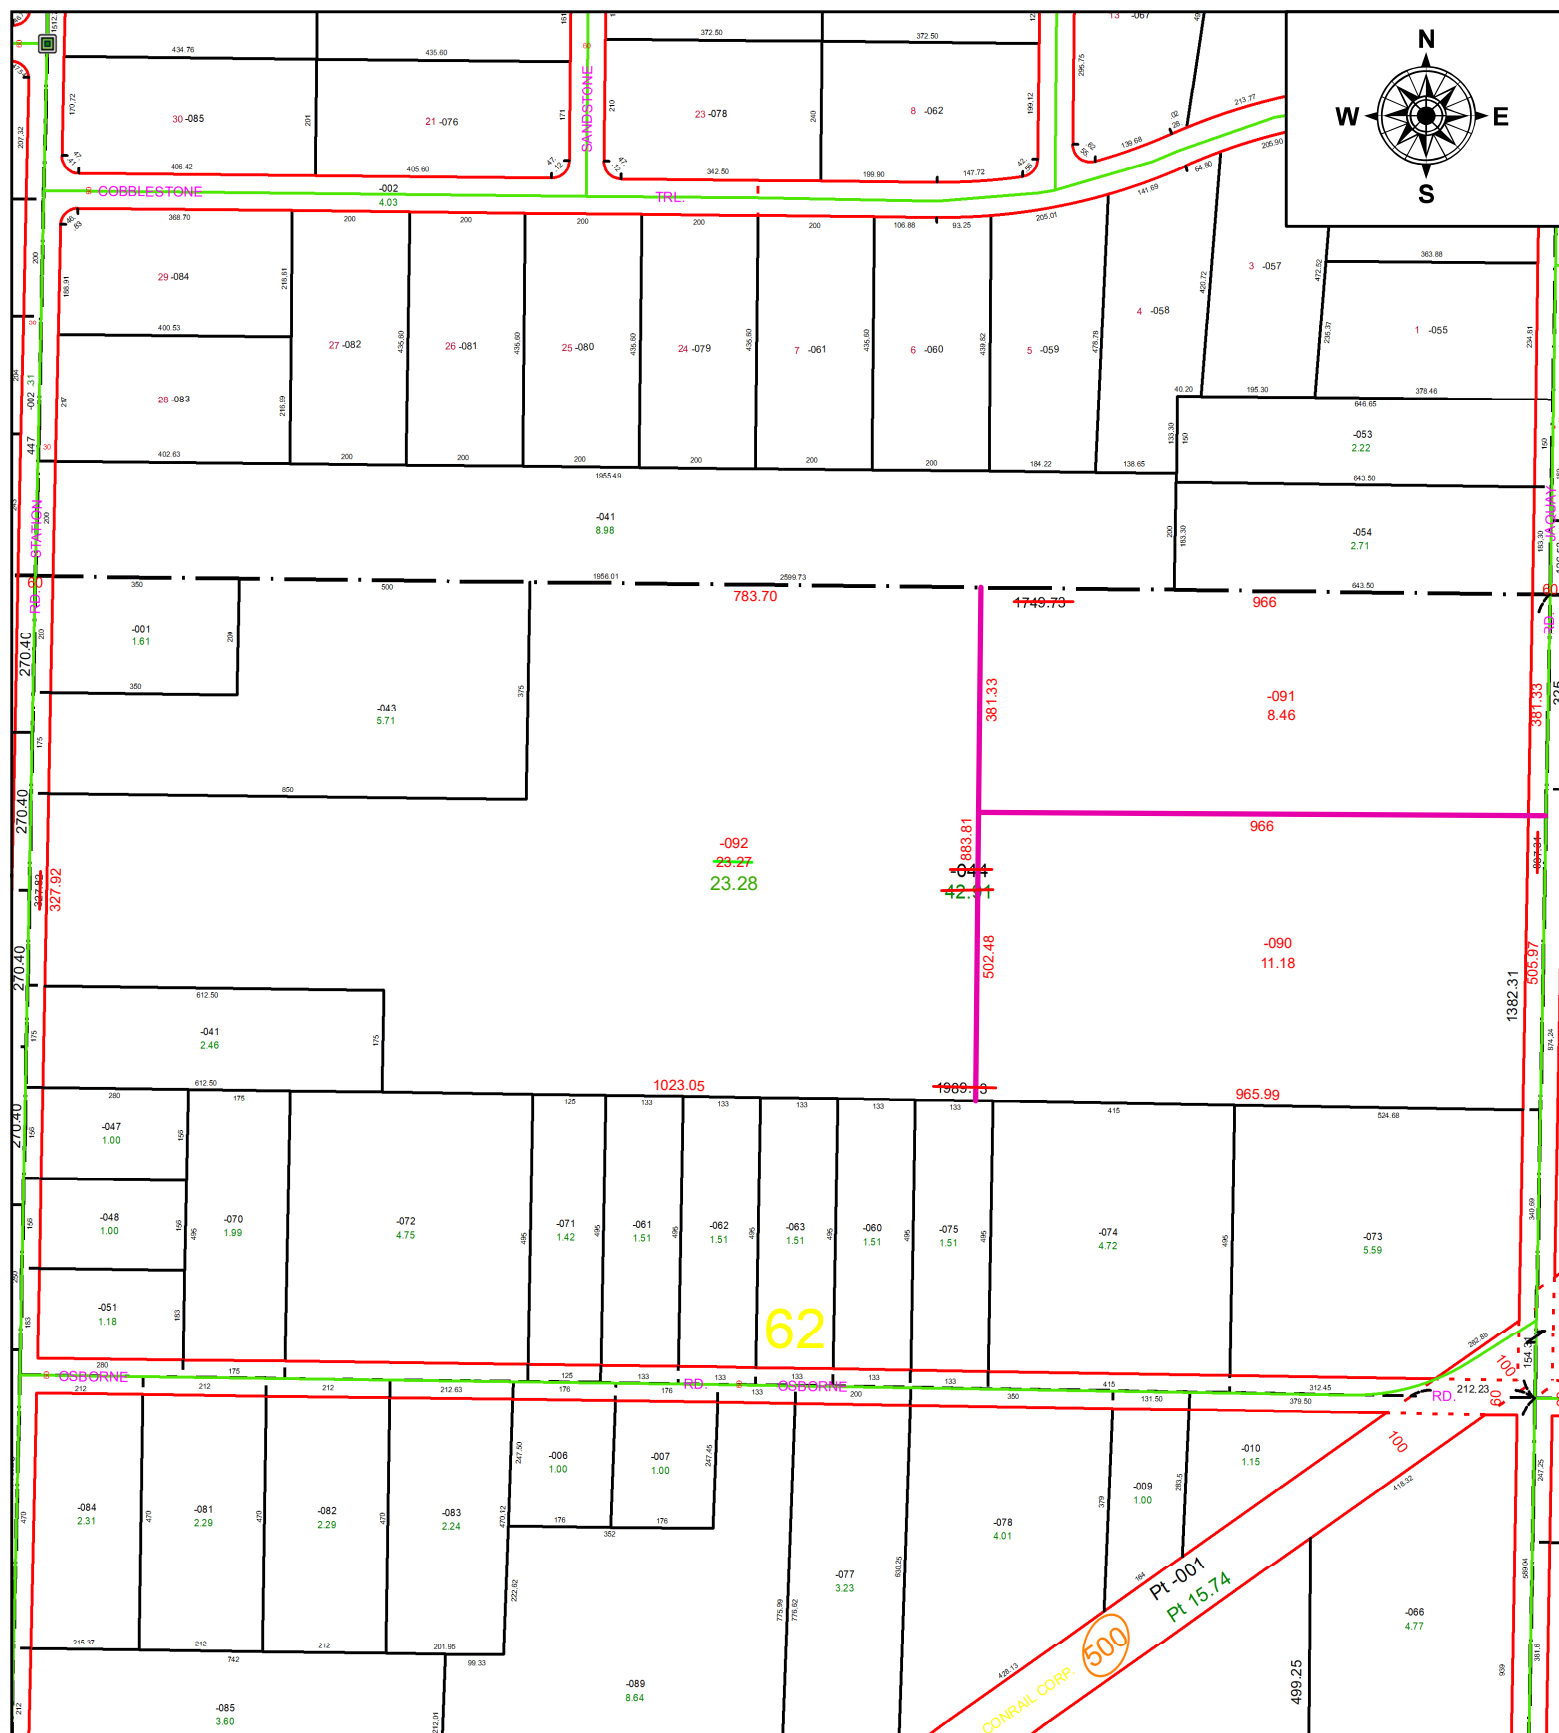


25-05098

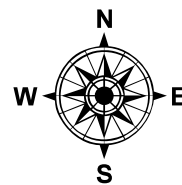

LORAIN COUNTY TAX MAP DEPARTMENT
226 MIDDLE AVE. ELYRIA, OH

SCALE: 1 in = 330 ft **PRIOR INSTRUMENT:** 2025- 0054931