
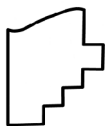


PARENT PARCEL:

05-00-016-102-040 & -041

25-05101

STARTING POINT:

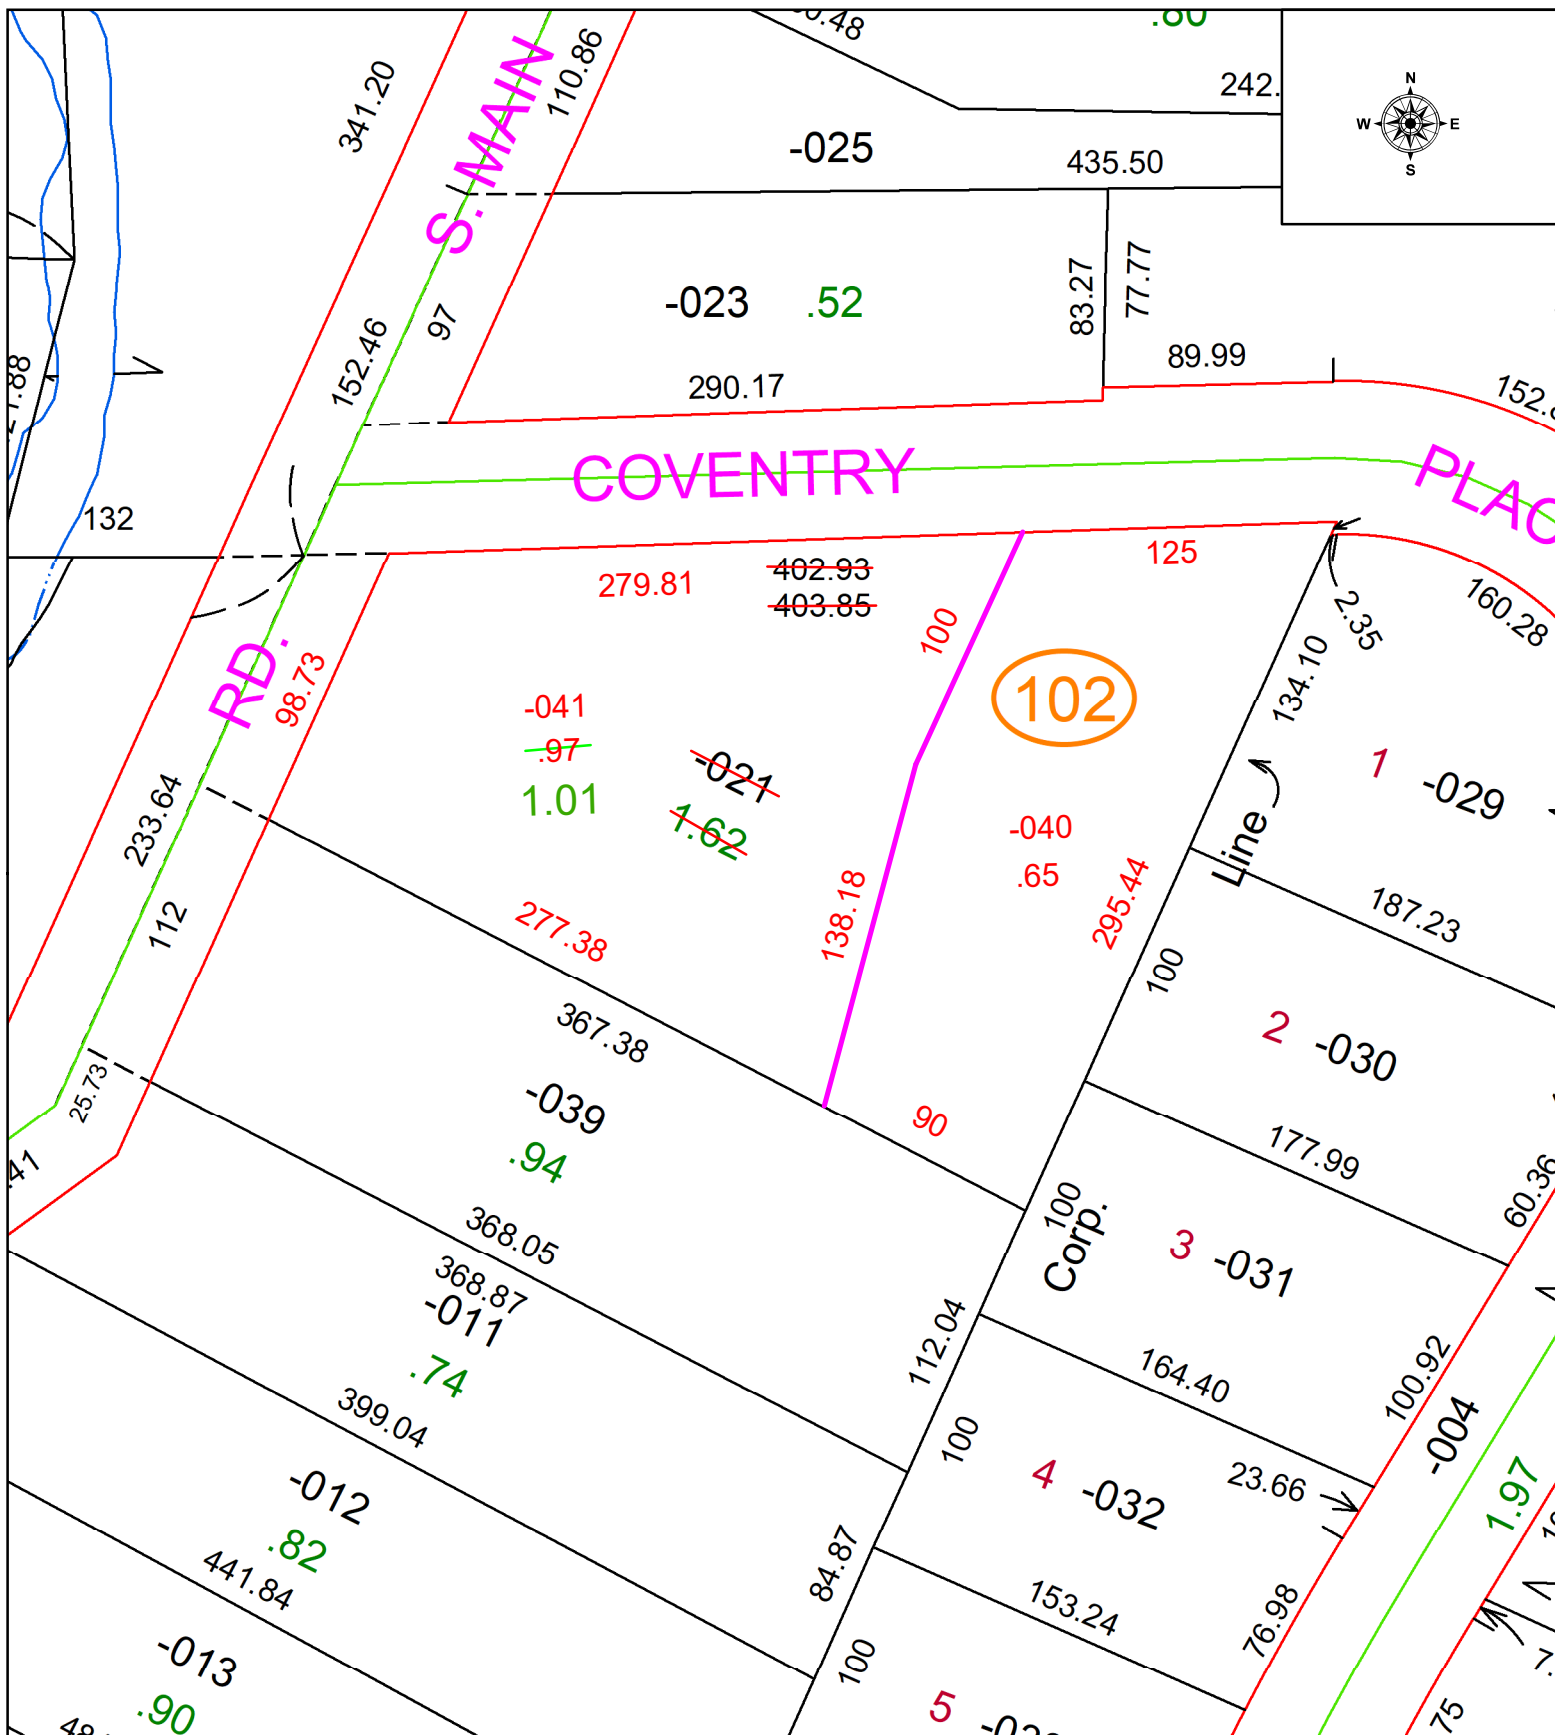

LORAIN COUNTY TAX MAP DEPARTMENT
226 MIDDLE AVE. ELYRIA, OH

SURVEY # 51608

MAP PAGE(S): 05-00-016

MAP PAGE(S):

APPROVED BY: WRZ **DATE:** 11/25/2025

SCALE: 1" = 75' **PRIOR INSTRUMENT:** #2008-092812

DATE: 11/25/2025

PRIOR INSTRUMENT: #2008-092812