



PARENT PARCEL: 03-00-015-000-029, -054, -055, & -056

CHILD PARCEL: 03-00-015-000-143 & -144

STARTING POINT: C/L OF FRENCH CREEK AND ABBE RD

25-05103

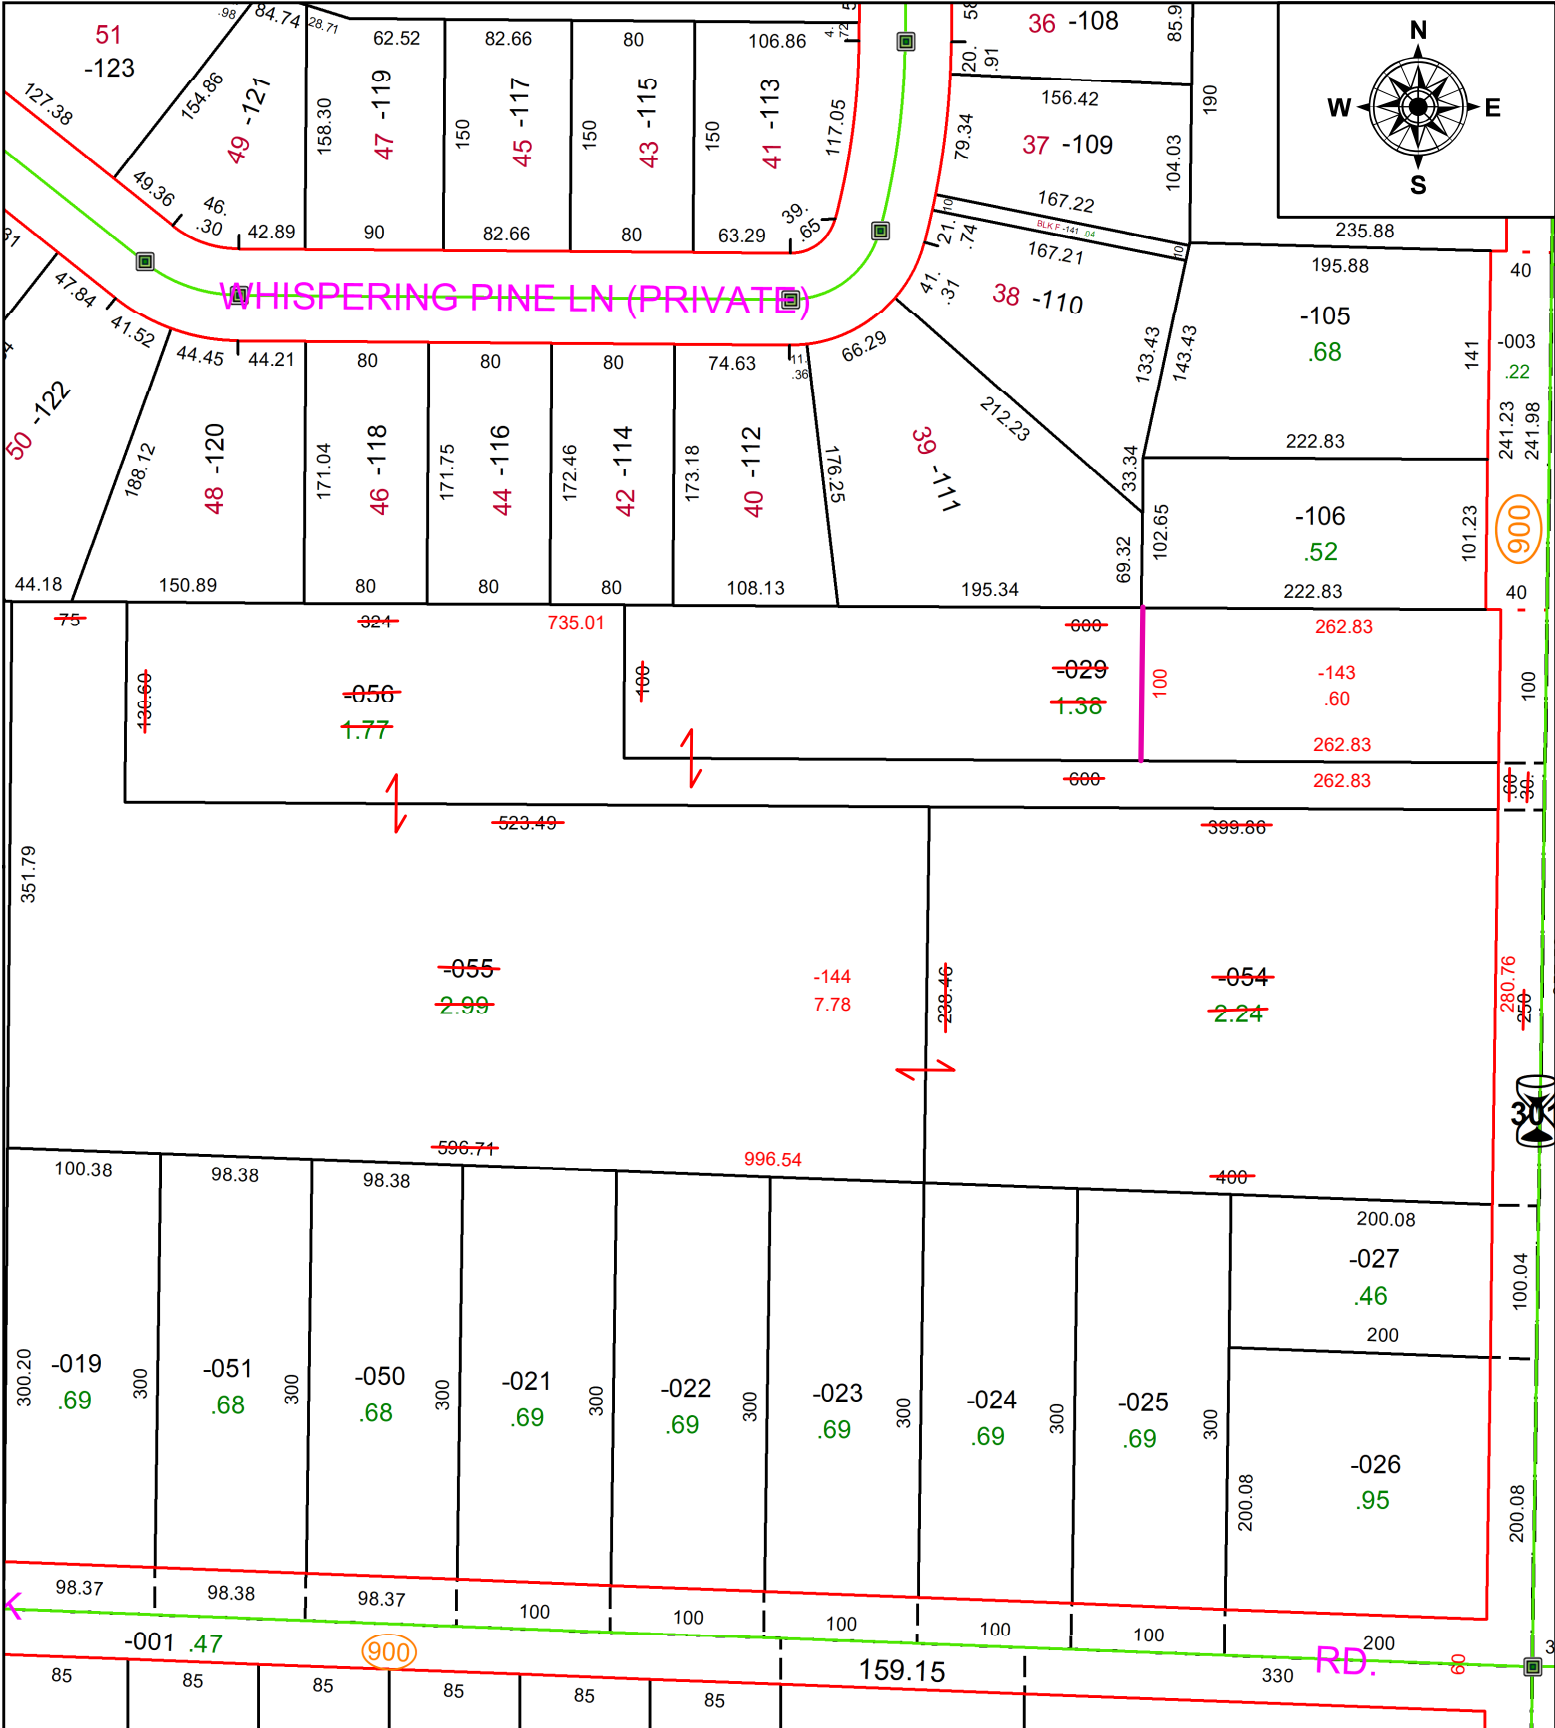

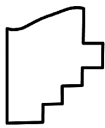 **SPLITS/DEEDS PROCESSED**
LORAIN COUNTY TAX MAP DEPARTMENT
226 MIDDLE AVE. ELYRIA, OH

SURVEYED BY: THOMAS A. SIMON **SURV # 51612**
CLOSURE: 1: INF
MAP PAGE(S): 03-00-015
APPROVED BY: AC **DATE:** December 01, 2025
SCALE: 1 in = 125 ft **PRIOR INSTRUMENT:** 2001- 0732669