
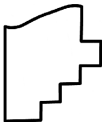


PARENT PARCEL: 17-20-015-000-001, 17-06-005-000-002, & ST: 17-06-004-000-002

CHILD PARCEL: 17-20-015-000-007 & -008, 17-06-005-000-004 & -005

STARTING POINT: C/L OF GORE ORPHANAGE RD AND NW CORNER OF O/L 5

25-05105

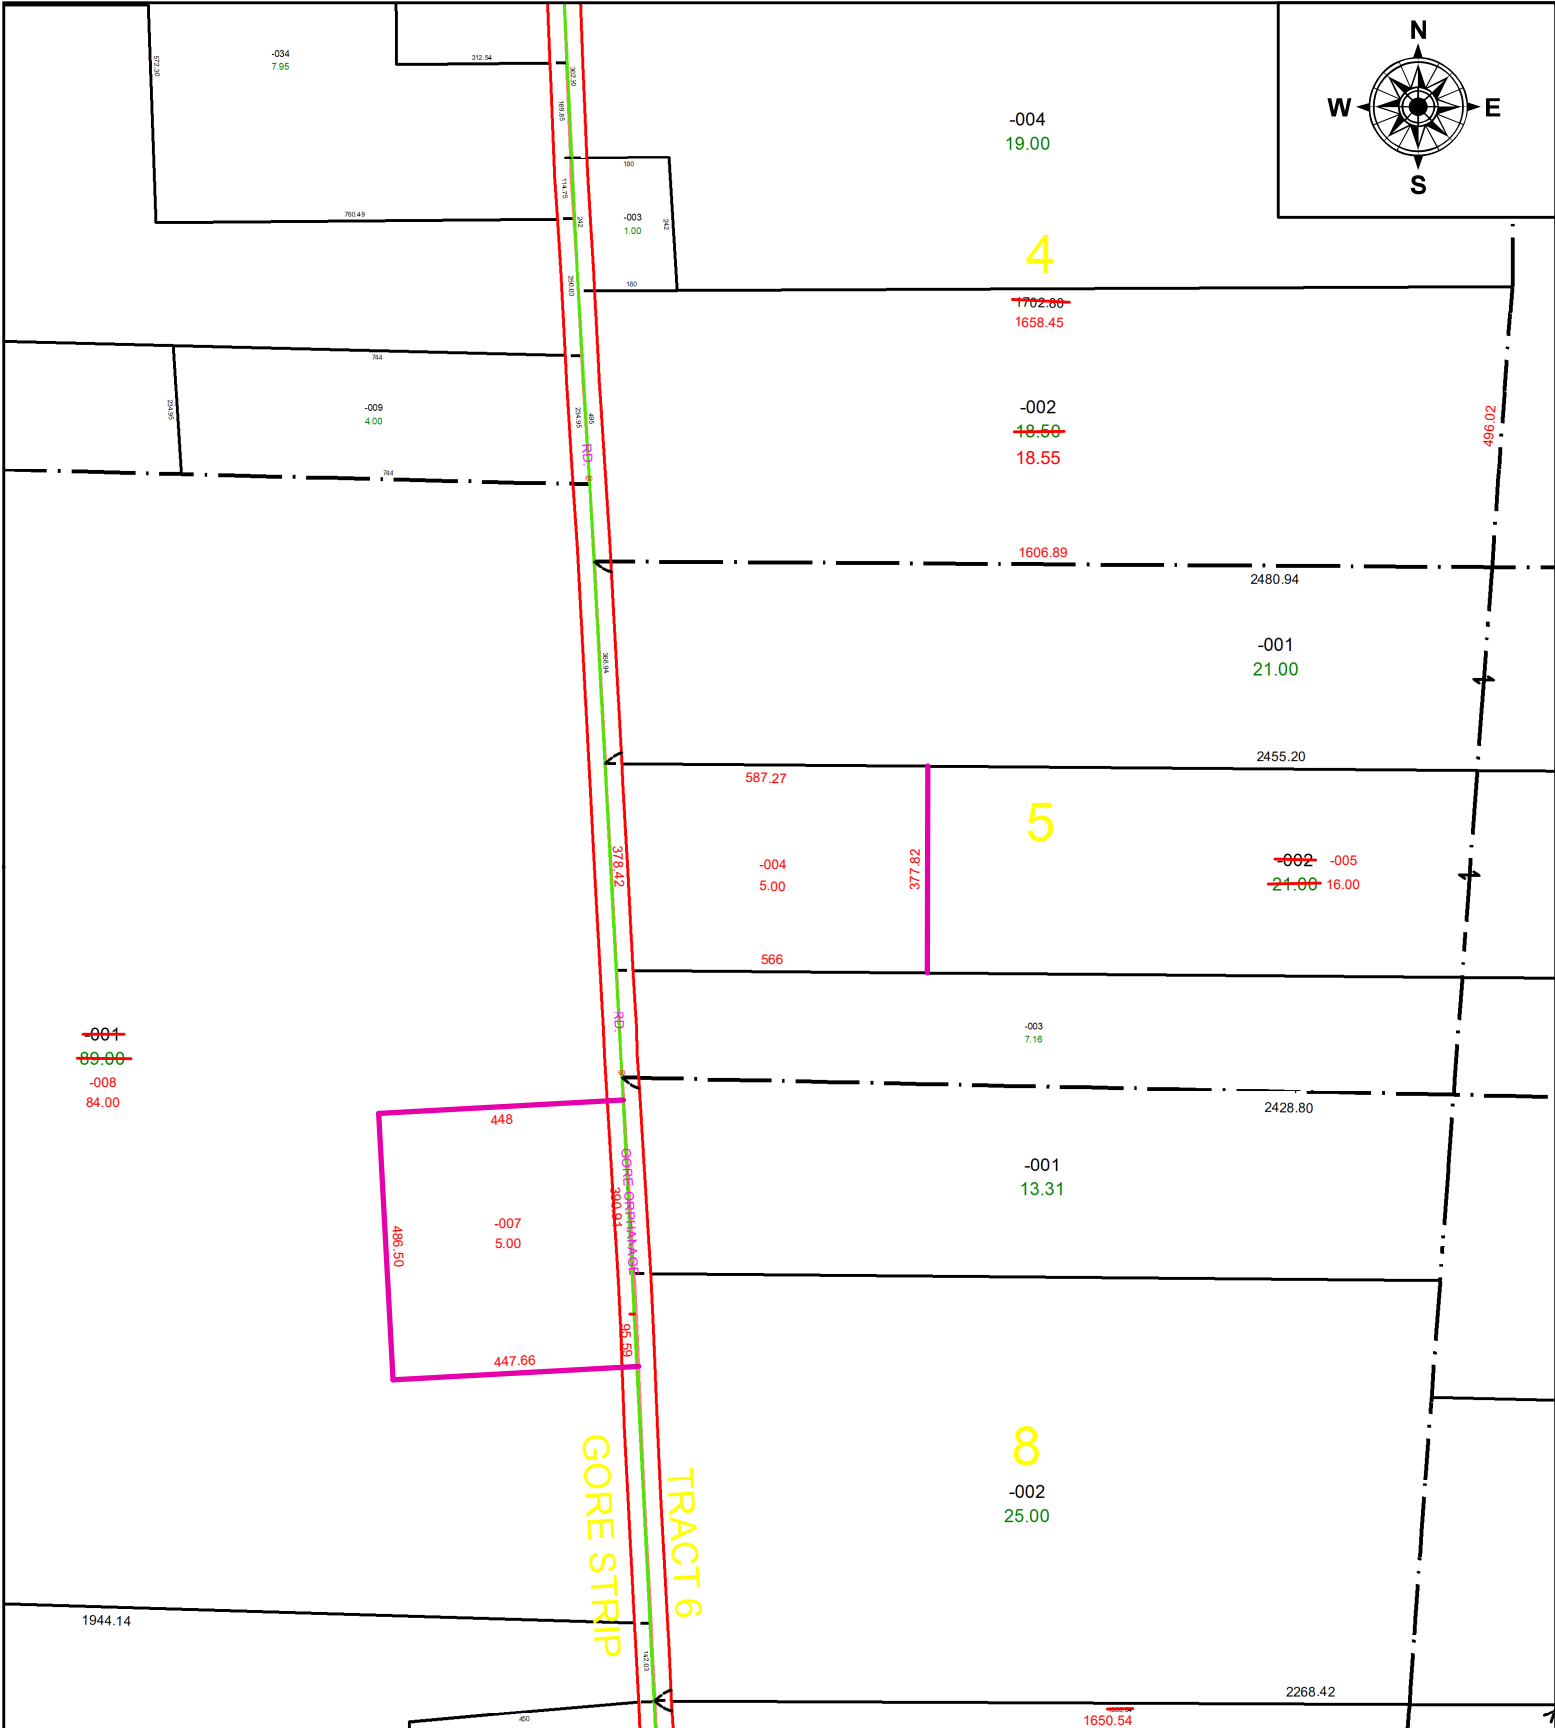

SPLITS/DEEDS PROCESSED
LORAIN COUNTY TAX MAP DEPARTMENT
226 MIDDLE AVE. ELYRIA, OH

SURVEYED BY: TIMOTHY D. HOZALSKI SURV # 51615
CLOSURE: 1: 845029
MAP PAGE(S): 17-20-015
APPROVED BY: AC DATE: December 05, 2025
SCALE: 1 in = 350 ft PRIOR INSTRUMENT: 2023- 0909157