


PARENT PARCEL: 04-00-017-103-021, -022, -073, -341, -071, -222, -223, -077, -075, -111, -133

CHILD PARCEL: 04-00-017-103-400 THRU -413



STARTING POINT: 5/8" I.P. MON. BOX, CL OF WALKER RD. & CL OF S.R.83

25-05107

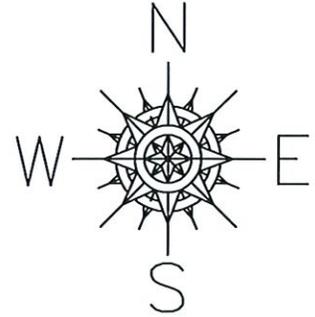

WALKER ROAD

AVON-BELDEN RD. (S.R. 83)

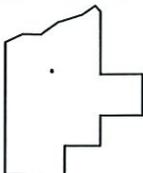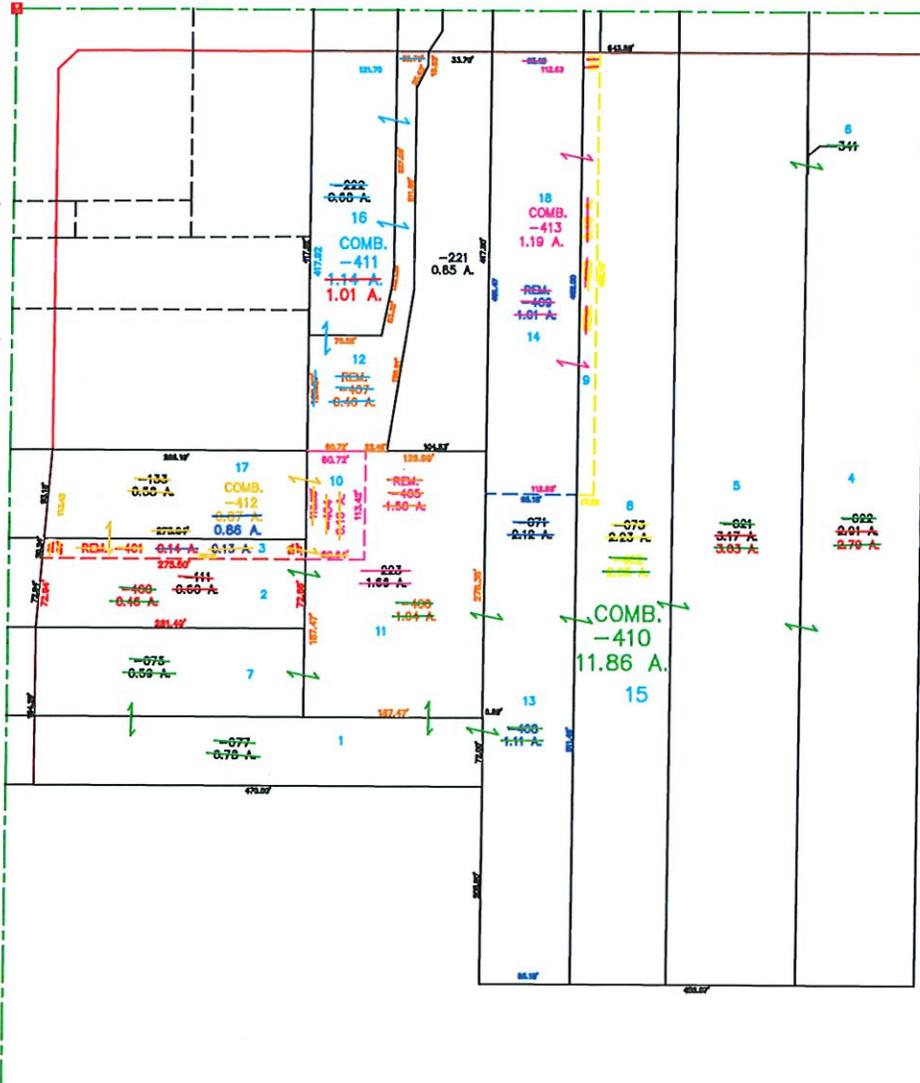

SPLITS/DEEDS PROCESSED
LORAIN COUNTY TAX MAP DEPARTMENT
226 MIDDLE AVE. ELYRIA, OHIO

SURVEYED BY: J. SAYLER
CLOSURE: 0.00 : 10,000
MAP PAGE(S): 4-00-017
APPROVED BY: TJS DATE: 1/5/2026
SCALE: 1" = 200' PRIOR INSTRUMENT: