
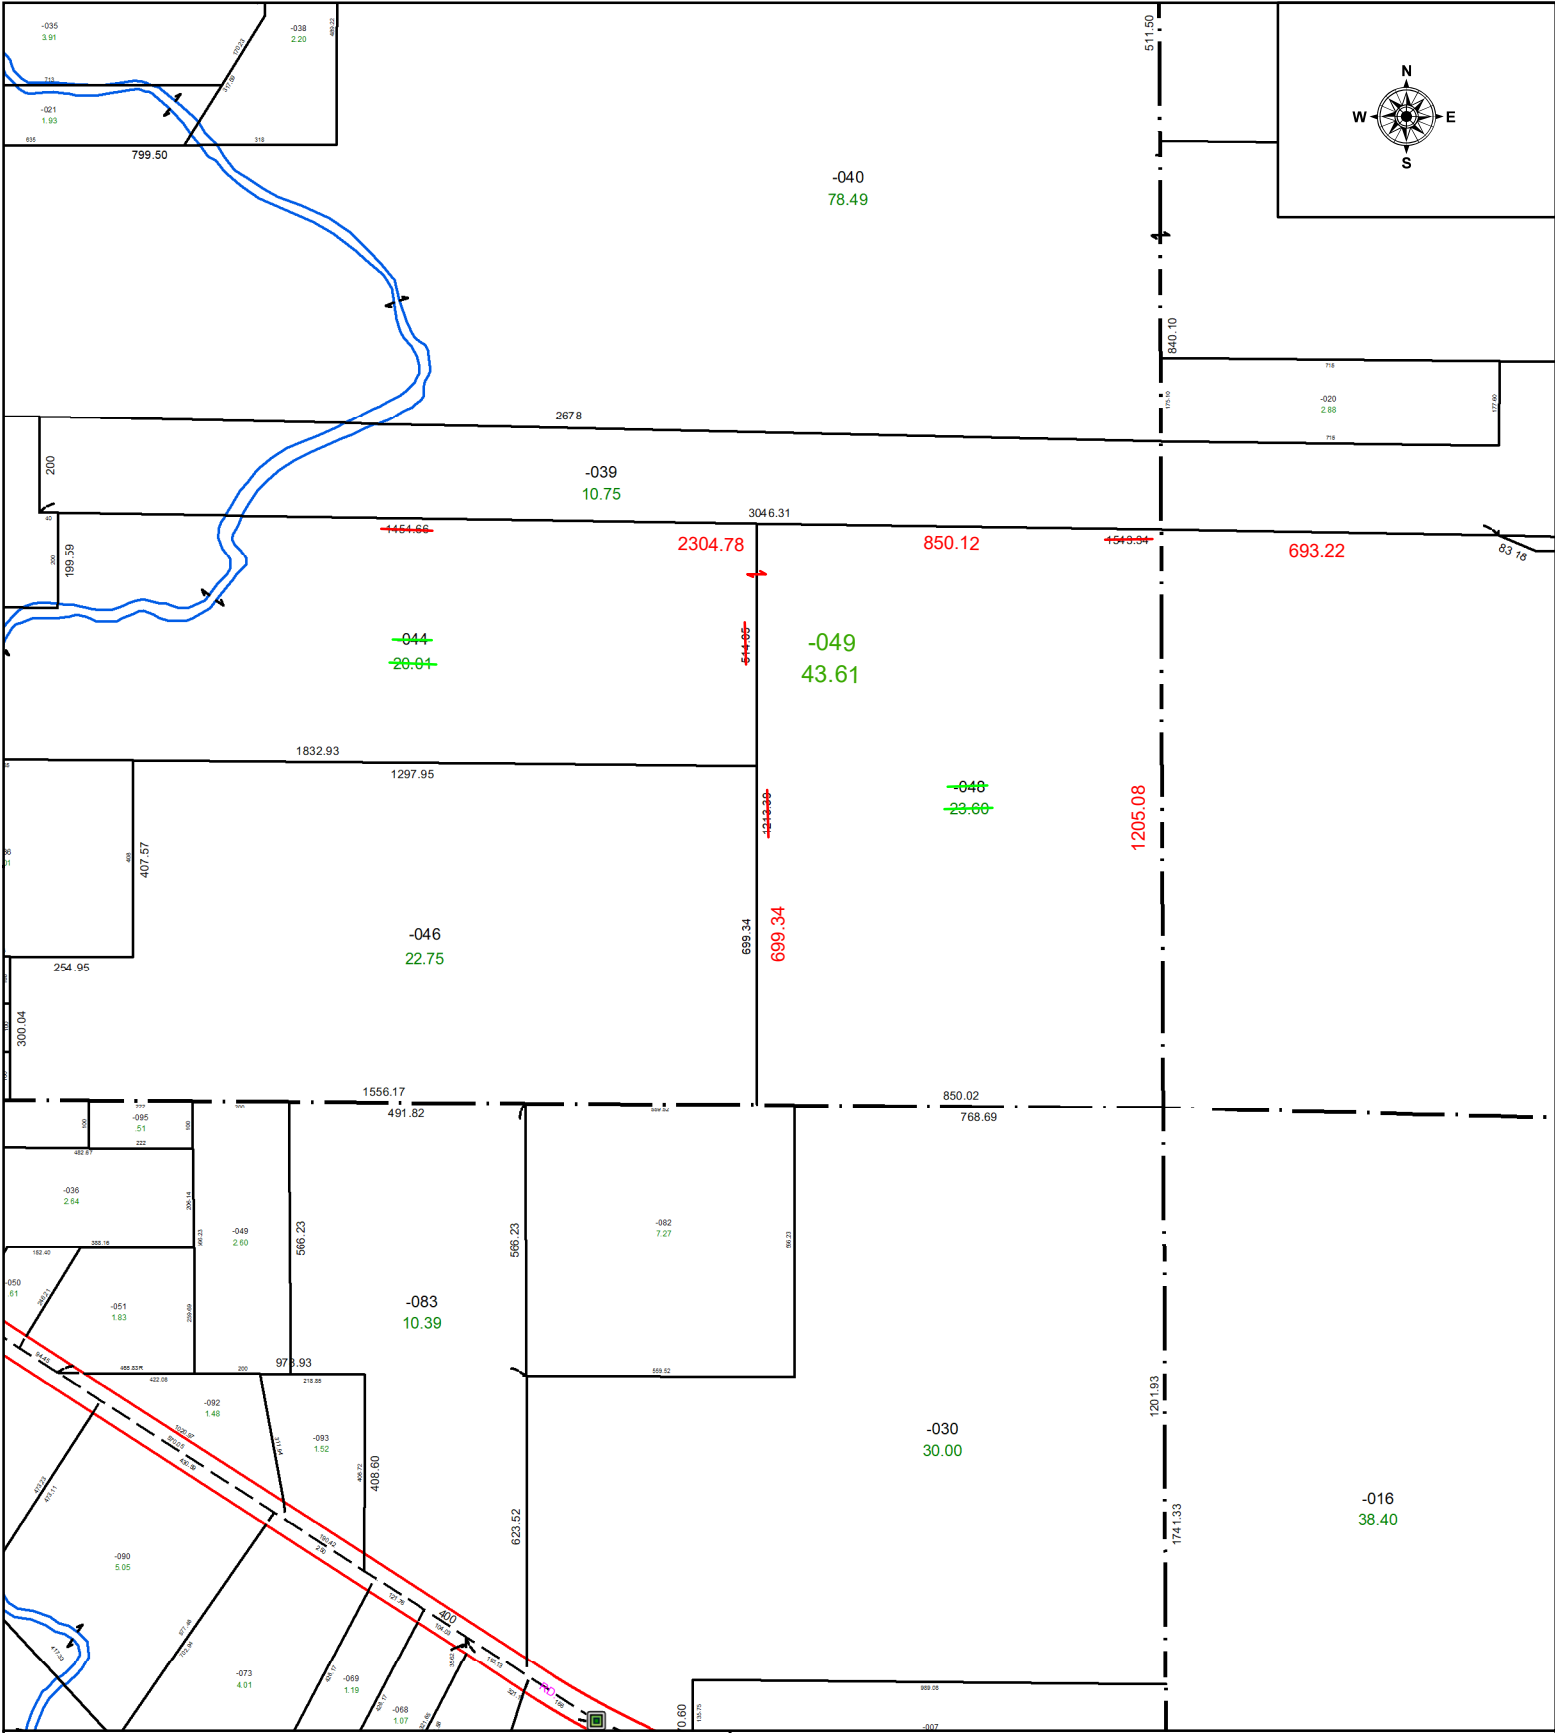


PARENT PARCEL: 11-00-073-000-044, -048, 11-00-068-000-024 (S.T.), & 11-00-067-000-016 (S.T.)
CHILD PARCEL: 11-00-073-000-049
STARTING POINT: MON. BOX @ C/L OF N. DURKEE RD & SOUTHWEST CORNER OF O.L. 73

25-05108

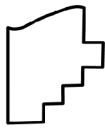


SPLITS/DEEDS PROCESSED
LORAIN COUNTY TAX MAP DEPARTMENT
226 MIDDLE AVE. ELYRIA, OH

SURVEYED BY: TERRENCE WORSECH
CLOSURE: 1: 505343
MAP PAGE(S): 11-00-073, 11-00-067, & 11-00-068
APPROVED BY: WRZ **DATE:** 12/9/2025
SCALE: 1" = 400 **PRIOR INSTRUMENT:** #2022-0865150

SURVEY # 51618