
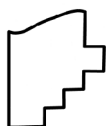


PARENT PARCEL: 11-00-093-102-041 ACREAGE & LINEWORK CORRECTION

CHILD PARCEL: 11-00-093-102-113 0.29 A. (ADD TO DUP. PER DV 78/582)

STARTING POINT: N.W. CORNER OF S/L 5 IN FLINT RIDGE ALLOTMENT NO. 2 PV. 36 PG. 50

23-05111-C

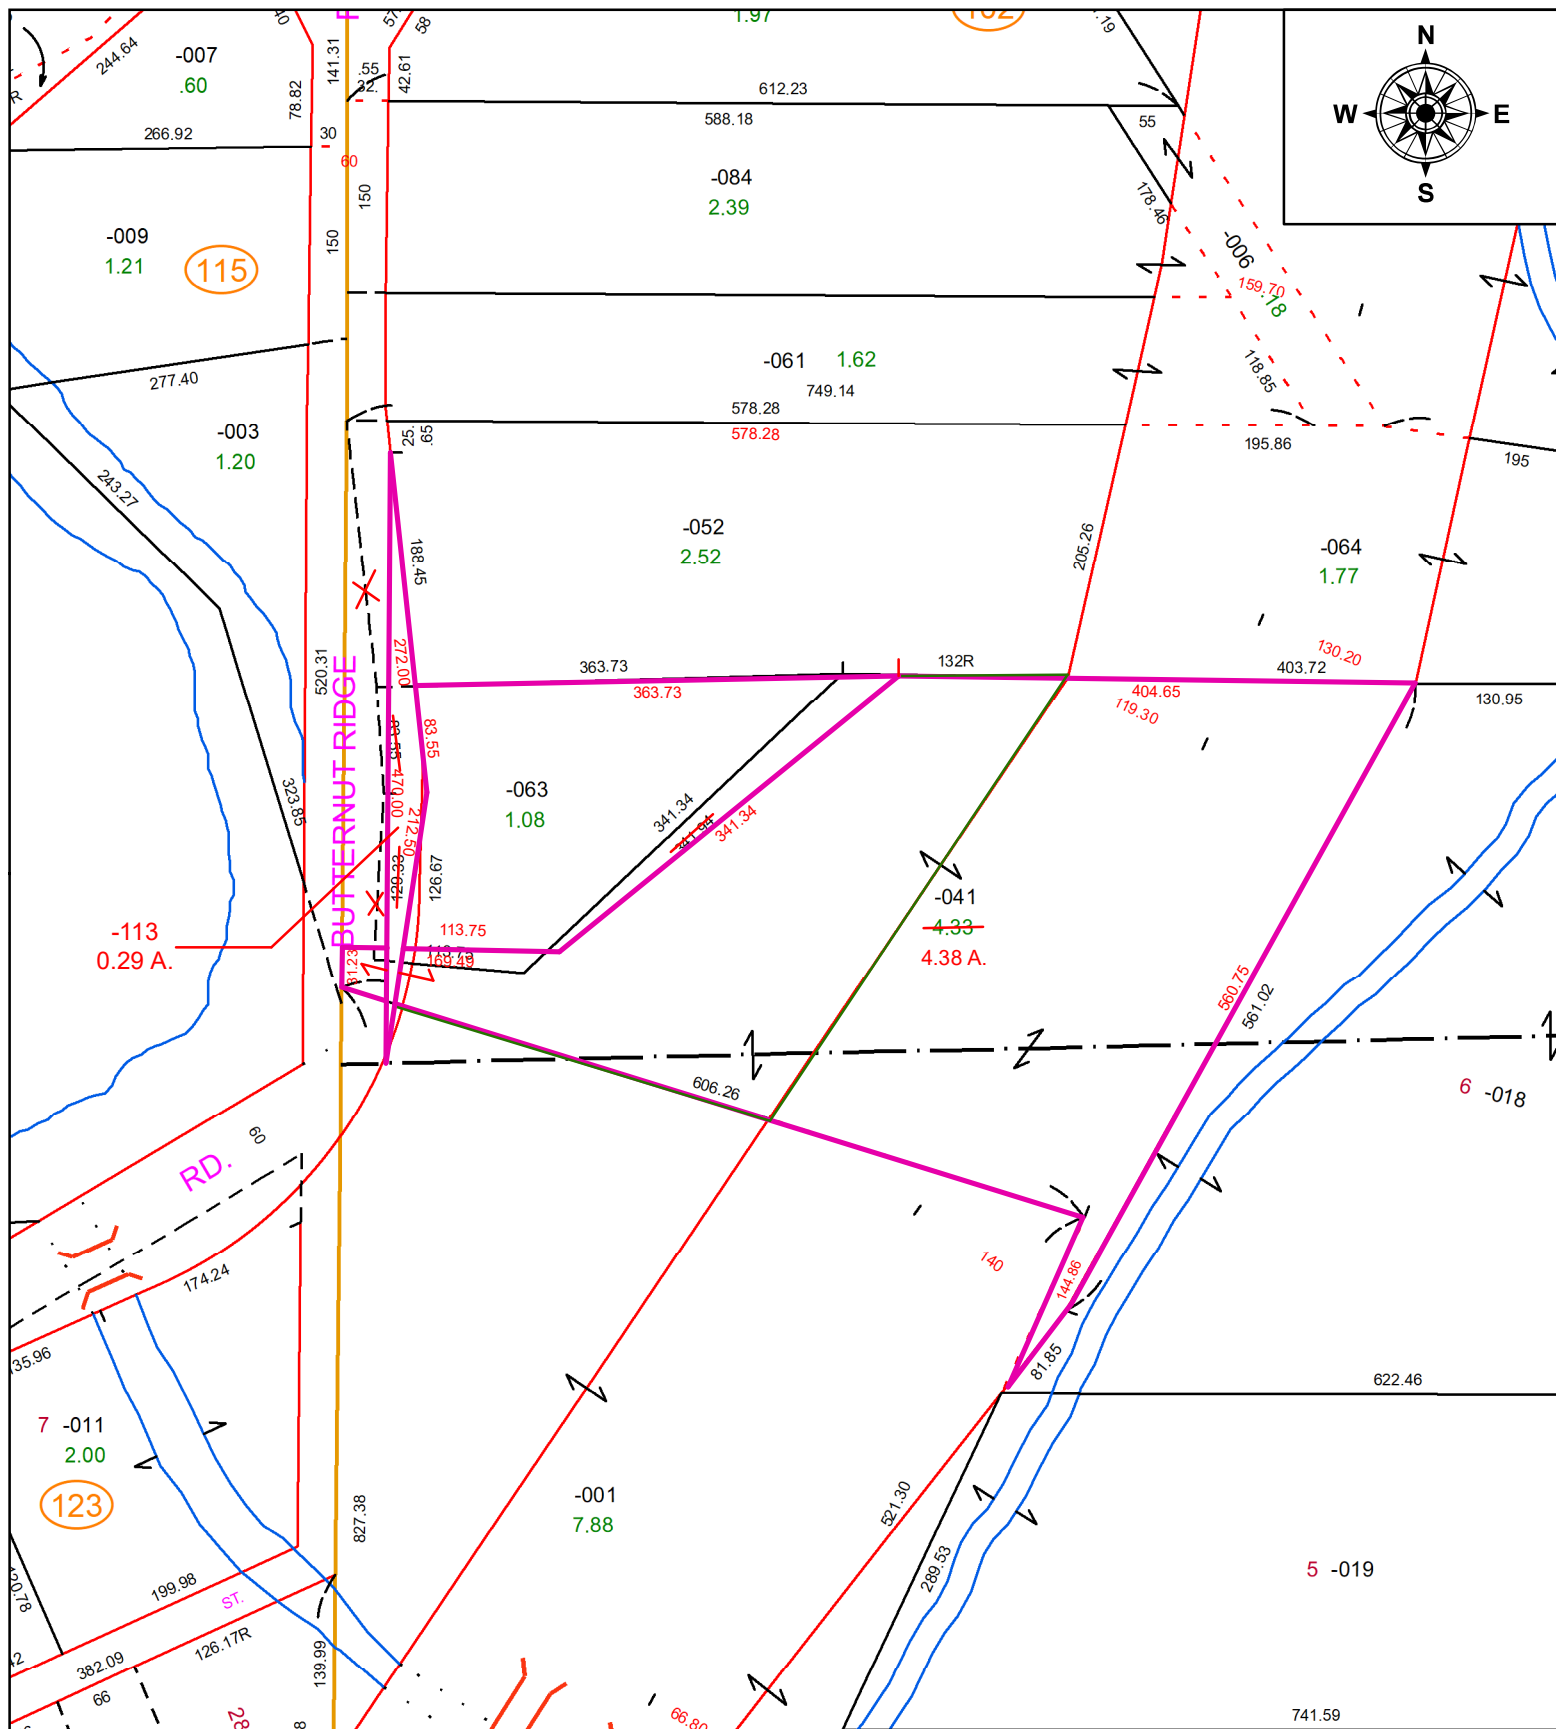

SPLITS/DEEDS PROCESSED
 LORAIN COUNTY TAX MAP DEPARTMENT
 226 MIDDLE AVE. ELYRIA, OH

SURVEYED BY: T. SIMON
CLOSURE: 1:323254
MAP PAGE(S): 11-00-093
APPROVED BY: TJS **DATE:** 7/20/2023
SCALE: 1" = 150' **PRIOR INSTRUMENT:** 2021-0837174