

PARENT PARCEL: _____

04-00-016-102-025



25-05111

CHILD PARCEL: _____

04-00-016-102-110 & -111

STARTING POINT: _____

5/8" I.P. FD. S.E. CORNER OF ORIGINAL AVON SEC. 16

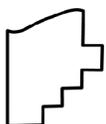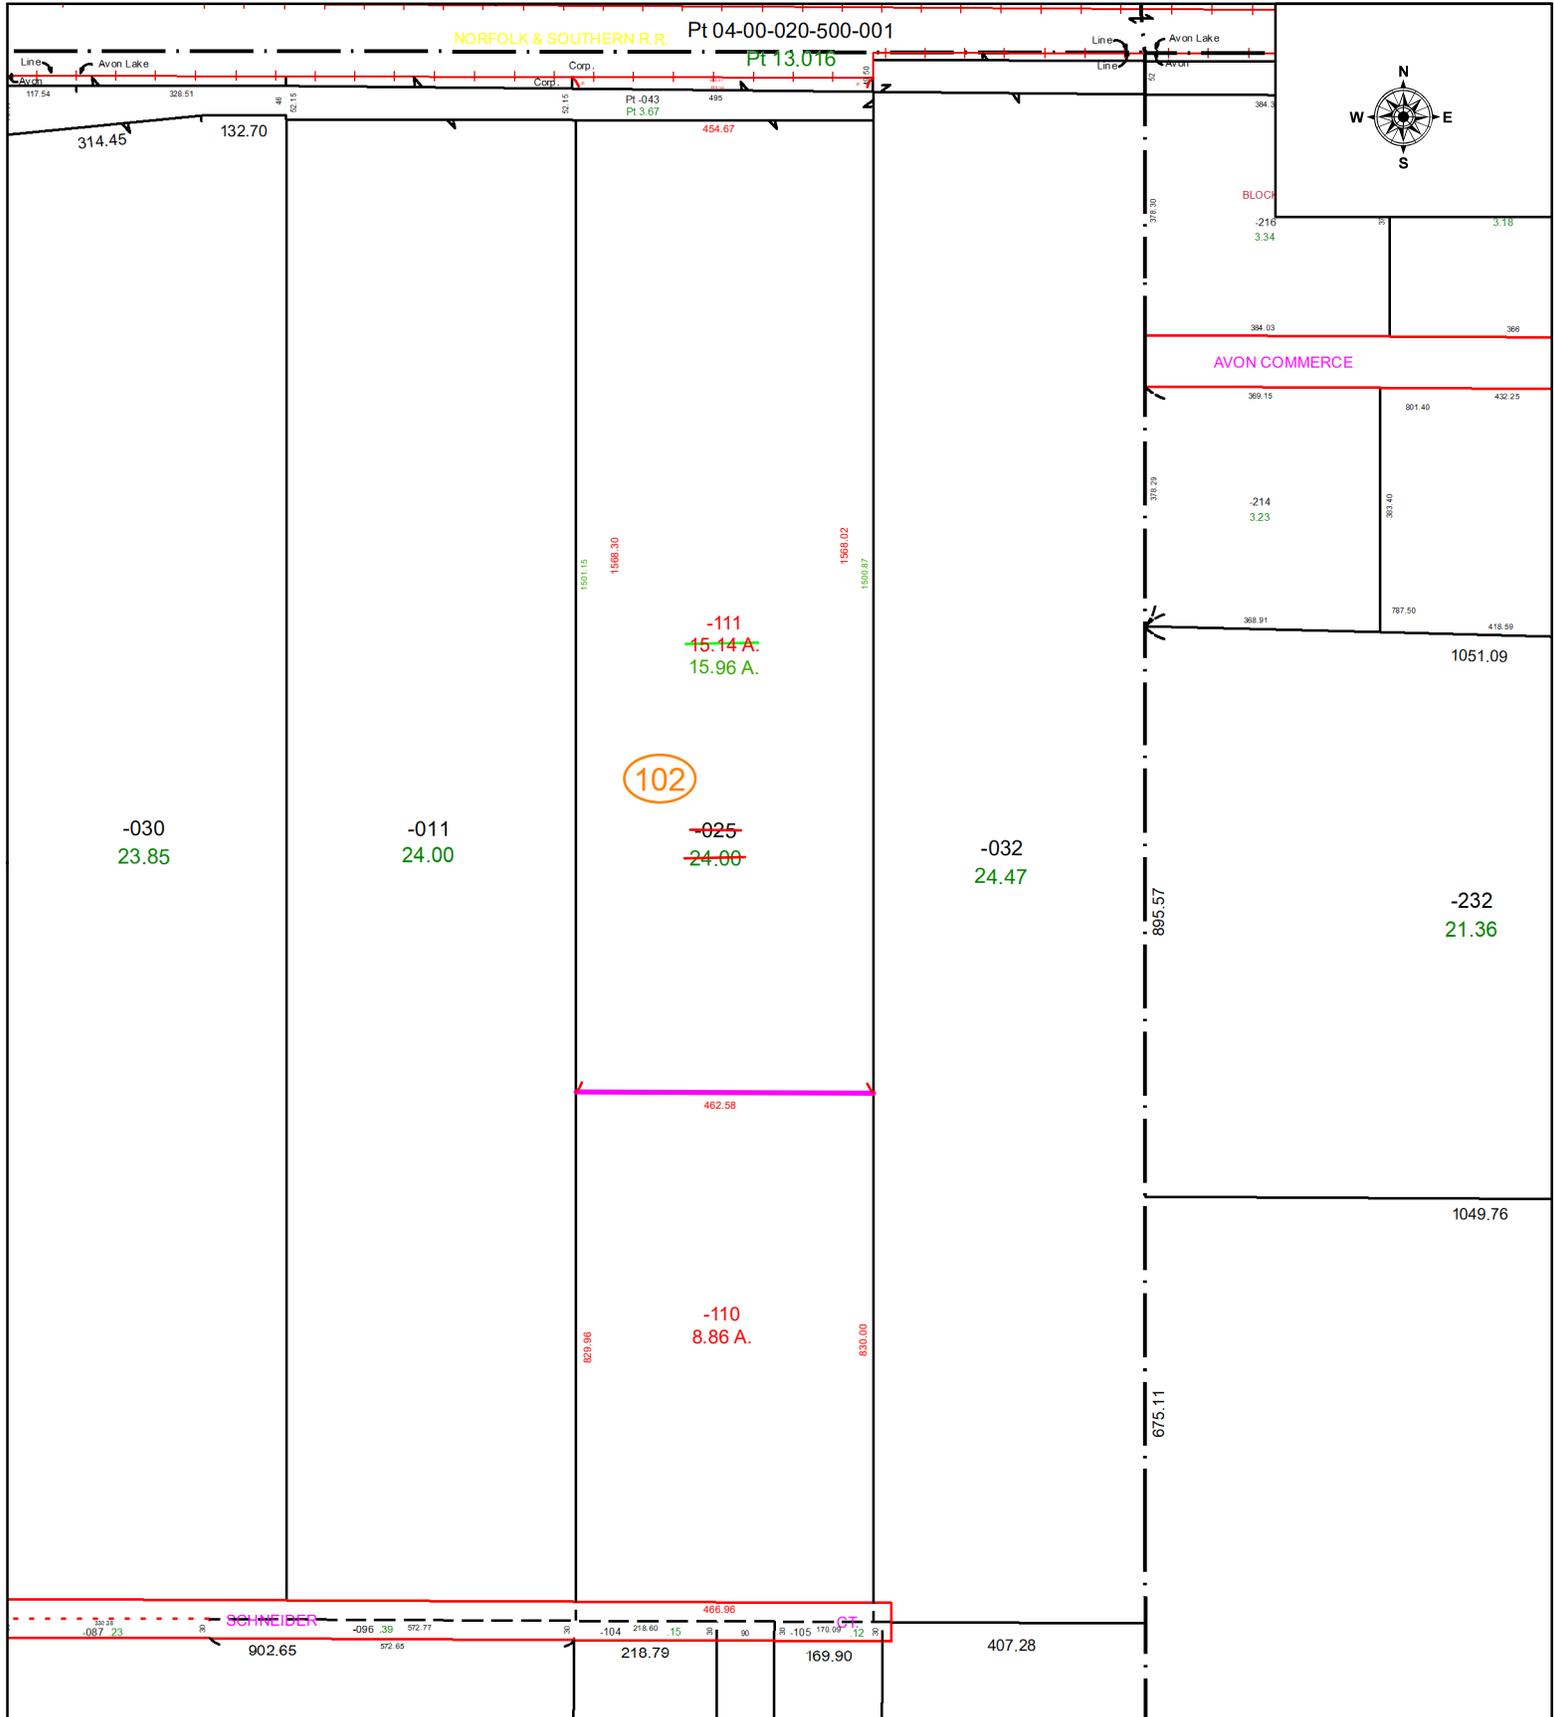

SPLITS/DEEDS PROCESSED
 LORAIN COUNTY TAX MAP DEPARTMENT
 226 MIDDLE AVE. ELYRIA, OH

SURVEYED BY: _____ AMY KELLY SURVEY # 51624
 CLOSURE: _____ 1: 67696
 MAP PAGE(S): _____ 4-00-016
 APPROVED BY: _____ TJS DATE: 12/30/2025
 SCALE: 1" = 300' PRIOR INSTRUMENT: 2025-0052991