
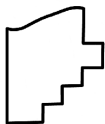


PARENT PARCEL: 02-02-024-115-062

CHILD PARCEL: **MAP CORRECTION ONLY**

STARTING POINT: NE CORNER OF S/L 28

23-05112-C

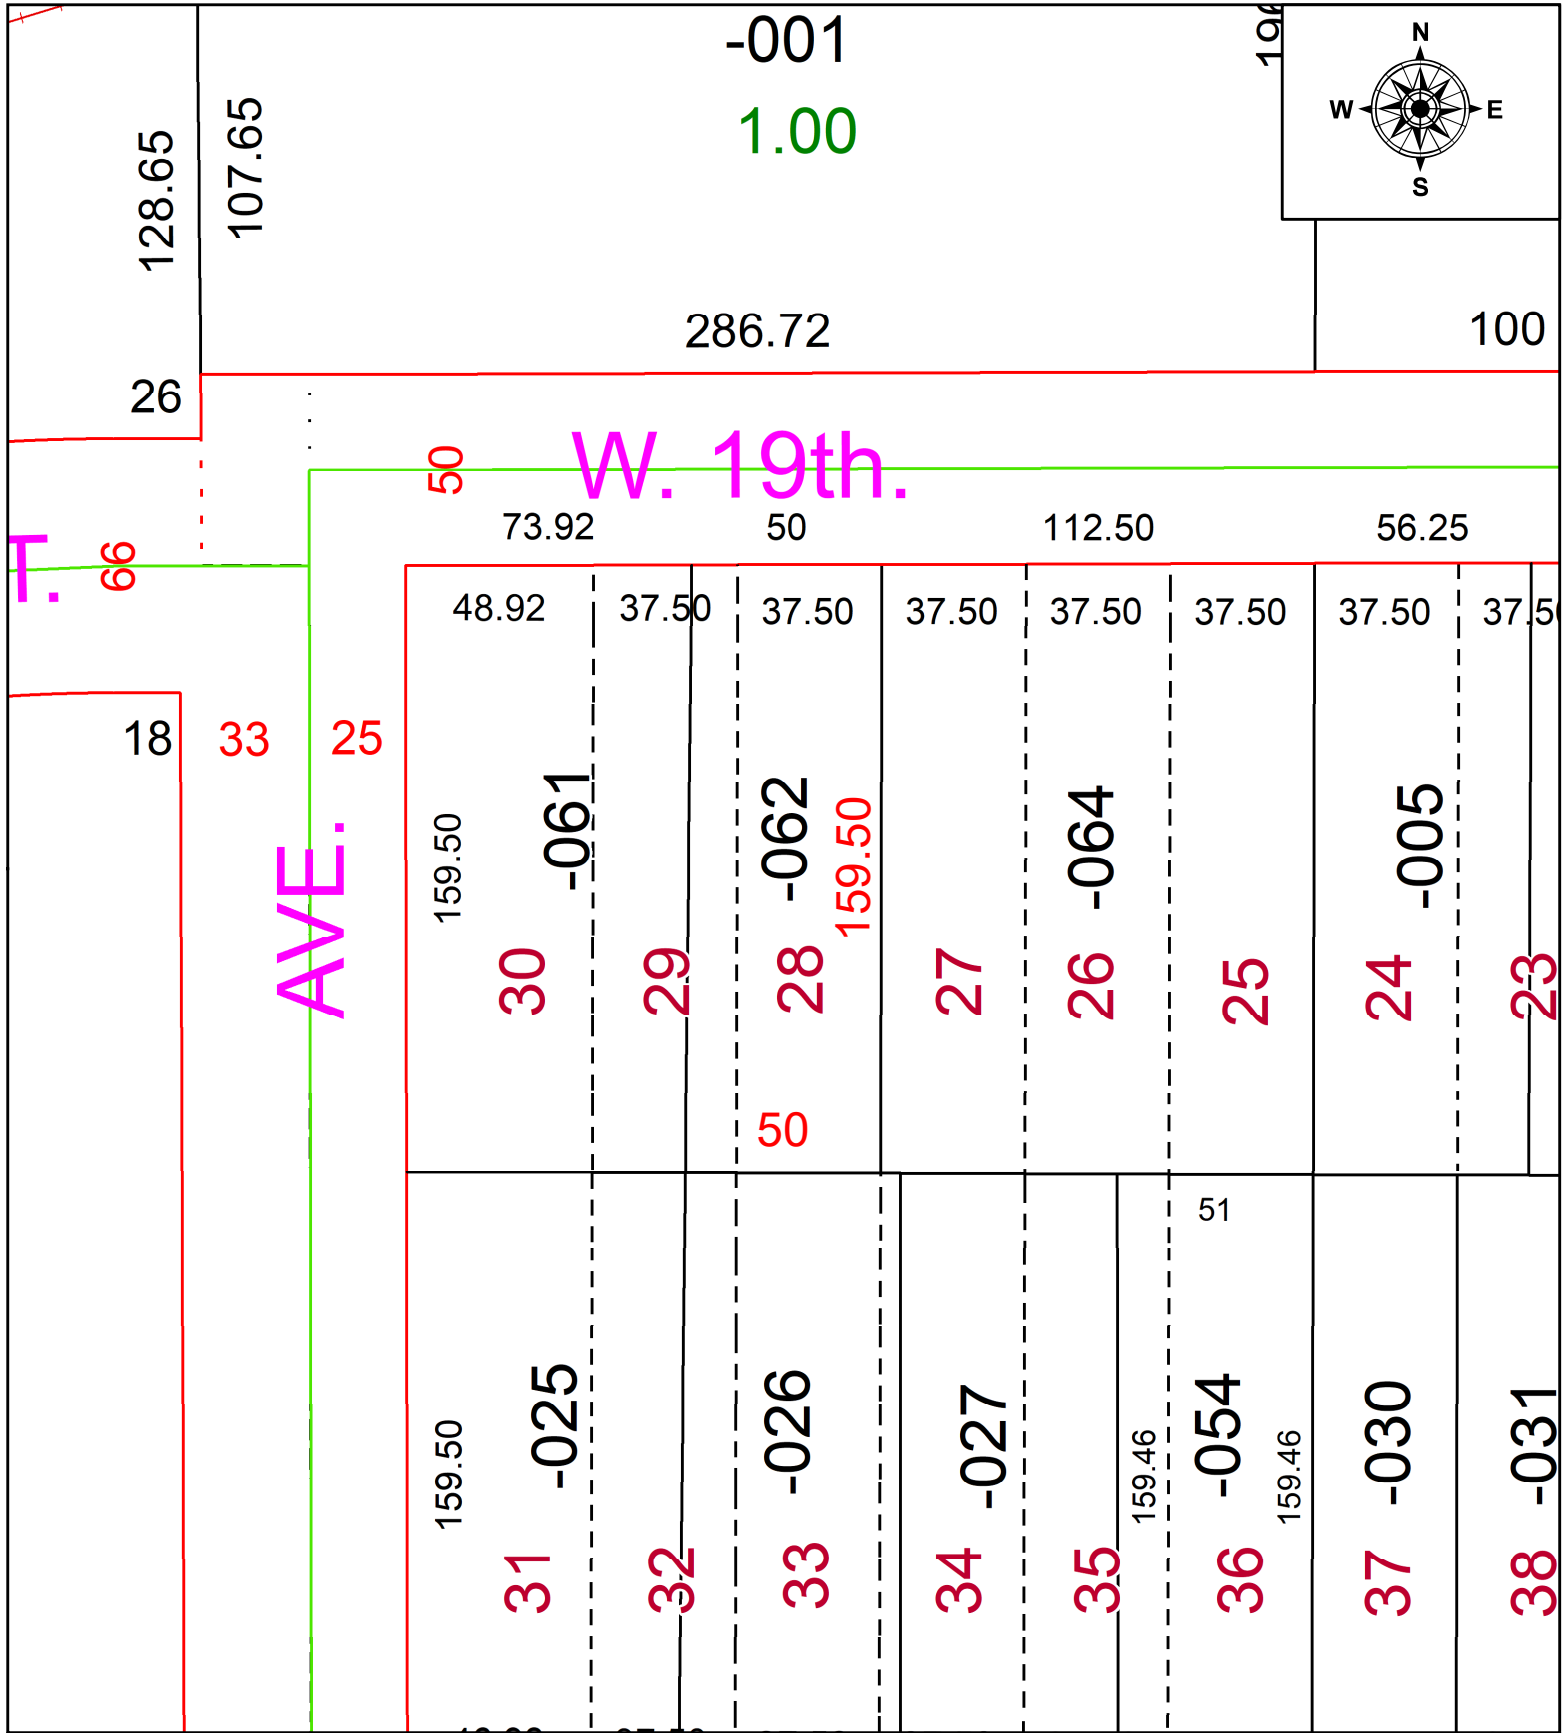

**SPLITS/DEEDS PROCESSED**  
LORAIN COUNTY TAX MAP DEPARTMENT  
226 MIDDLE AVE. ELYRIA, OH

SURVEYED BY: WILFREDO BARBOSA	SURV # 50940
CLOSURE: 1: 2147483648	
MAP PAGE(S): 02-02-024	
APPROVED BY: AC	DATE: July 12, 2023
SCALE: 1 in = 50 ft	PRIOR INSTRUMENT: 2022- 0887632