

PARENT PARCEL: 01-00-033-000-050, 01-00-034-000-050, -051, -056


AC CORR PER JOHN DECHANT JR

25-05112


CHILD PARCEL: 01-00-033-000-065 THRU -068, 01-00-034-000-057, & -058

DROP FROM DUP PER DV 1136/61

STARTING POINT: SOUTHEASTERLY CORNER OF O.L. 33

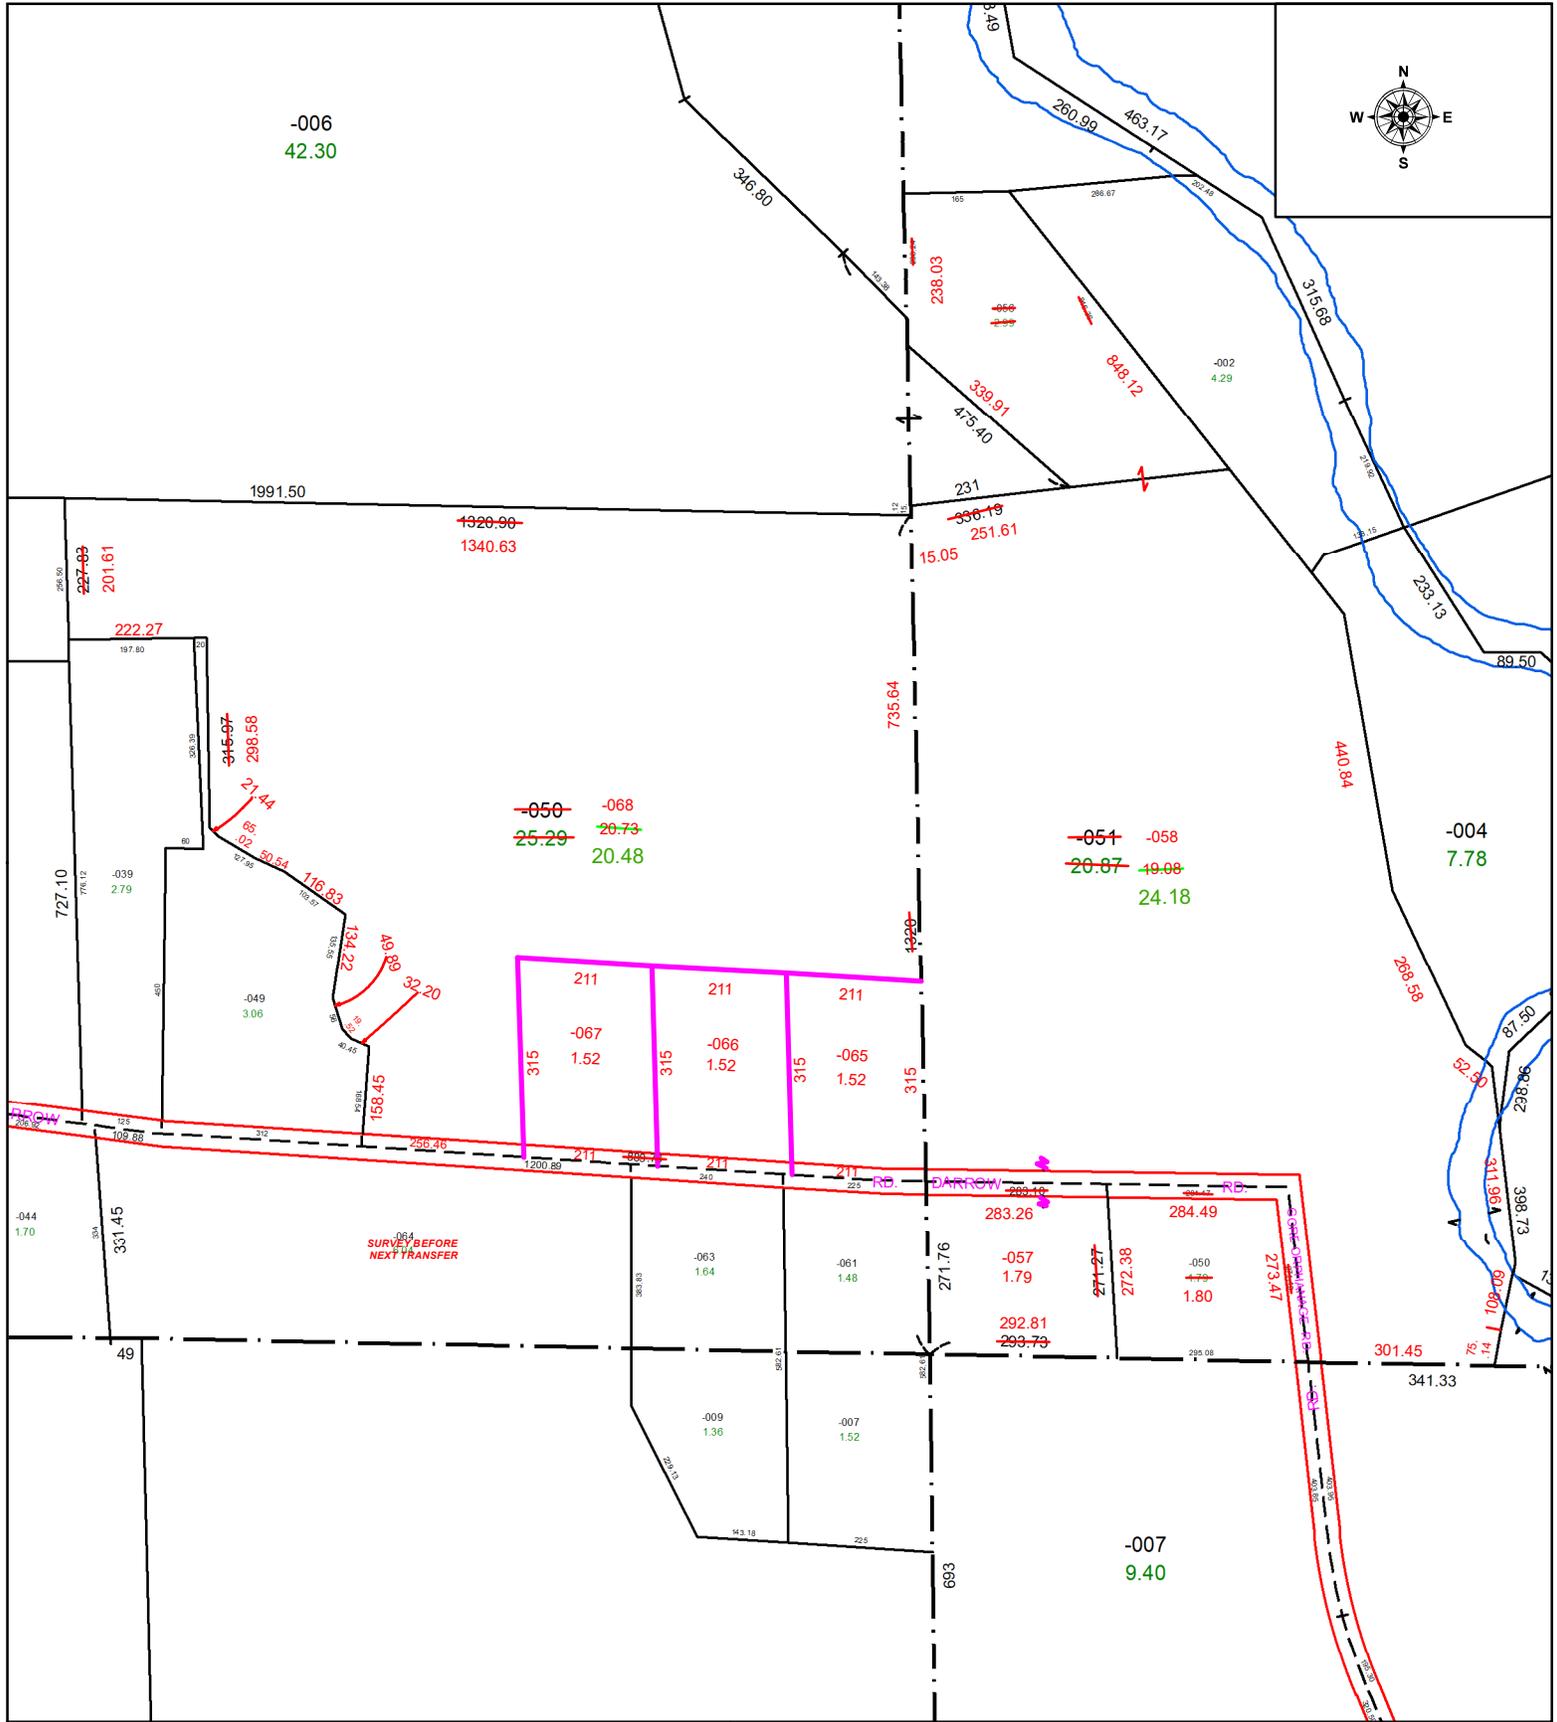

SURVEY BEFORE
NEXT TRANSFER

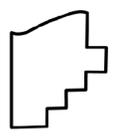

SPLITS/DEEDS PROCESSED
LORAIN COUNTY TAX MAP DEPARTMENT
226 MIDDLE AVE. ELYRIA, OH

SURVEYED BY: JOHN DECHANT JR SURVEY # 51629
 CLOSURE: 1:114807
 MAP PAGE(S): 01-00-033 & 01-00-034
 APPROVED BY: WRZ DATE: 12/29/2025
 SCALE: 1" = 300 PRIOR INSTRUMENT: #2010-00359333