
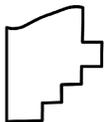


PARENT PARCEL: 13-09-009-000-003, -007, & ST: 13-09-010-000-002

CHILD PARCEL: 13-09-009-000-018, -019, & -020

STARTING POINT: SE CORNER OF O/L 10 **AC CORR PER SURV BY TIMOTHY D. HOZALSKI**

25-05113

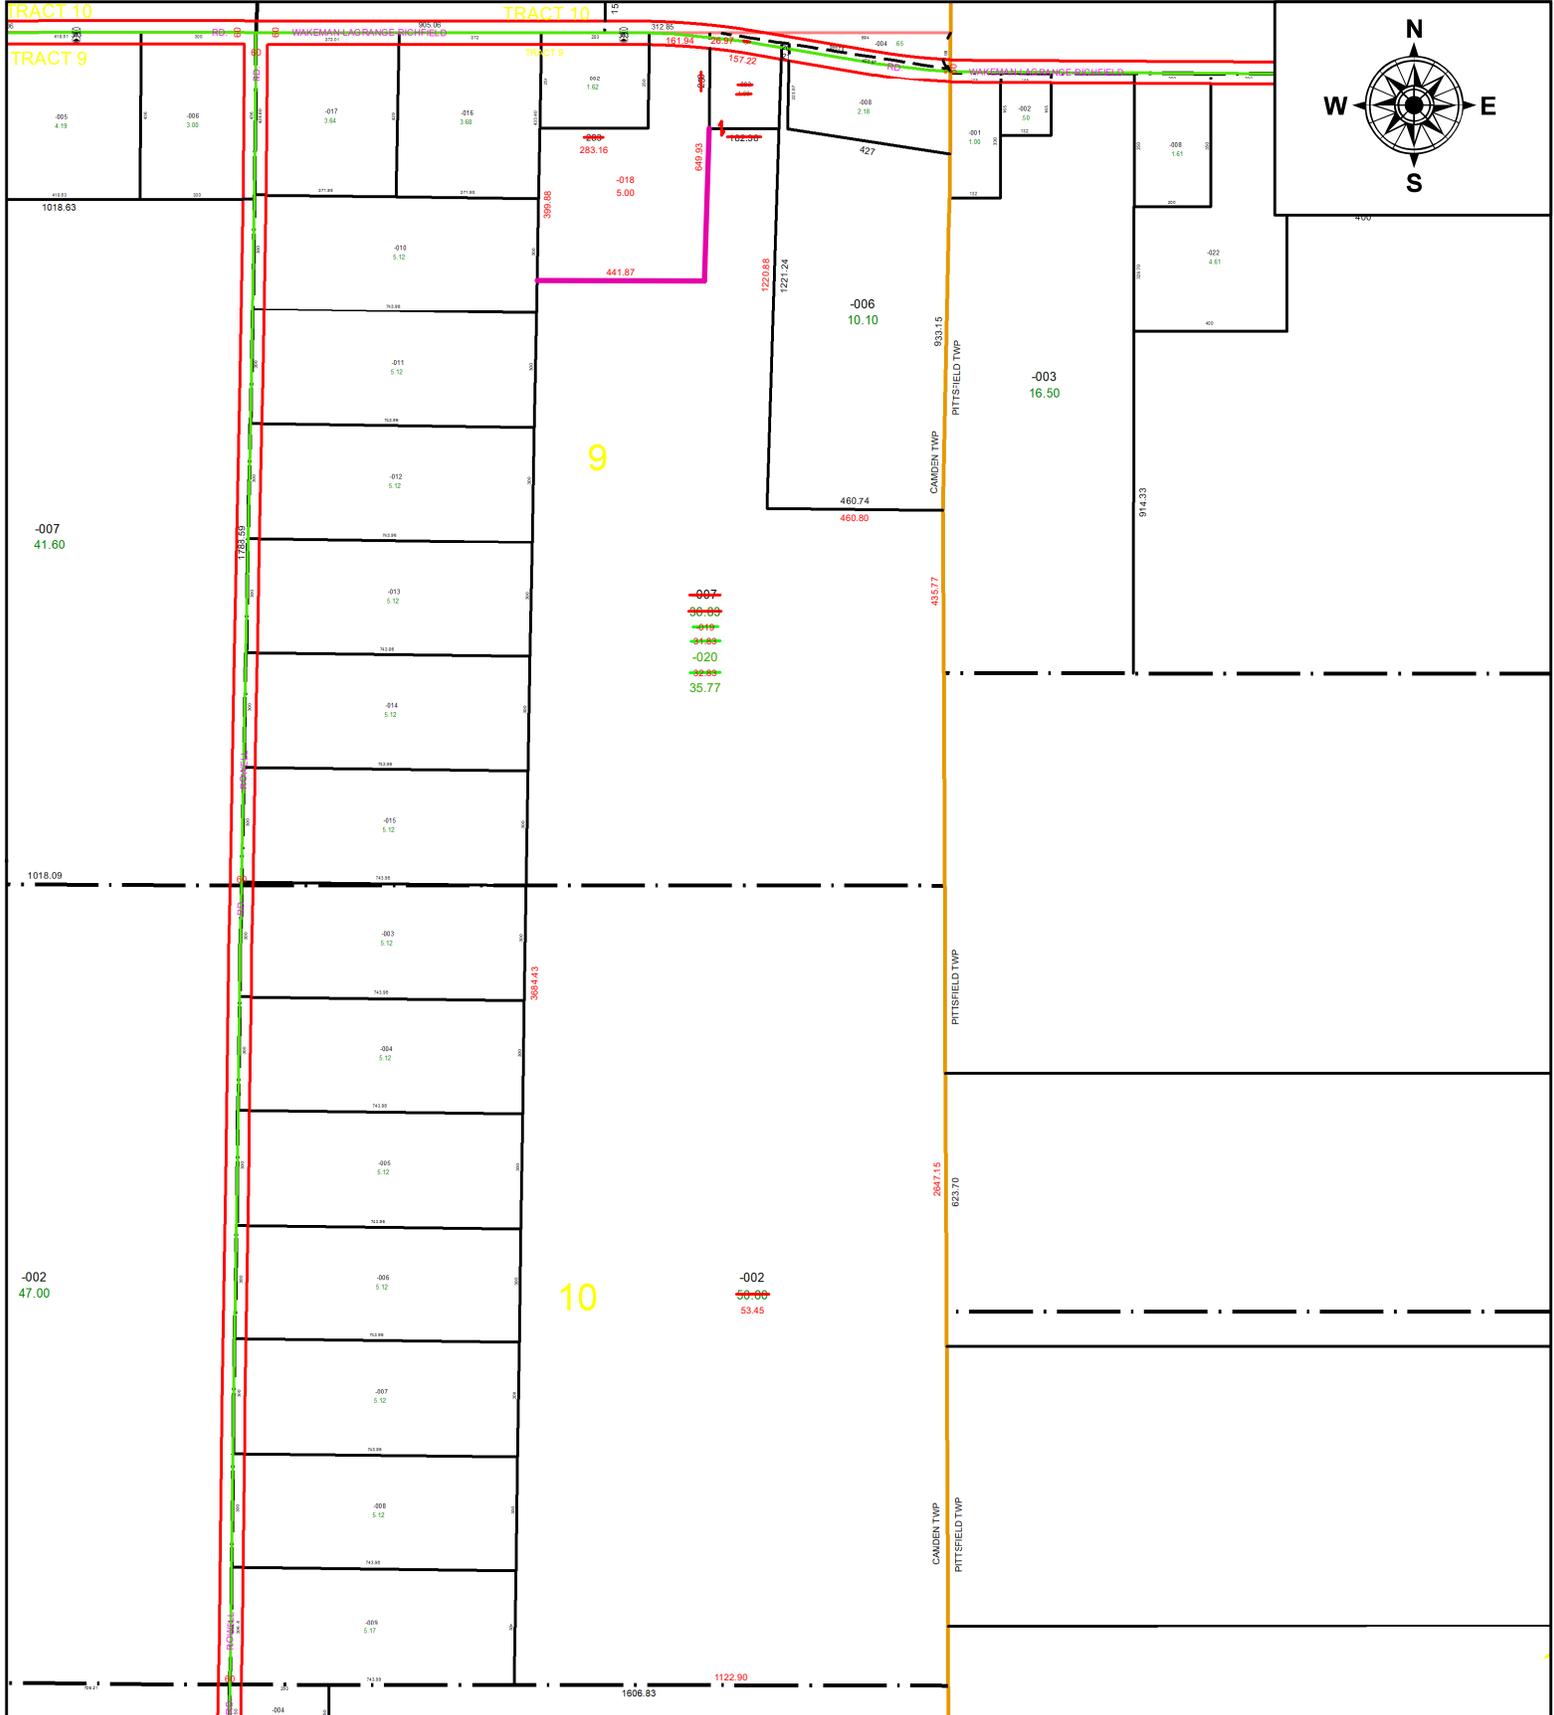

SPLITS/DEEDS PROCESSED
 LORAIN COUNTY TAX MAP DEPARTMENT
 226 MIDDLE AVE. ELYRIA, OH

SURVEYED BY: TIMOTHY D. HOZALSKI **SURV # 51632**
CLOSURE: 1: 309341
MAP PAGE(S): 13-09-009
APPROVED BY: AC **DATE:** January 05, 2026
SCALE: 1 in = 500 ft **PRIOR INSTRUMENT:** 2023- 0907456