
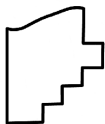


PARENT PARCEL: 01-00-017-000-227

CHILD PARCEL: **AC. CORR.**

STARTING POINT: N.W. CORNER OF S/L 17 BIG OAKS SUB. # 2 P.V. 31 PG.. 29

23-05115-C

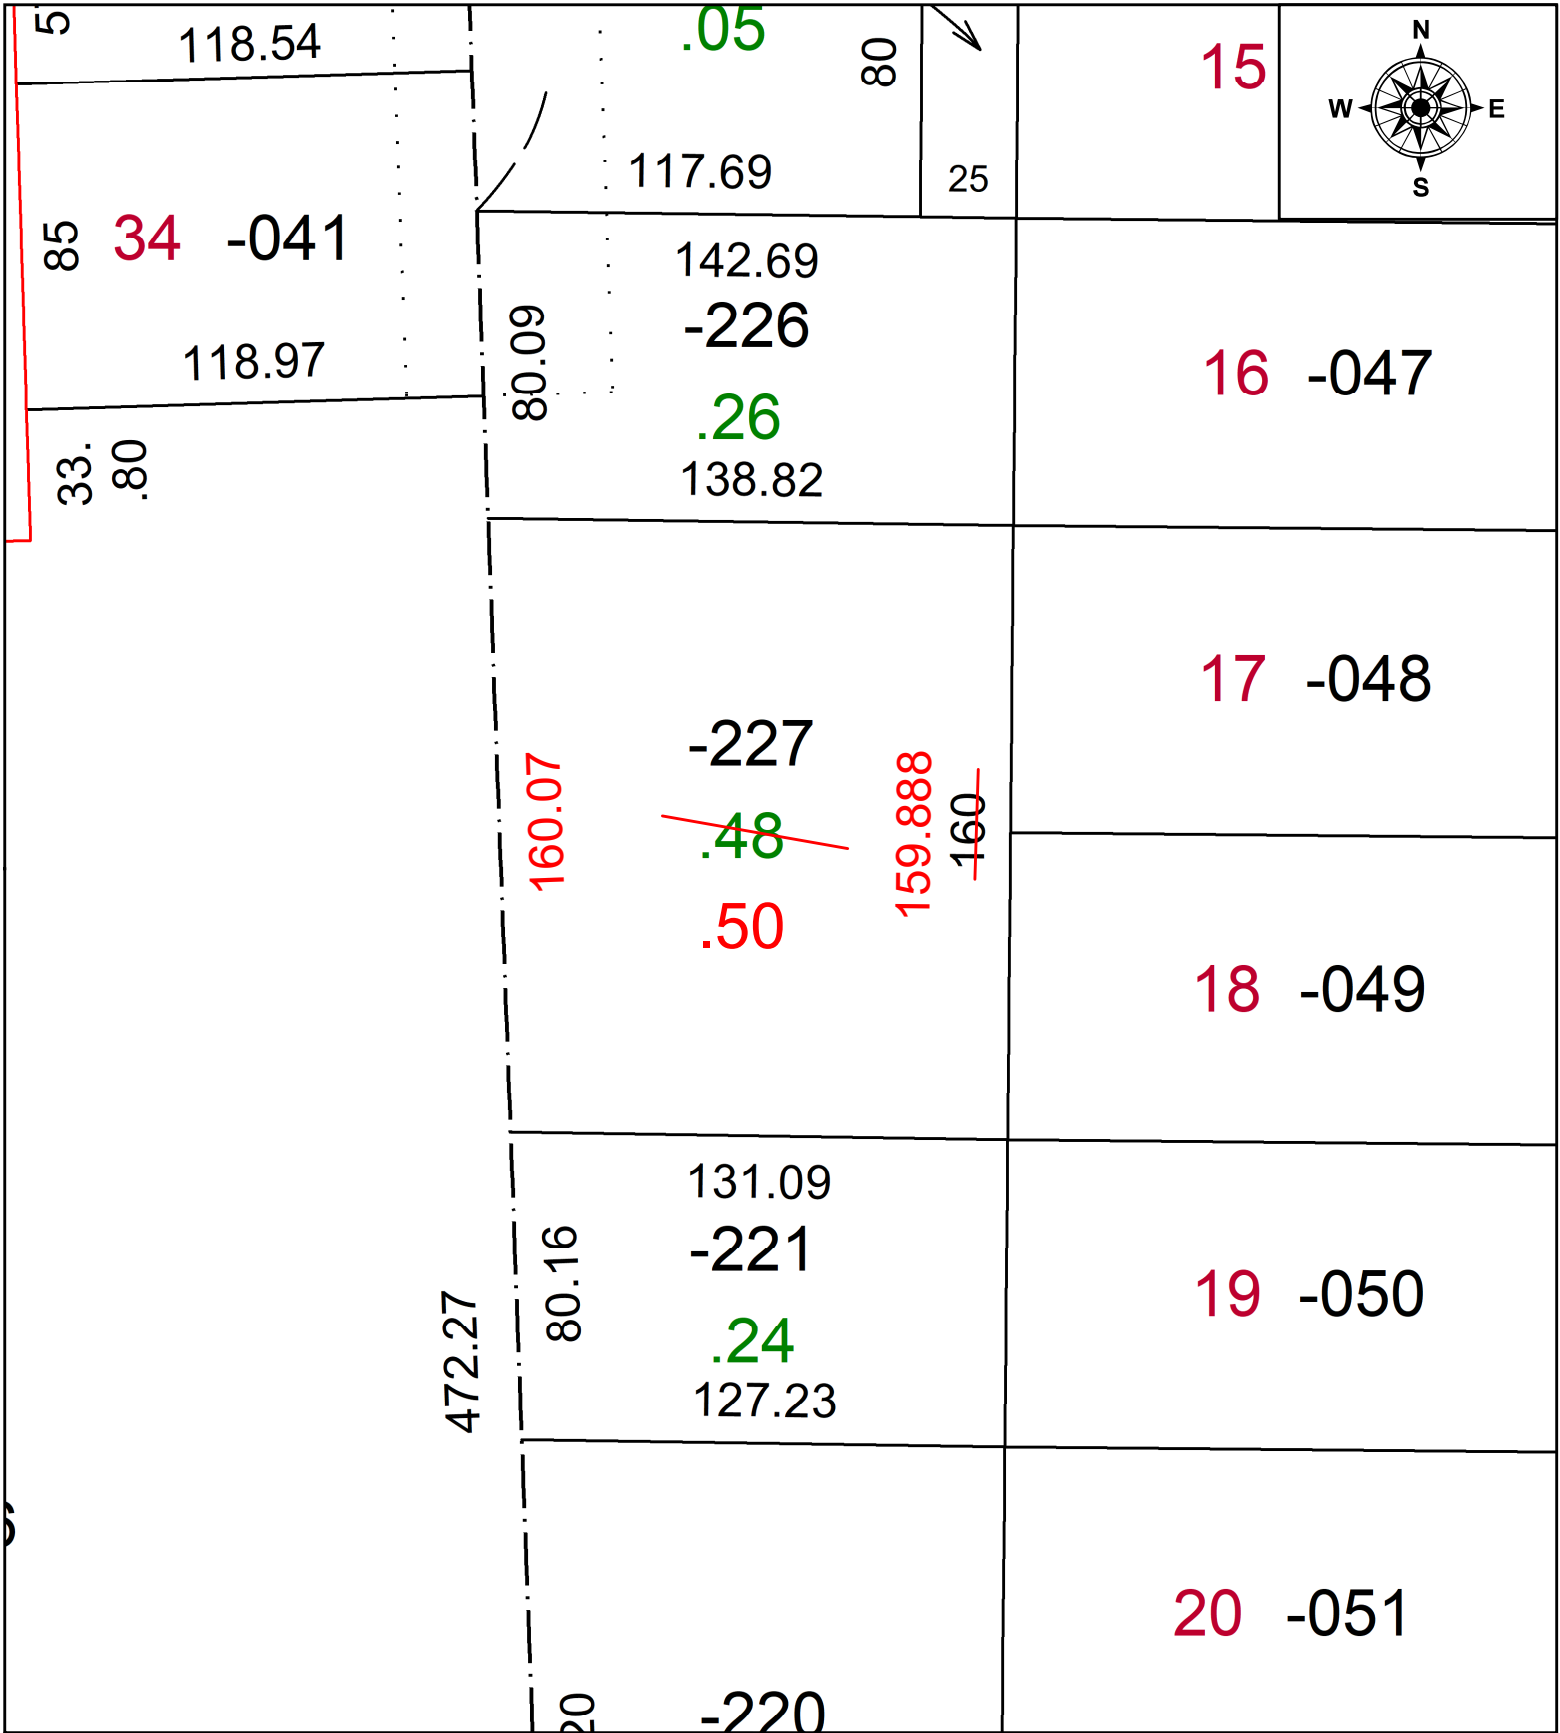

SPLITS/DEEDS PROCESSED
 LORAIN COUNTY TAX MAP DEPARTMENT
 226 MIDDLE AVE. ELYRIA, OH

SURVEYED BY: JOHN DeCHANT JR. SURVEY #: 50943
 CLOSURE: 1:81840
 MAP PAGE(S): 01-00-017
 APPROVED BY: DMA DATE: 7/17/2023
 SCALE: 1" = 50' PRIOR INSTRUMENT: D.V. 1100 PG. 319