
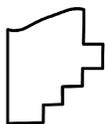


PARENT PARCEL: 04-00-014-107-024

CHILD PARCEL: 04-00-014-107-298 & -299

26-05115

STARTING POINT: AC CORR PER SURV BY MICHAEL P. SPELLACY

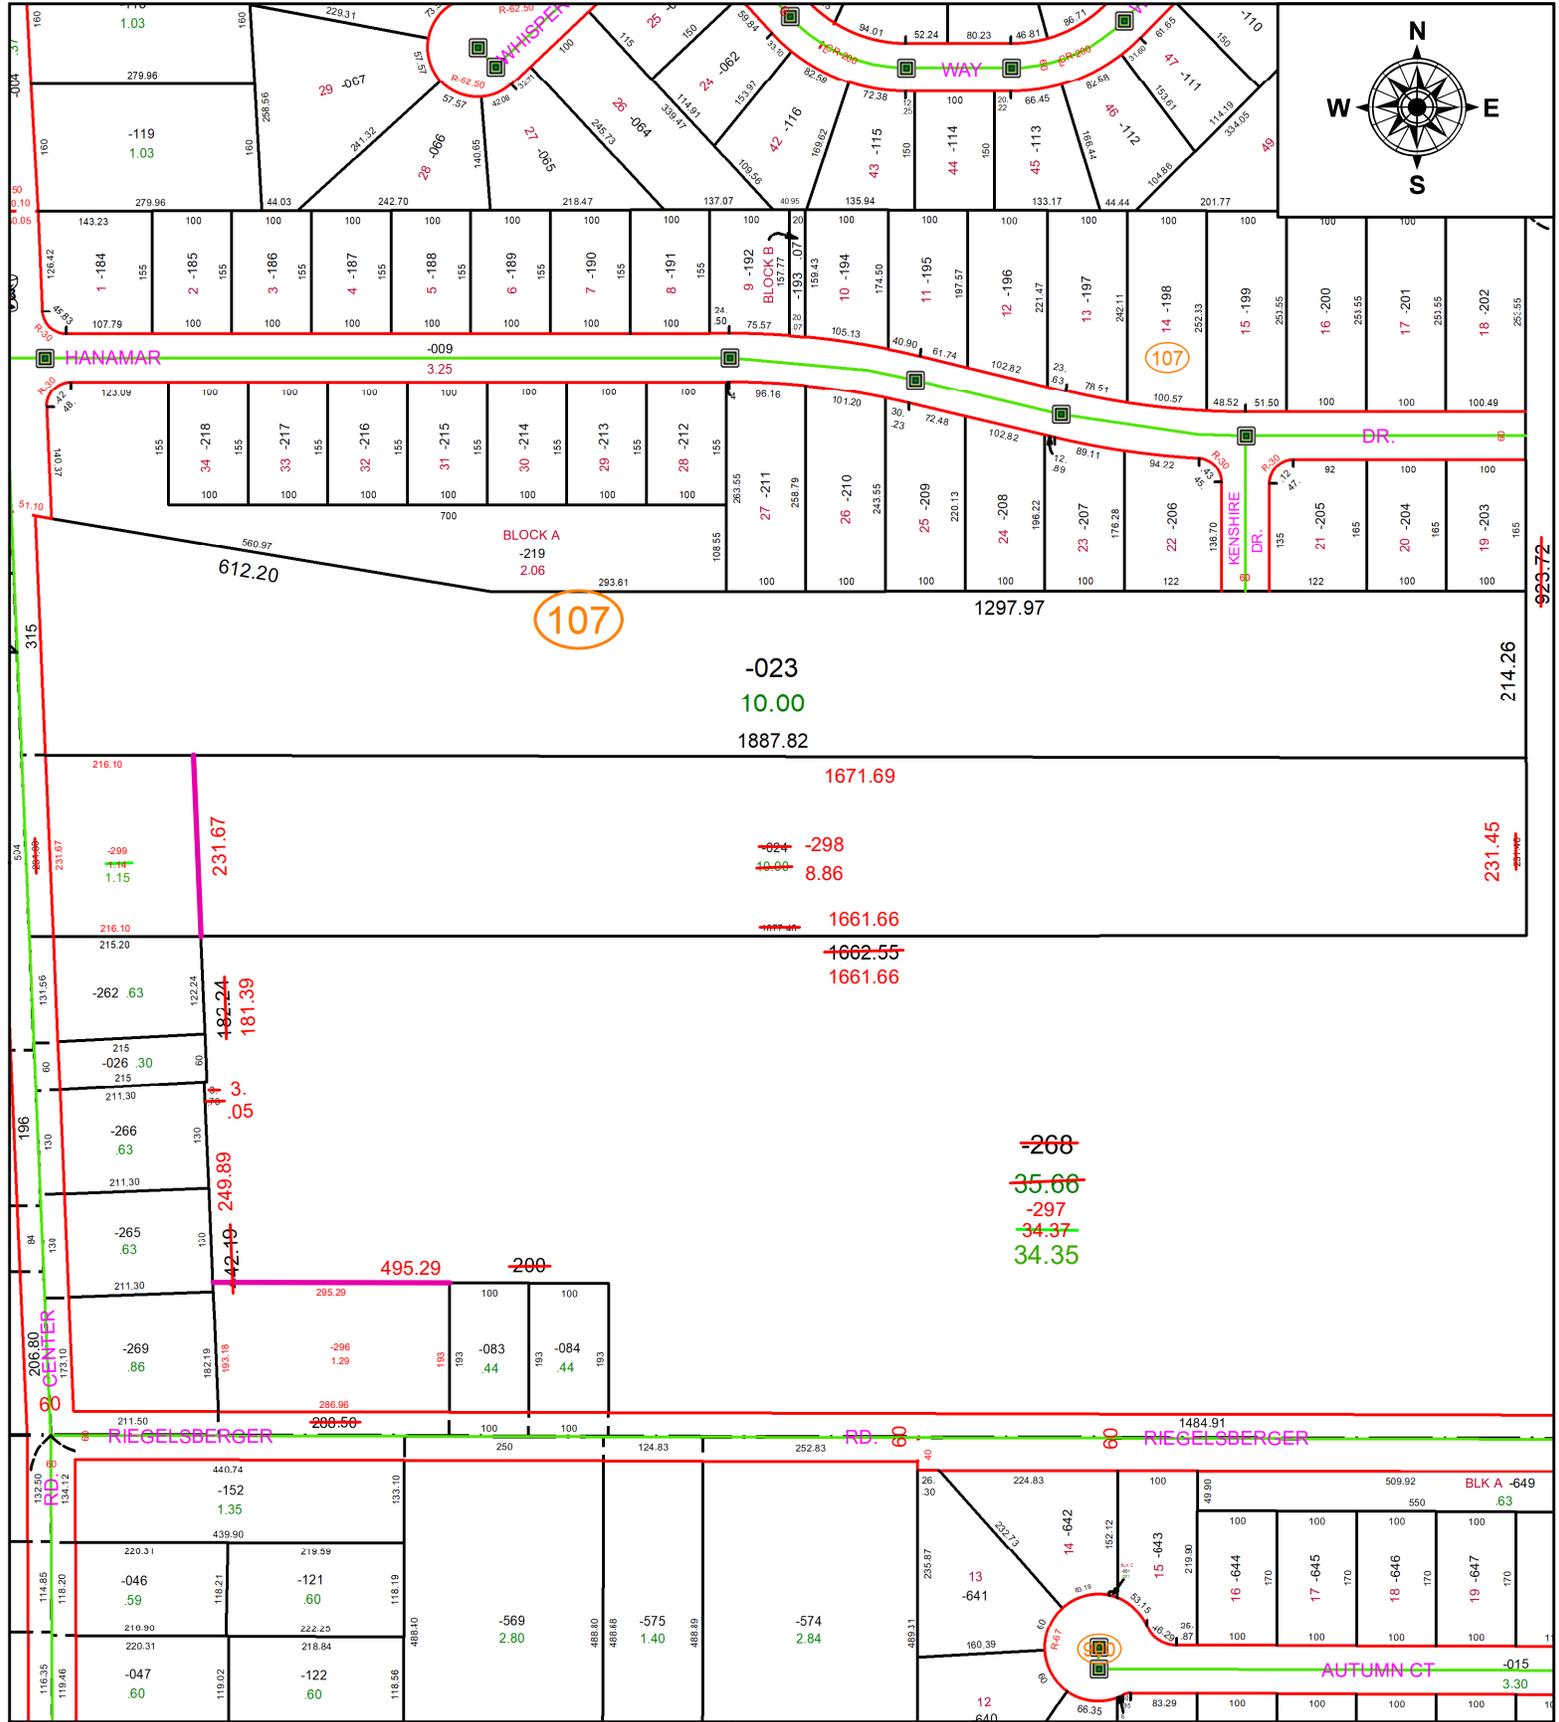

SPLITS/DEEDS PROCESSED
 LORAIN COUNTY TAX MAP DEPARTMENT
 226 MIDDLE AVE. ELYRIA, OH

SURVEYED BY: MICHAEL P. SPELLACY **SURV # 51640**
CLOSURE: 1: 1268732
MAP PAGE(S): 04-00-014
APPROVED BY: AC **DATE:** January 20, 2026
SCALE: 1 in = 240 ft **PRIOR INSTRUMENT:** 2001- 0732669