


PARENT PARCEL: 04-00-014-107-023

CHILD PARCEL: 04-00-014-107-300 & -301

STARTING POINT: AC CORR PER SURV BY MICHAEL P. SPELLACY

26-05116

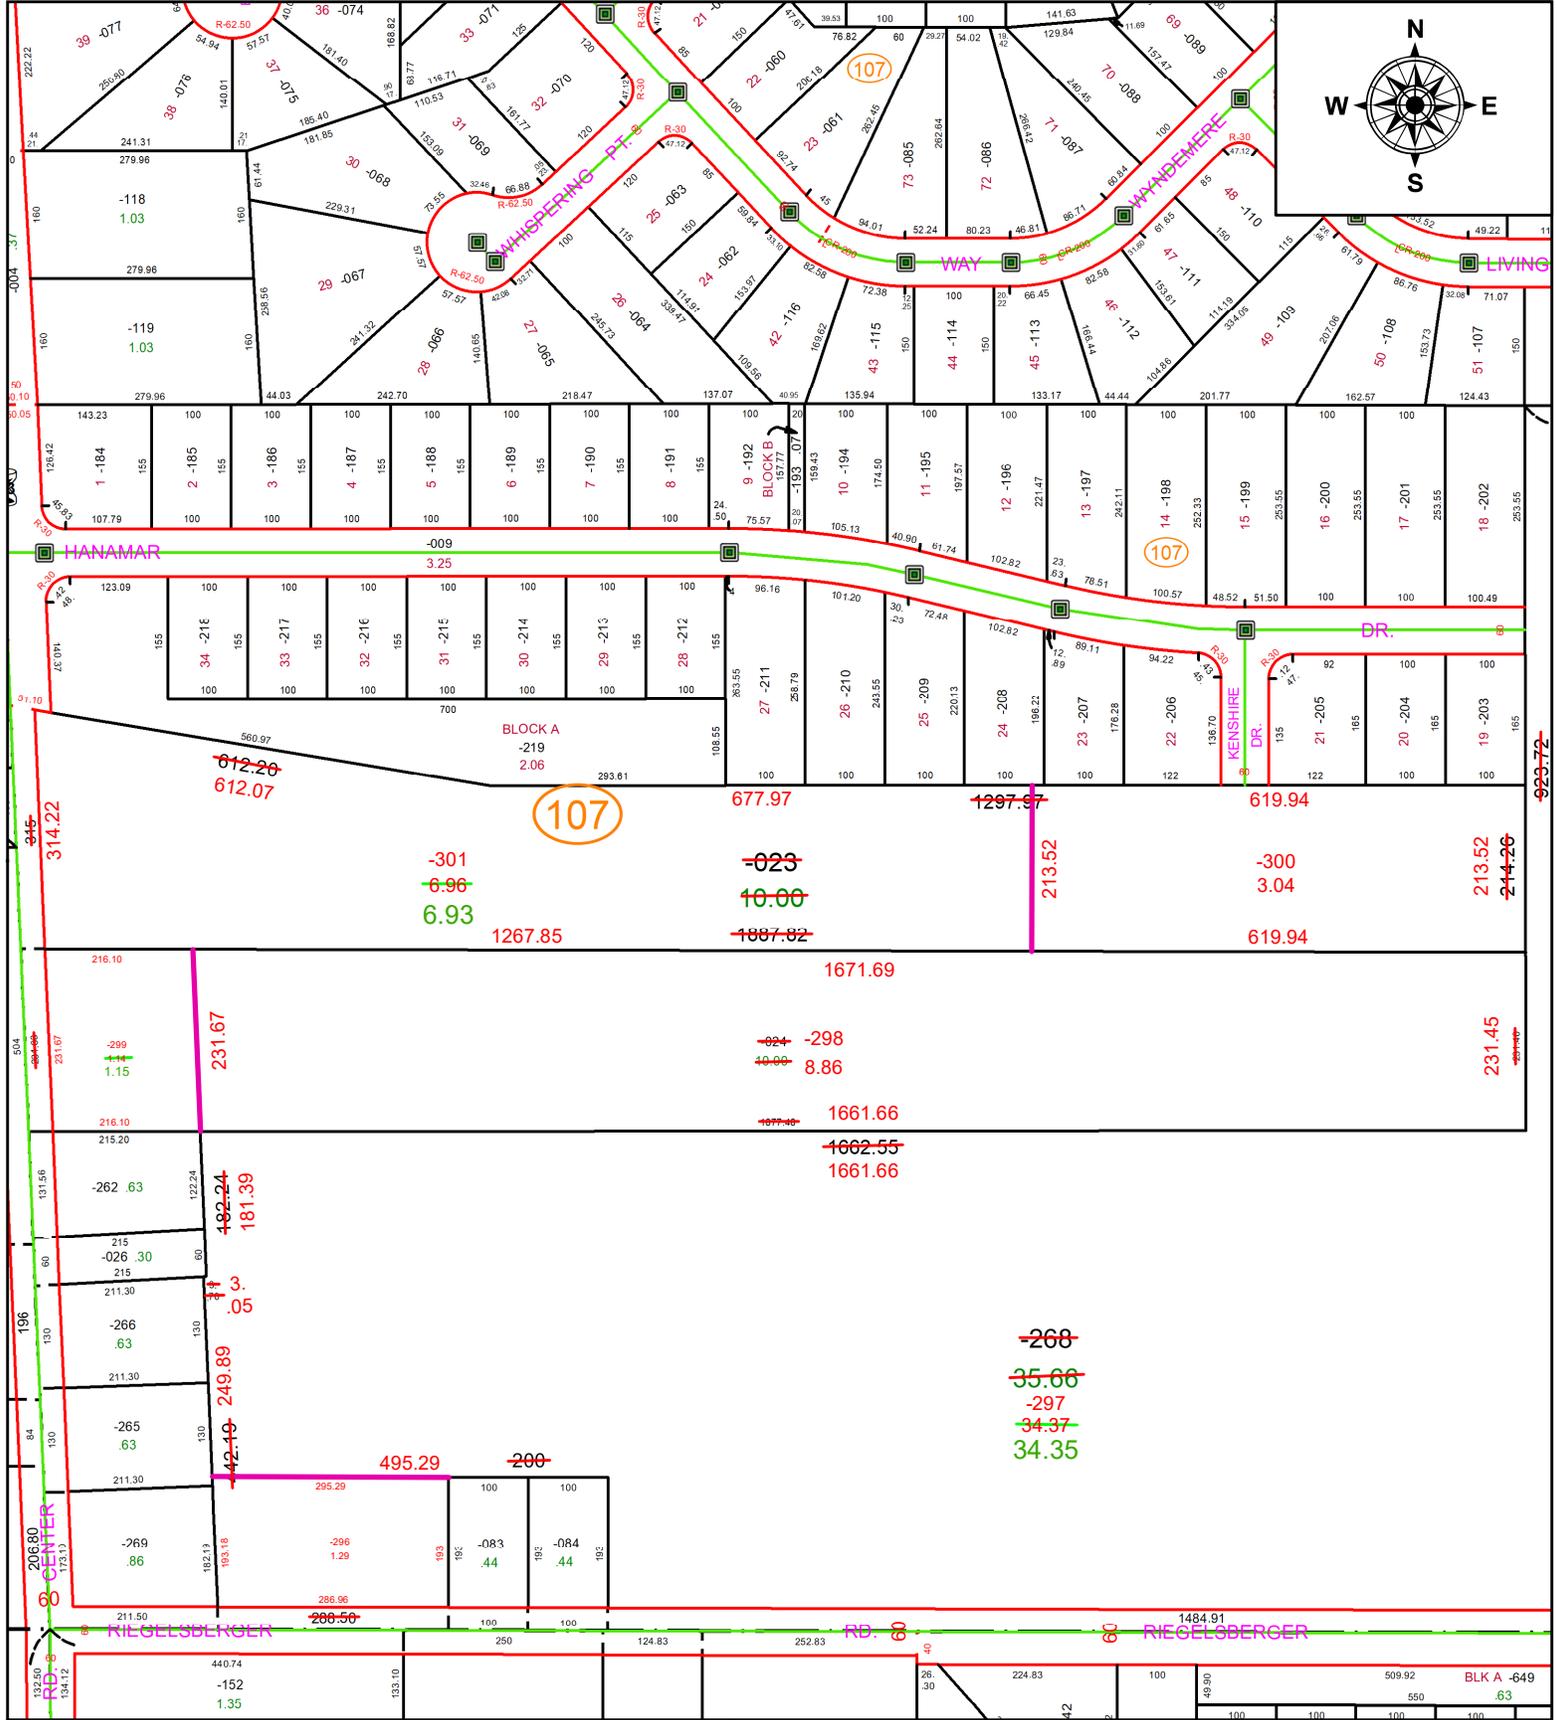

SPLITS/DEEDS PROCESSED
 LORAIN COUNTY TAX MAP DEPARTMENT
 226 MIDDLE AVE. ELYRIA, OH

SURVEYED BY: MICHAEL P. SPELLACY SURV # 51642
 CLOSURE: 1: INF
 MAP PAGE(S): 04-00-014
 APPROVED BY: AC DATE: January 20, 2026
 SCALE: 1 in = 240 ft PRIOR INSTRUMENT: 2022- 0872278