
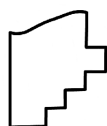


PARENT PARCEL: 03-00-075-104-001, 03-00-076-110-015, & -028

CHILD PARCEL: 03-00-076-110-030

STARTING POINT: COMBINATION PER DEED

23-05118-C

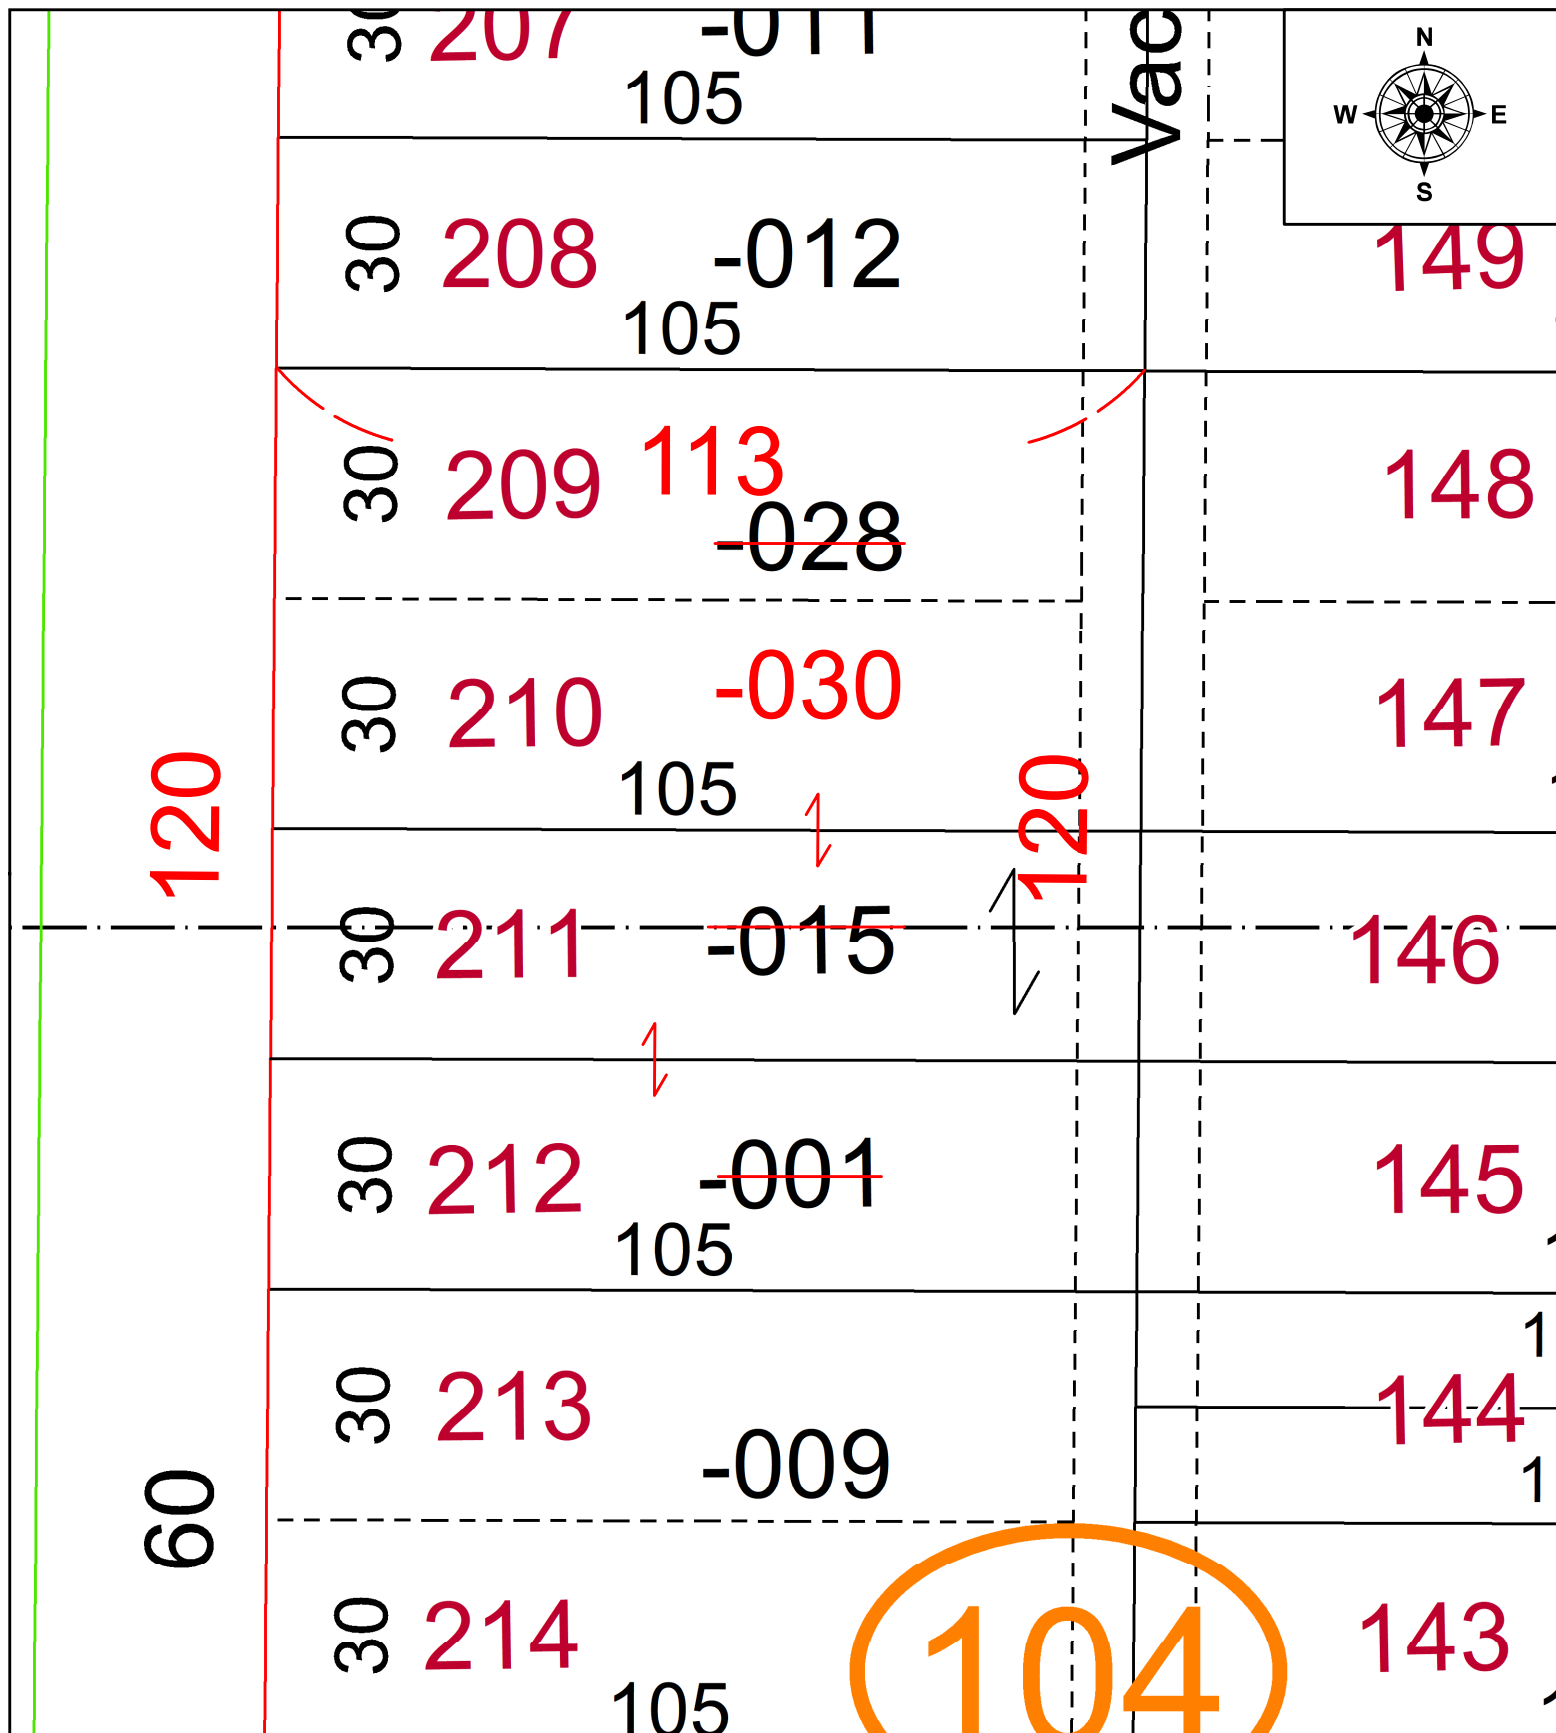

**SPLITS/DEEDS PROCESSED**  
 LORAIN COUNTY TAX MAP DEPARTMENT  
 226 MIDDLE AVE. ELYRIA, OH

SURVEYED BY: N/A SURV # N/A  
 CLOSURE: N/A  
 MAP PAGE(S): 03-00-075  
 APPROVED BY: AC DATE: July 18, 2023  
 SCALE: 1 in = 25 ft PRIOR INSTRUMENT: 2021- 0835081