
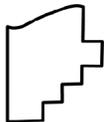


PARENT PARCEL: 05-00-001-000-297 & -407

CHILD PARCEL: 05-00-001-000-408

STARTING POINT: 1" I.P. FD. MON. BOX N.E. CORNER OF O.L. 1

26-05118

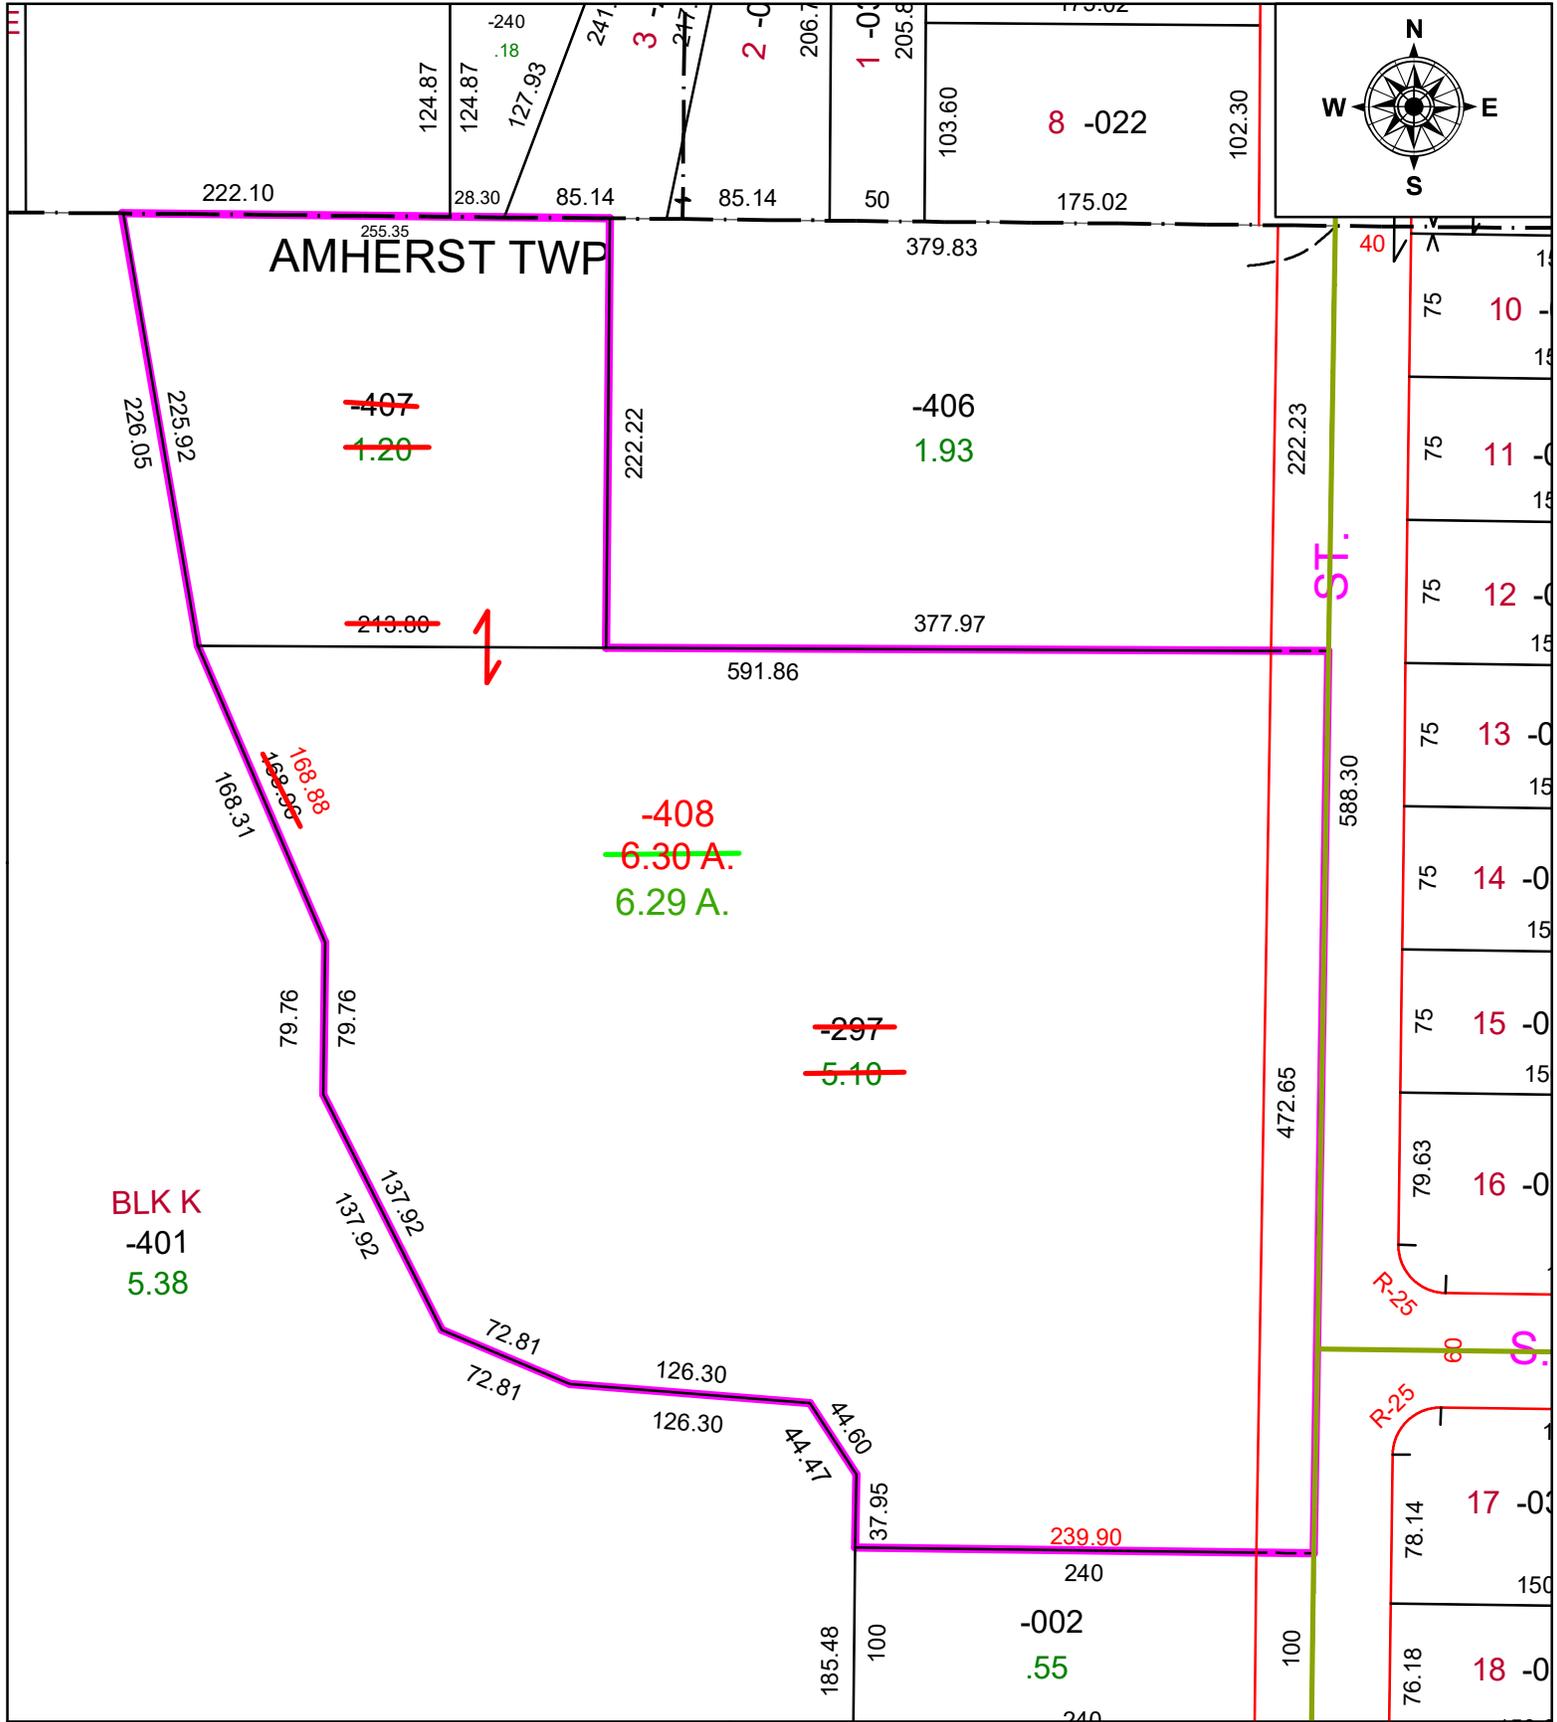

SPLITS/DEEDS PROCESSED
 LORAIN COUNTY TAX MAP DEPARTMENT
 226 MIDDLE AVE. ELYRIA, OH

SURVEYED BY: C. SOMMERS
 CLOSURE: 1:179468
 MAP PAGE(S): 05-00-001
 APPROVED BY: TJS DATE: 1/22/2026
 SCALE: 1" = 100' PRIOR INSTRUMENT: 2020-0778241