
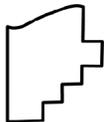


PARENT PARCEL: 03-00-038-119-038 & -039 & -040 & -041 & -042

CHILD PARCEL: 03-00-038-119-070 & -071 & -072

26-05119

STARTING POINTS SOUTHERNLY CORNER OF SUBLot 131, 210 FEET NORTH OF FERNDALE AVE

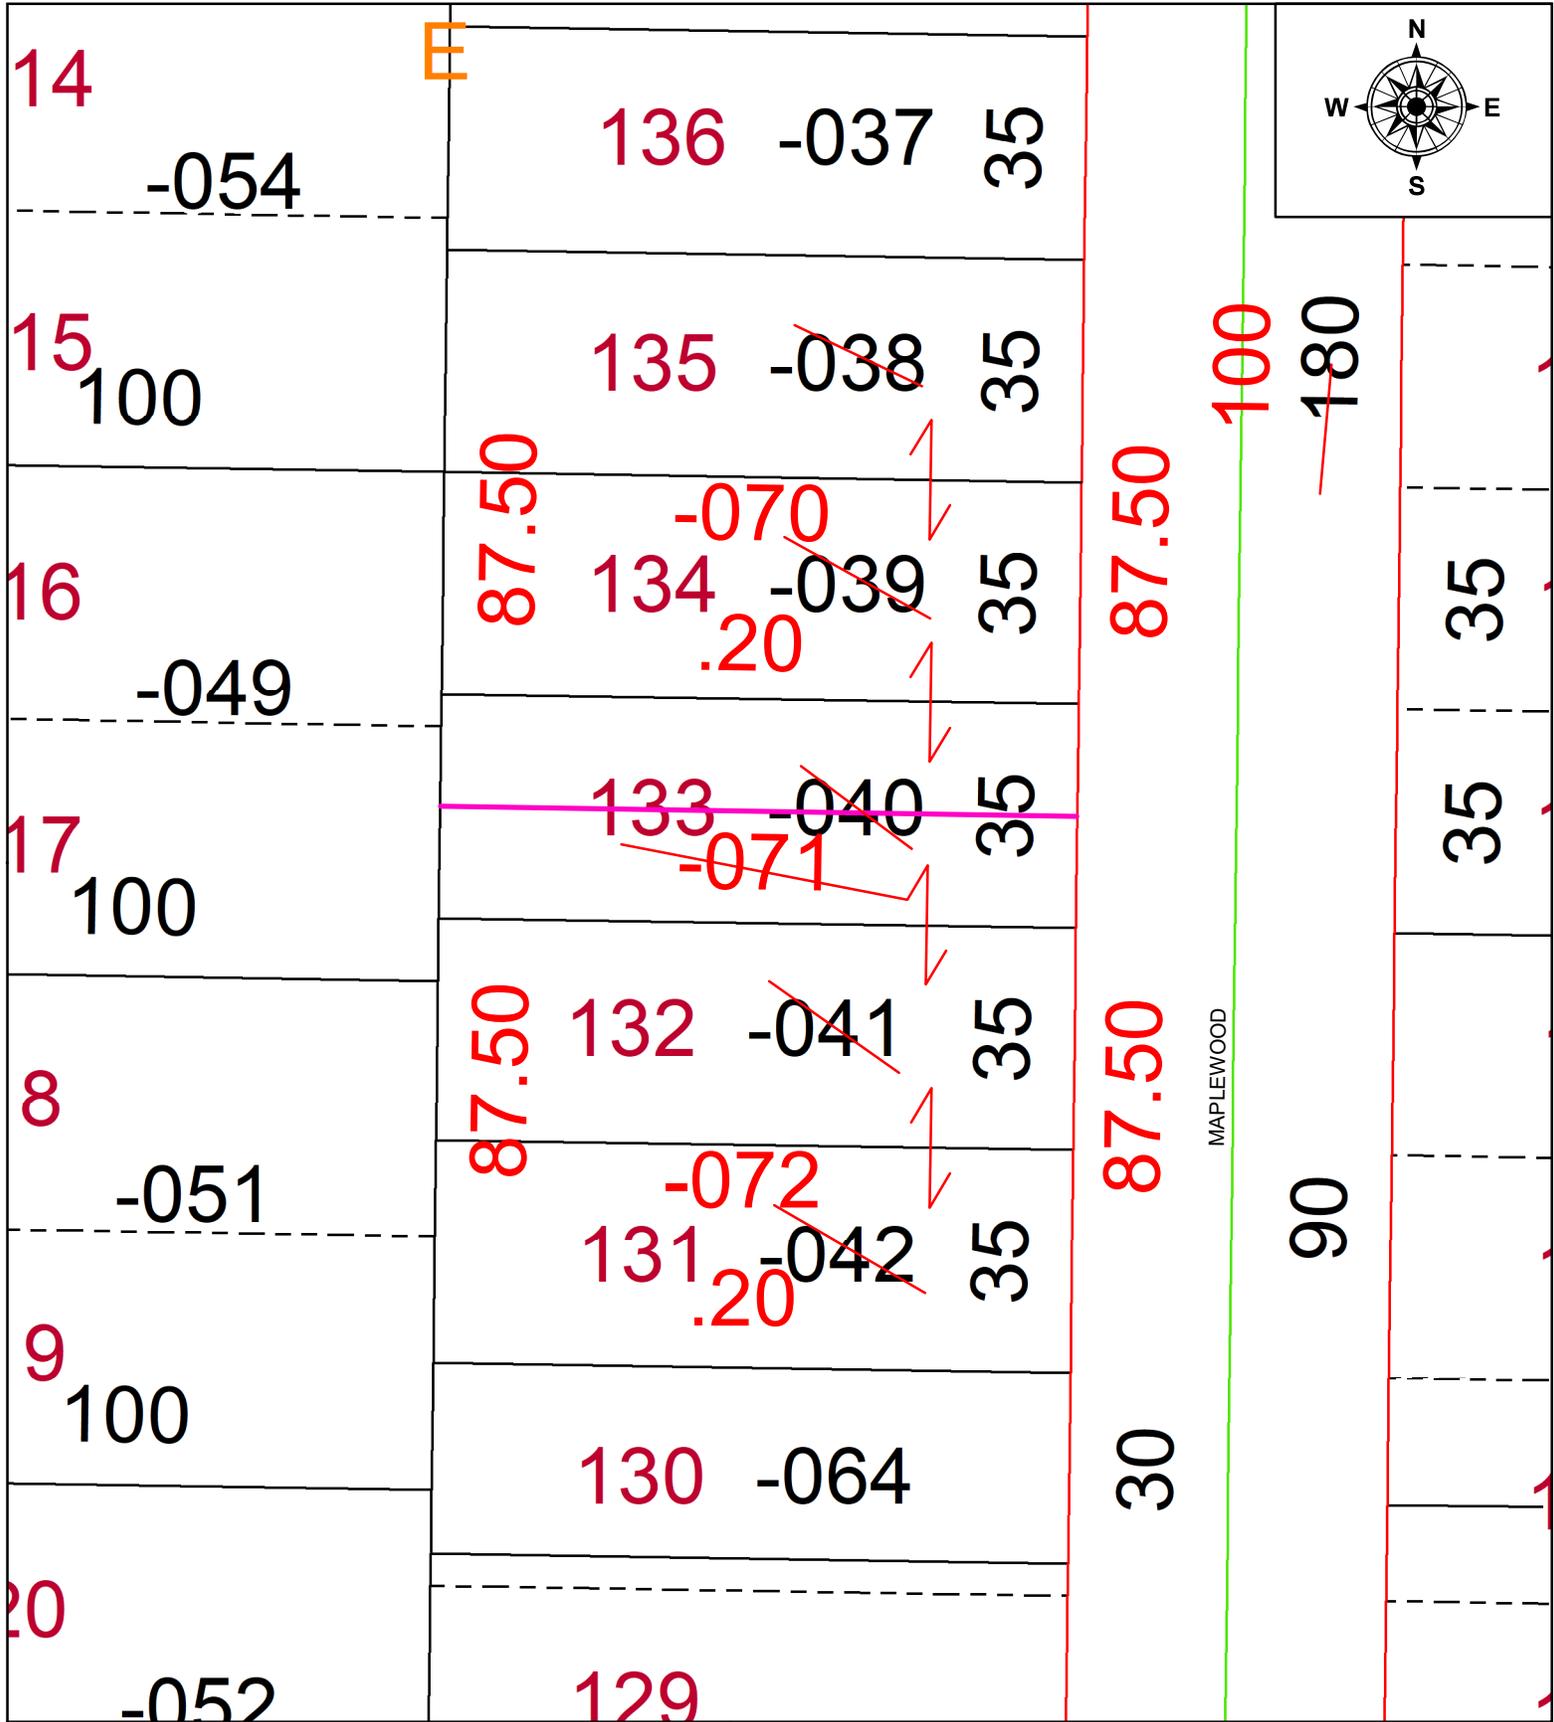

SPLITS/DEEDS PROCESSED
 LORAIN COUNTY TAX MAP DEPARTMENT
 226 MIDDLE AVE. ELYRIA, OH

SURVEYED BY: JAMES RESAR SURVEY #: 51644
 CLOSURE: 1: INF
 MAP PAGE(S): 03-00-038
 APPROVED BY: BB DATE: 1/22/2026
 SCALE: 1" = 30' PRIOR INSTRUMENT: #19990658151