
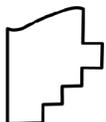


PARENT PARCEL: 01-00-002-112-003 THRU -006, & -009

CHILD PARCEL: 01-00-002-112-011

26-05120

STARTING POINT: NORTHWESTERLY CORNER OF S/L 1724 VERMILION ON THE LAKE SUB. NO. 01 IN PV 10/18

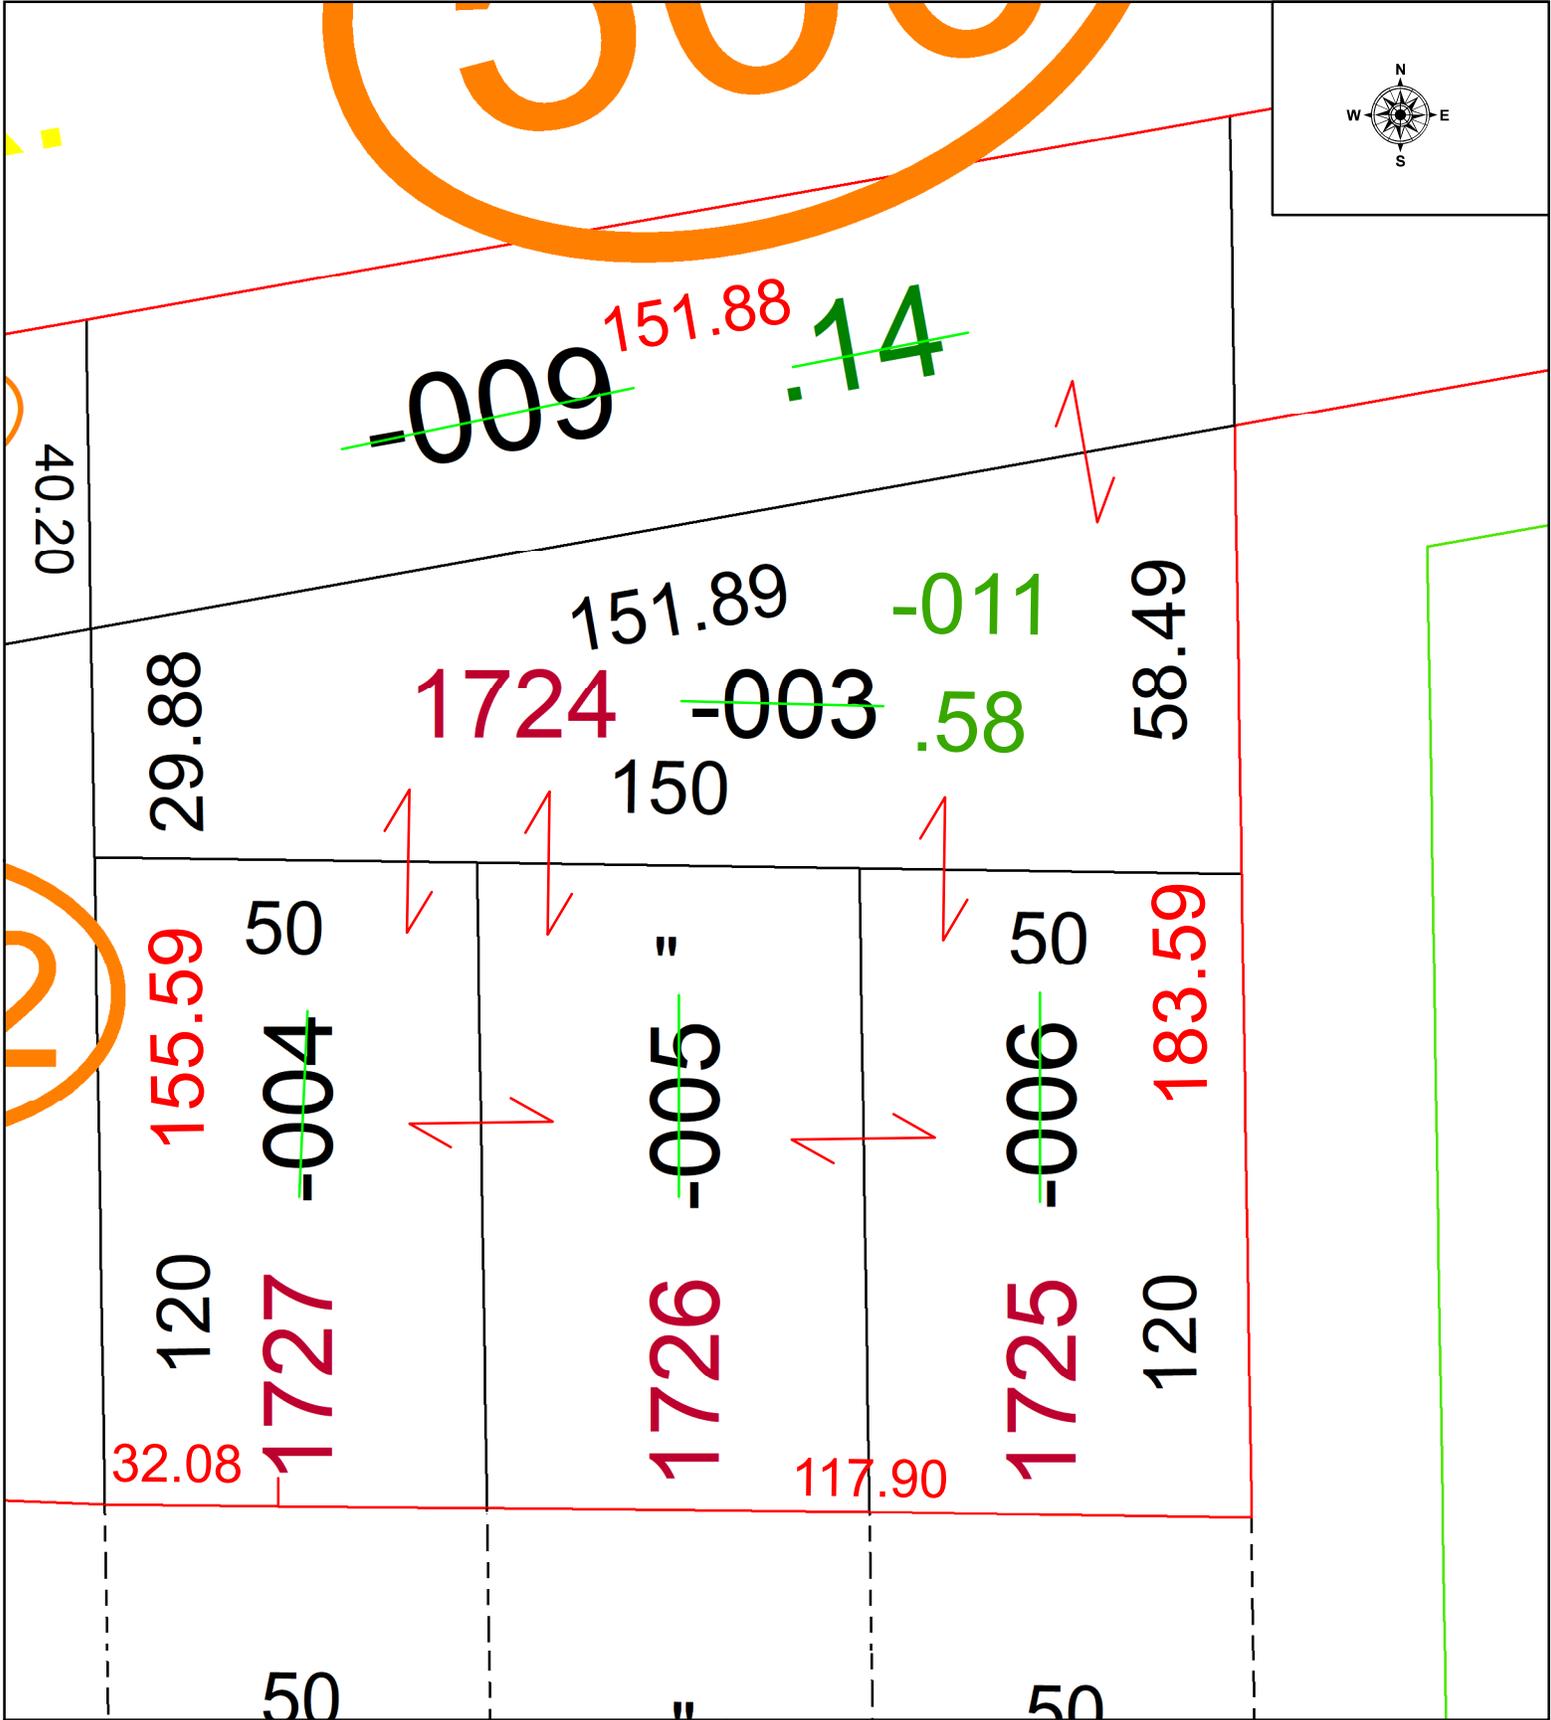

SPLITS/DEEDS PROCESSED
 LORAIN COUNTY TAX MAP DEPARTMENT
 226 MIDDLE AVE. ELYRIA, OH

SURVEYED BY: JOHN DECHANT JR SURVEY # 51643
 CLOSURE: !: 70229
 MAP PAGE(S): 01-00-002
 APPROVED BY: WRZ DATE: 1/21/2026
 SCALE: 1" = 25 PRIOR INSTRUMENT: #2025-0073053