
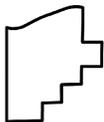
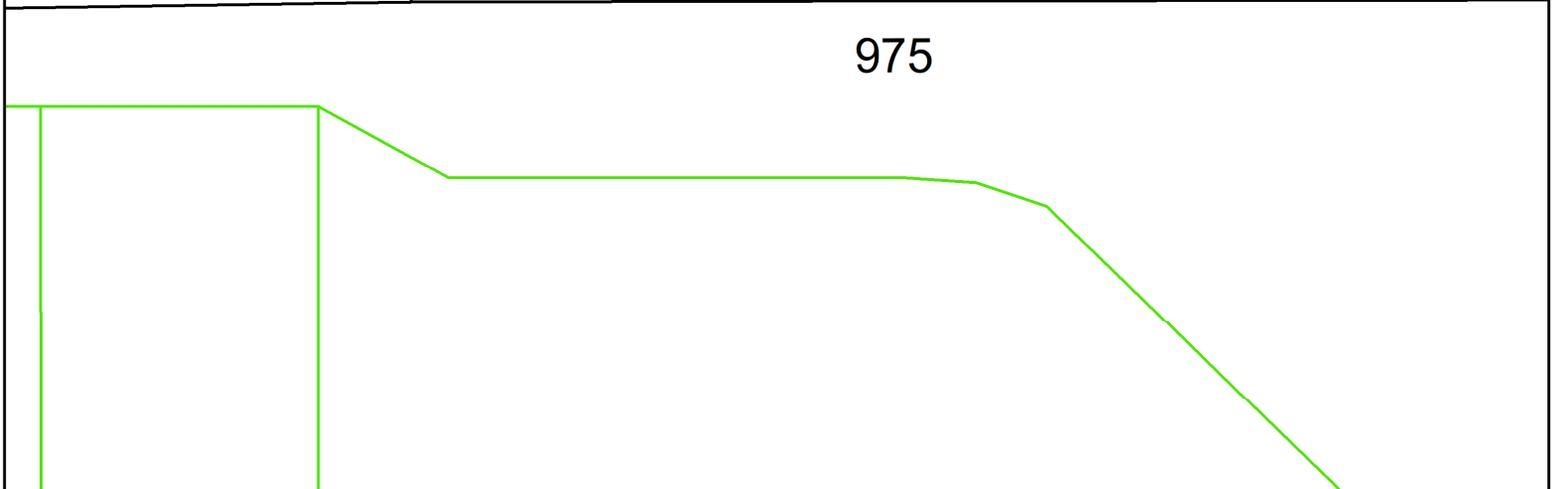


PARENT PARCEL: 15-00-035-000-313

CHILD PARCEL: 15-00-035-000-317 & -318

STARTING POINT: C/L OF FRENCH CREEK AND ABBE RD

26-05122

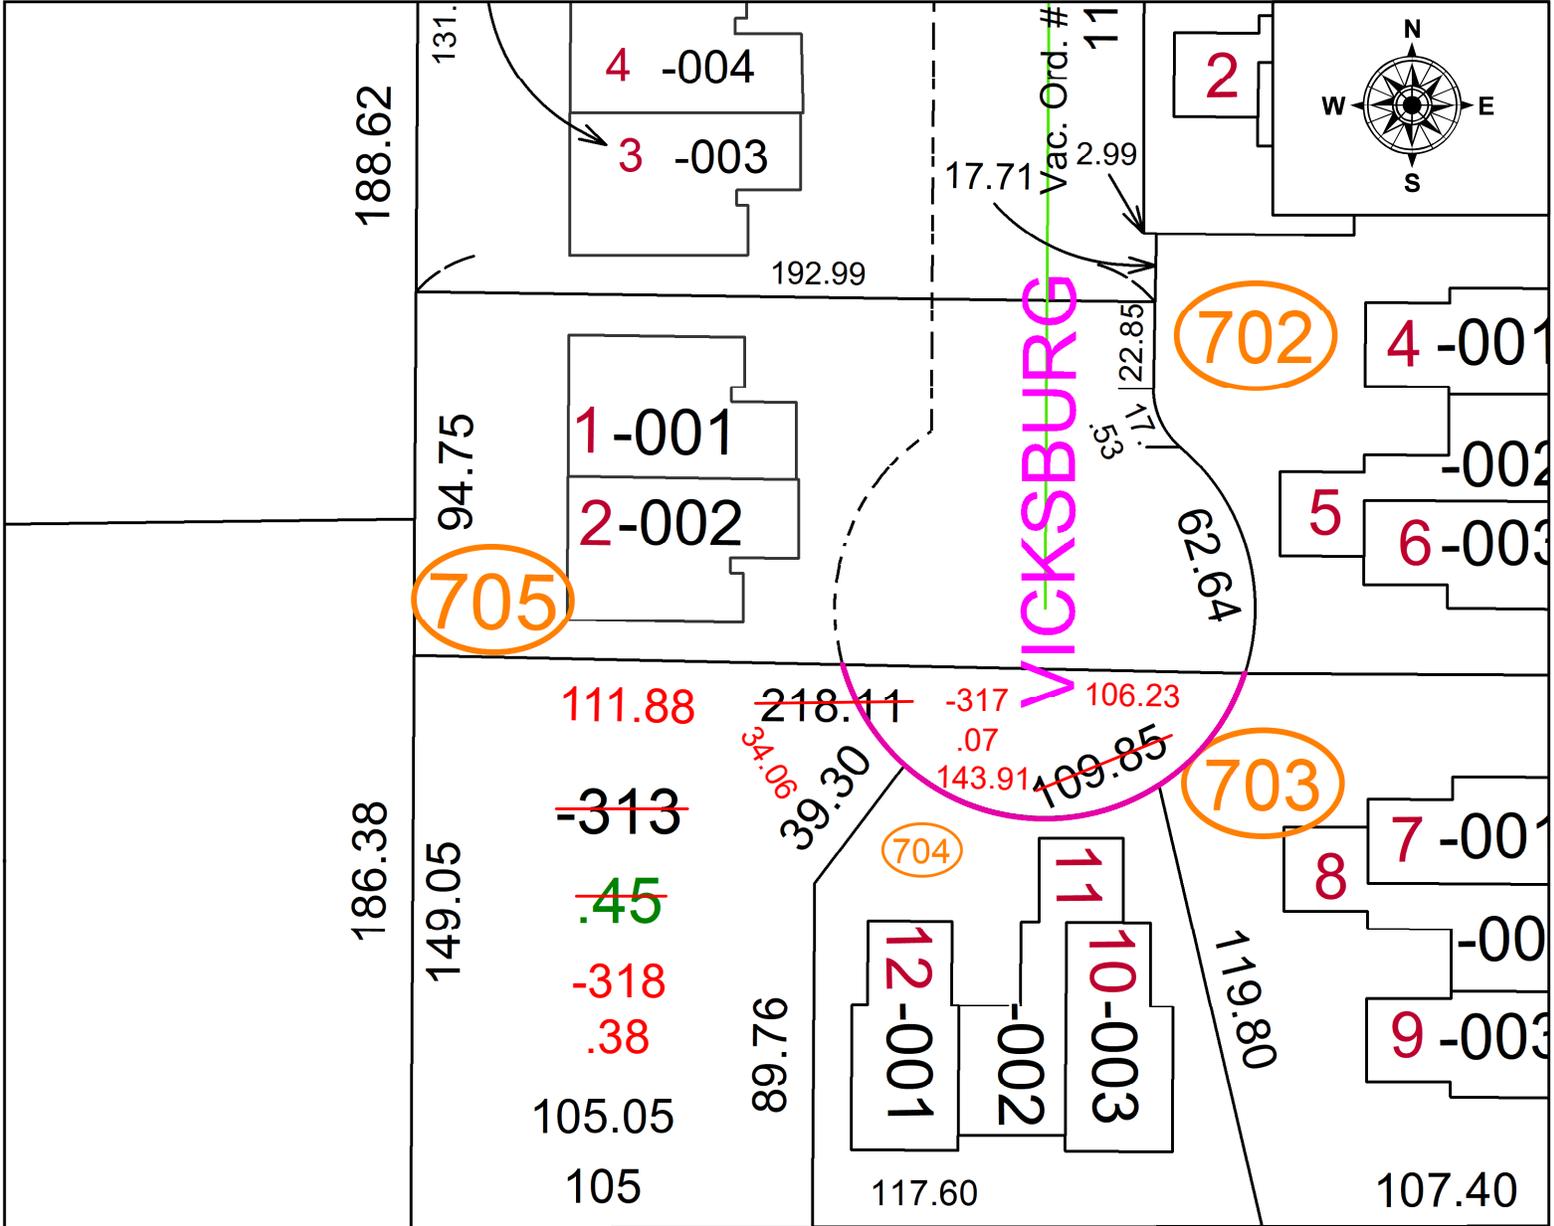

SPLITS/DEEDS PROCESSED
 LORAIN COUNTY TAX MAP DEPARTMENT
 226 MIDDLE AVE. ELYRIA, OH

SURVEYED BY: THOMAS A. SIMON SURV # 51648
 CLOSURE: 1: INF
 MAP PAGE(S): 15-00-035
 APPROVED BY: AC DATE: February 03, 2026
 SCALE: 1 in = 50 ft PRIOR INSTRUMENT: 2024- 0005181