


PARENT PARCEL: 07-00-026-102-007, -022 & -023

CHILD PARCEL: **AC. CORR. PER SURVEY**

STARTING POINT: C/L OF AVON BELDON RD. & SUGAR RIDGE DR.

23-05124-A

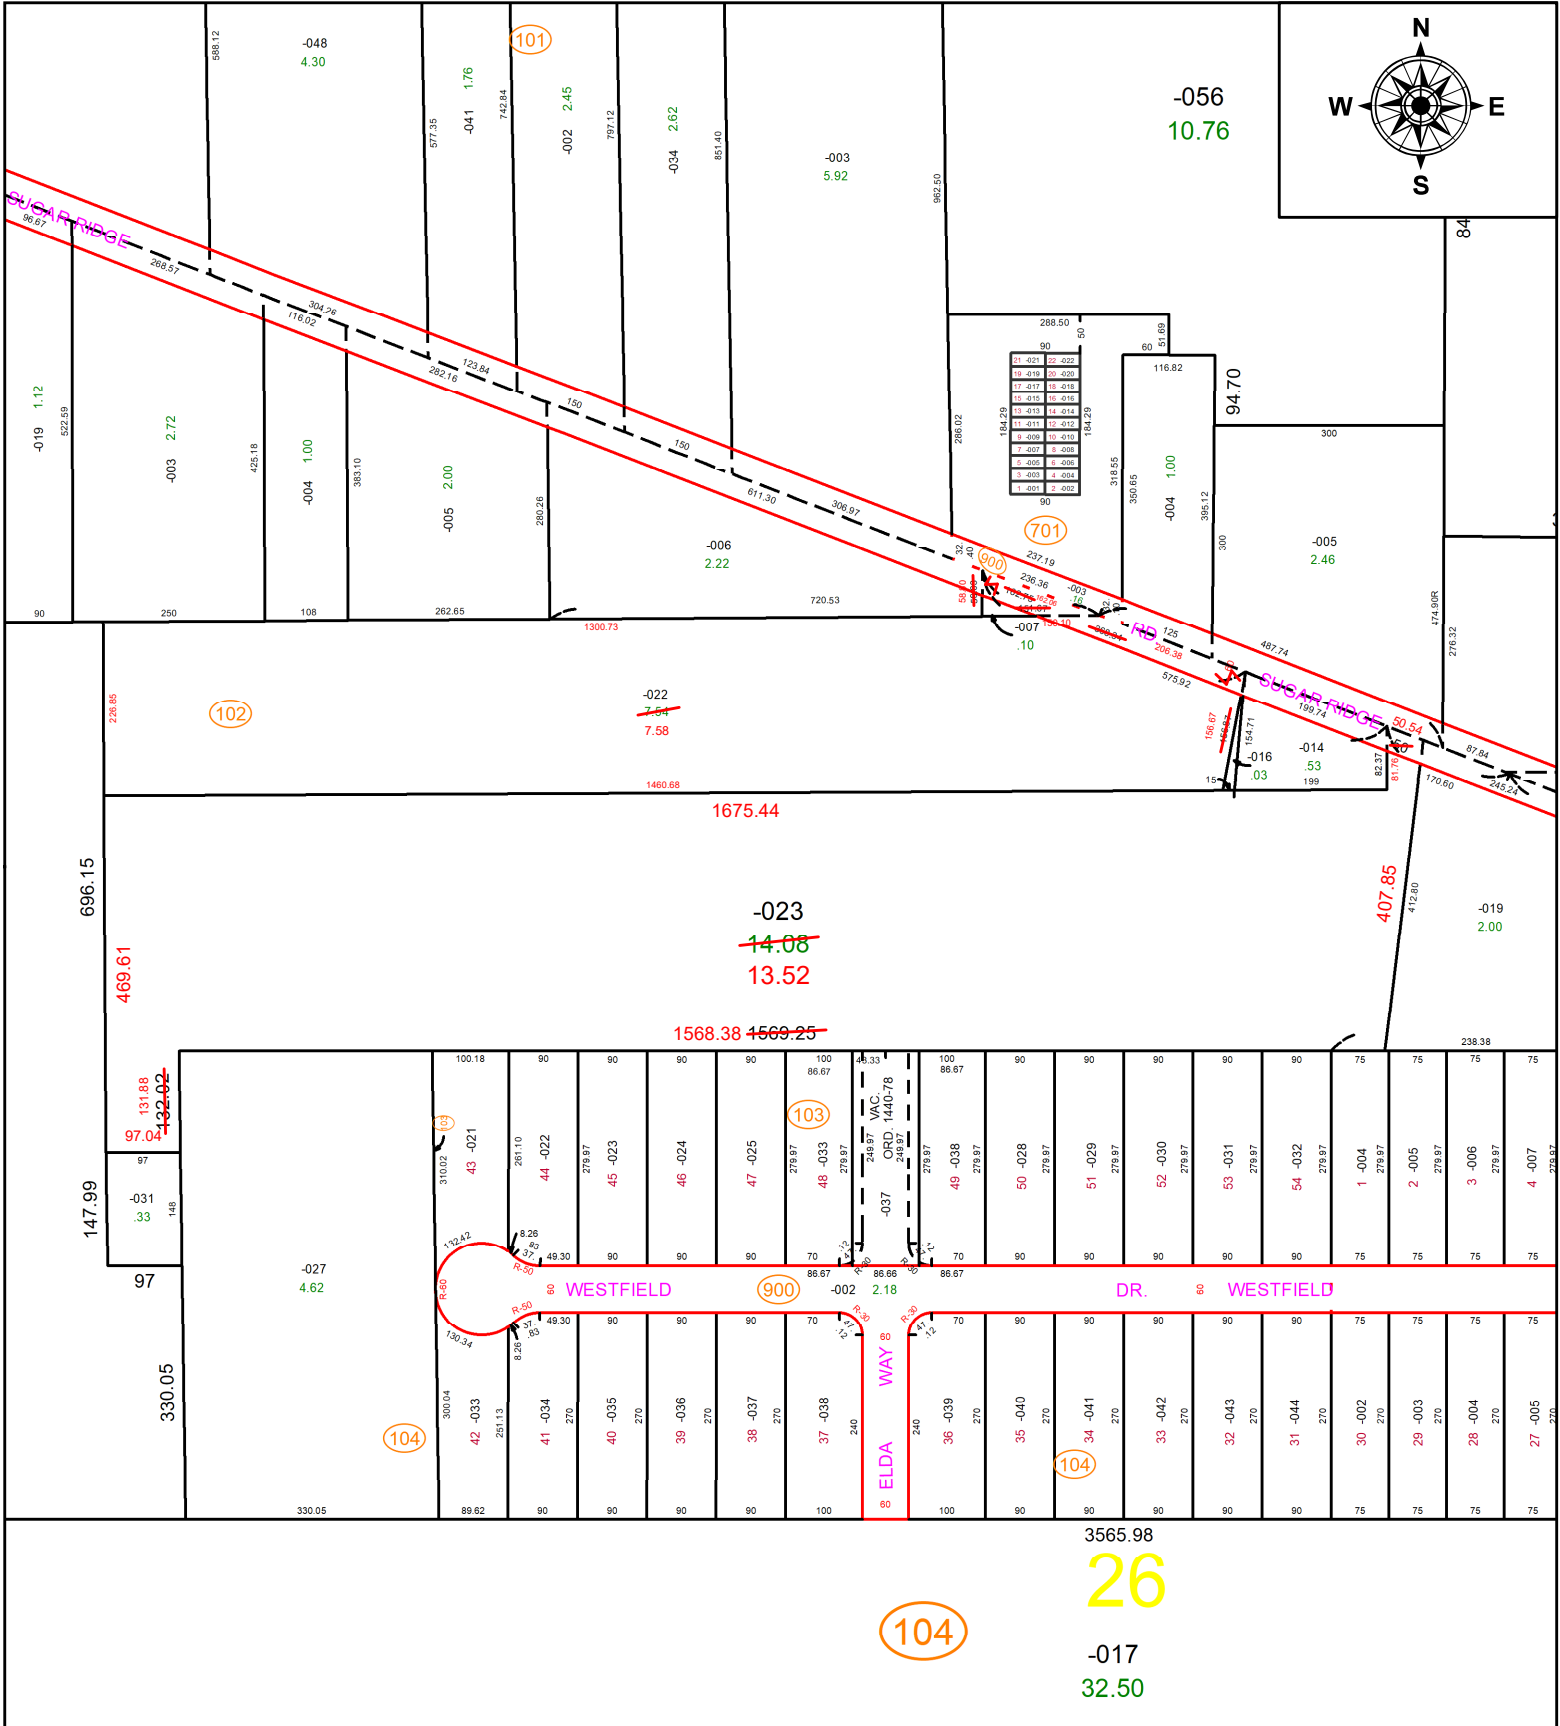

**SPLITS/DEEDS PROCESSED**  
 LORAIN COUNTY TAX MAP DEPARTMENT  
 226 MIDDLE AVE. ELYRIA, OH

**SURVEYED BY:** RICHARD THOMPSON JR. **SURVEY #:** 50954  
**CLOSURE:** 1:556573  
**MAP PAGE(S):** 07-00-026  
**APPROVED BY:** DMA **DATE:** 7/28/2023  
**SCALE:** 1" = 250' **PRIOR INSTRUMENT:** 2023-0903877