




PARENT PARCEL: 01-00-027-000-090
CHILD PARCEL: 01-00-027-000-091, -092, & -093
STARTING POINT: C/L OF COOPER FOSTER PARK RD AND BAUMHART RD

26-05124

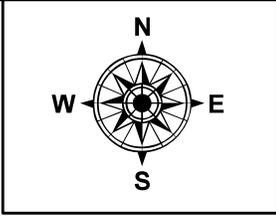

1422.94

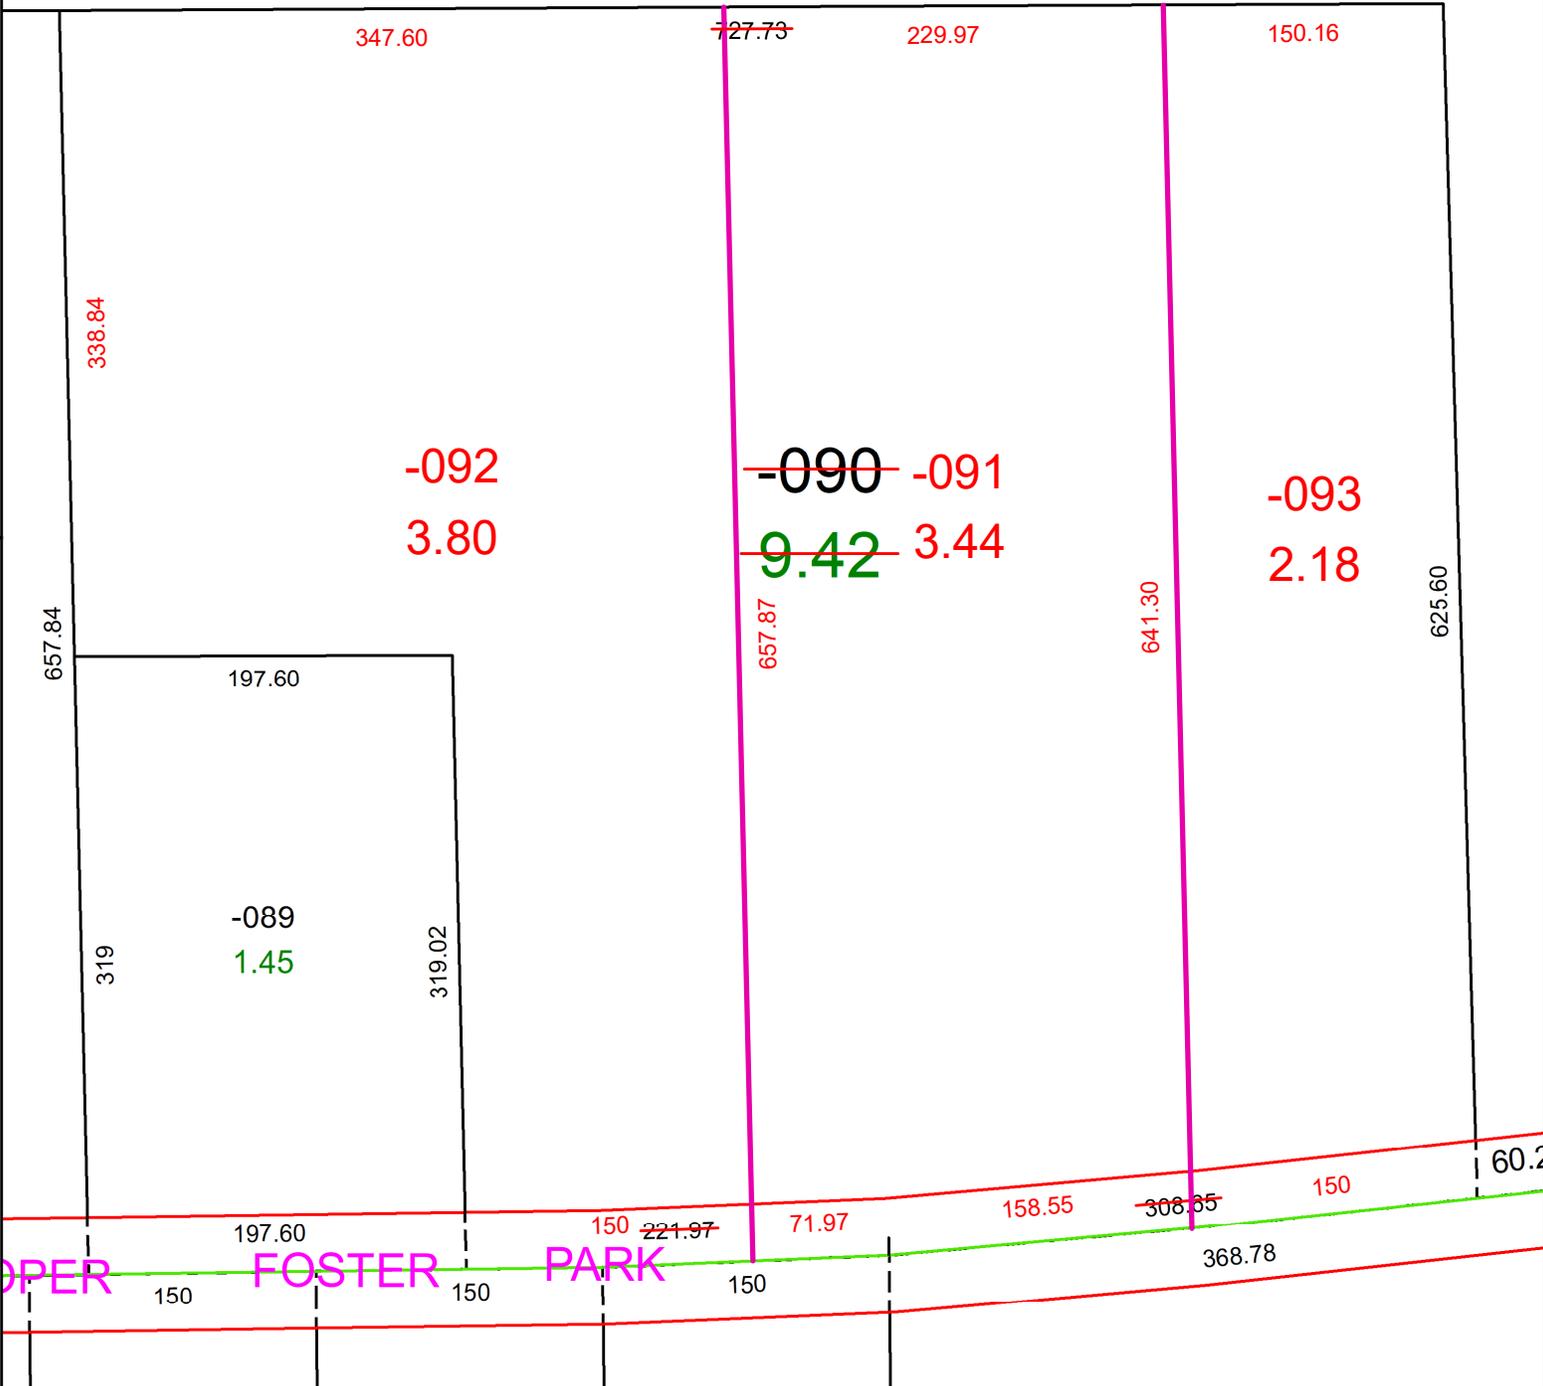

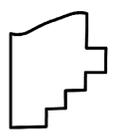
SPLITS/DEEDS PROCESSED
LORAIN COUNTY TAX MAP DEPARTMENT
226 MIDDLE AVE. ELYRIA, OH

SURVEYED BY: TIMOTHY D. HOZALSKI SURV # 51654
CLOSURE: 1: 583606
MAP PAGE(S): 01-00-027
APPROVED BY: AC DATE: February 18, 2026
SCALE: 1 in = 100 ft PRIOR INSTRUMENT: 2025- 0073488