
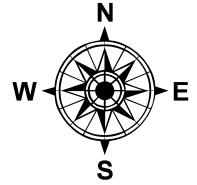


PARENT PARCEL: 03-00-037-114-065

CHILD PARCEL: MAP CORR. ADDING VAC. ORD. # 78-83 OF FERNDALE AVE.

STARTING POINT: N/A

23-05127-V

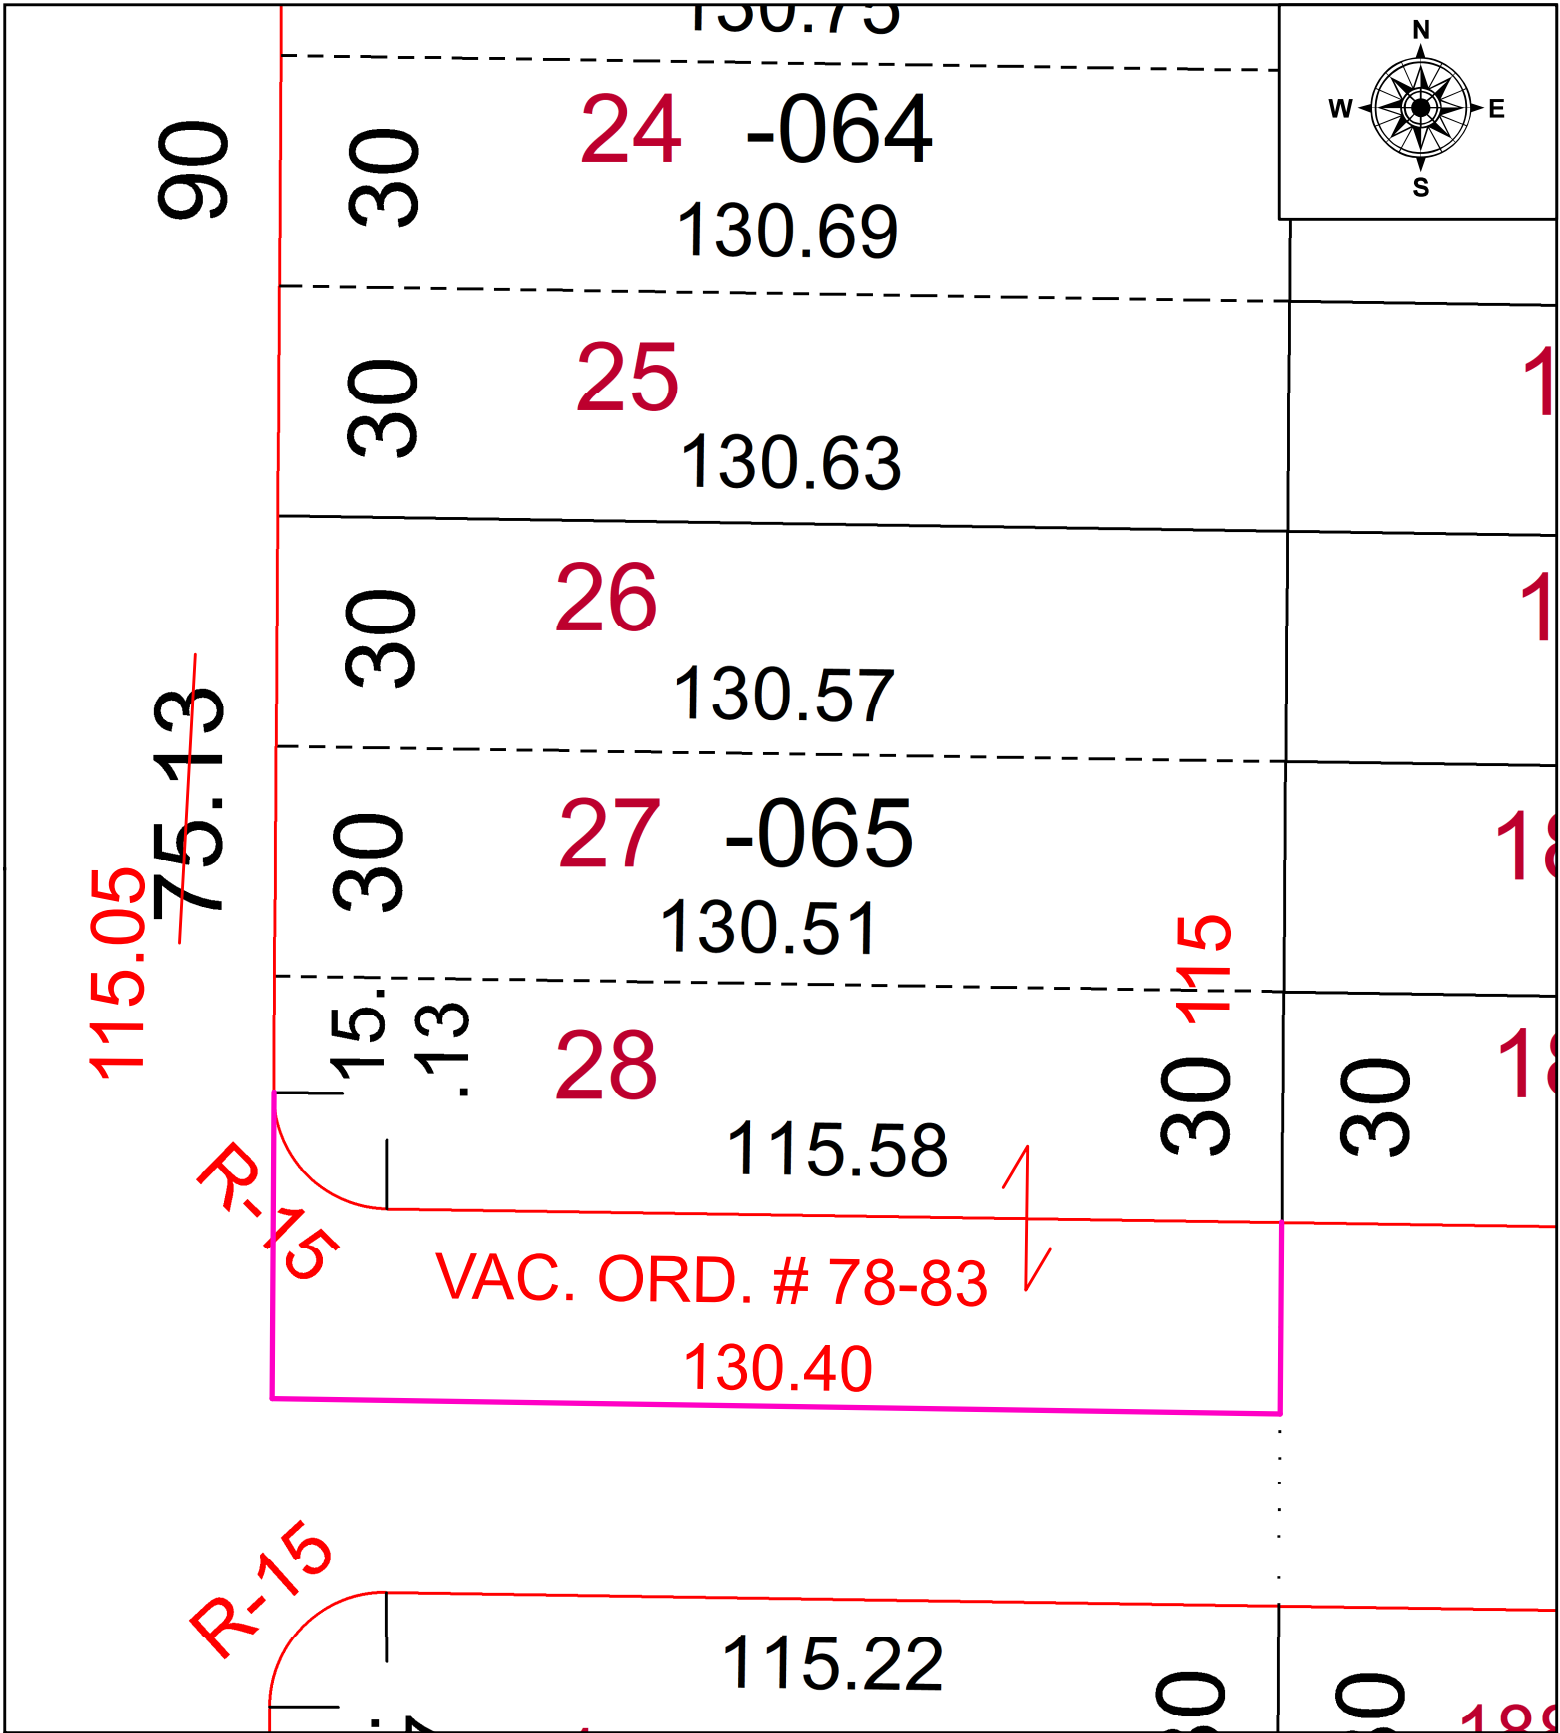

**SPLITS/DEEDS PROCESSED**  
 LORAIN COUNTY TAX MAP DEPARTMENT  
 226 MIDDLE AVE. ELYRIA, OH

SURVEYED BY: N/A SURVEY #: N/A  
 CLOSURE: N/A  
 MAP PAGE(S): 03-00-037  
 APPROVED BY: DMA DATE: 8/3/2023  
 SCALE: 1" = 25' PRIOR INSTRUMENT: 2021-0812600