
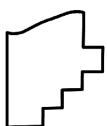


PARENT PARCEL: 03-00-037-117-060

CHILD PARCEL: N/A

STARTING POINT: VACATION FOR FERNDALVE AVE PER ORD 78-83

23-05129-V

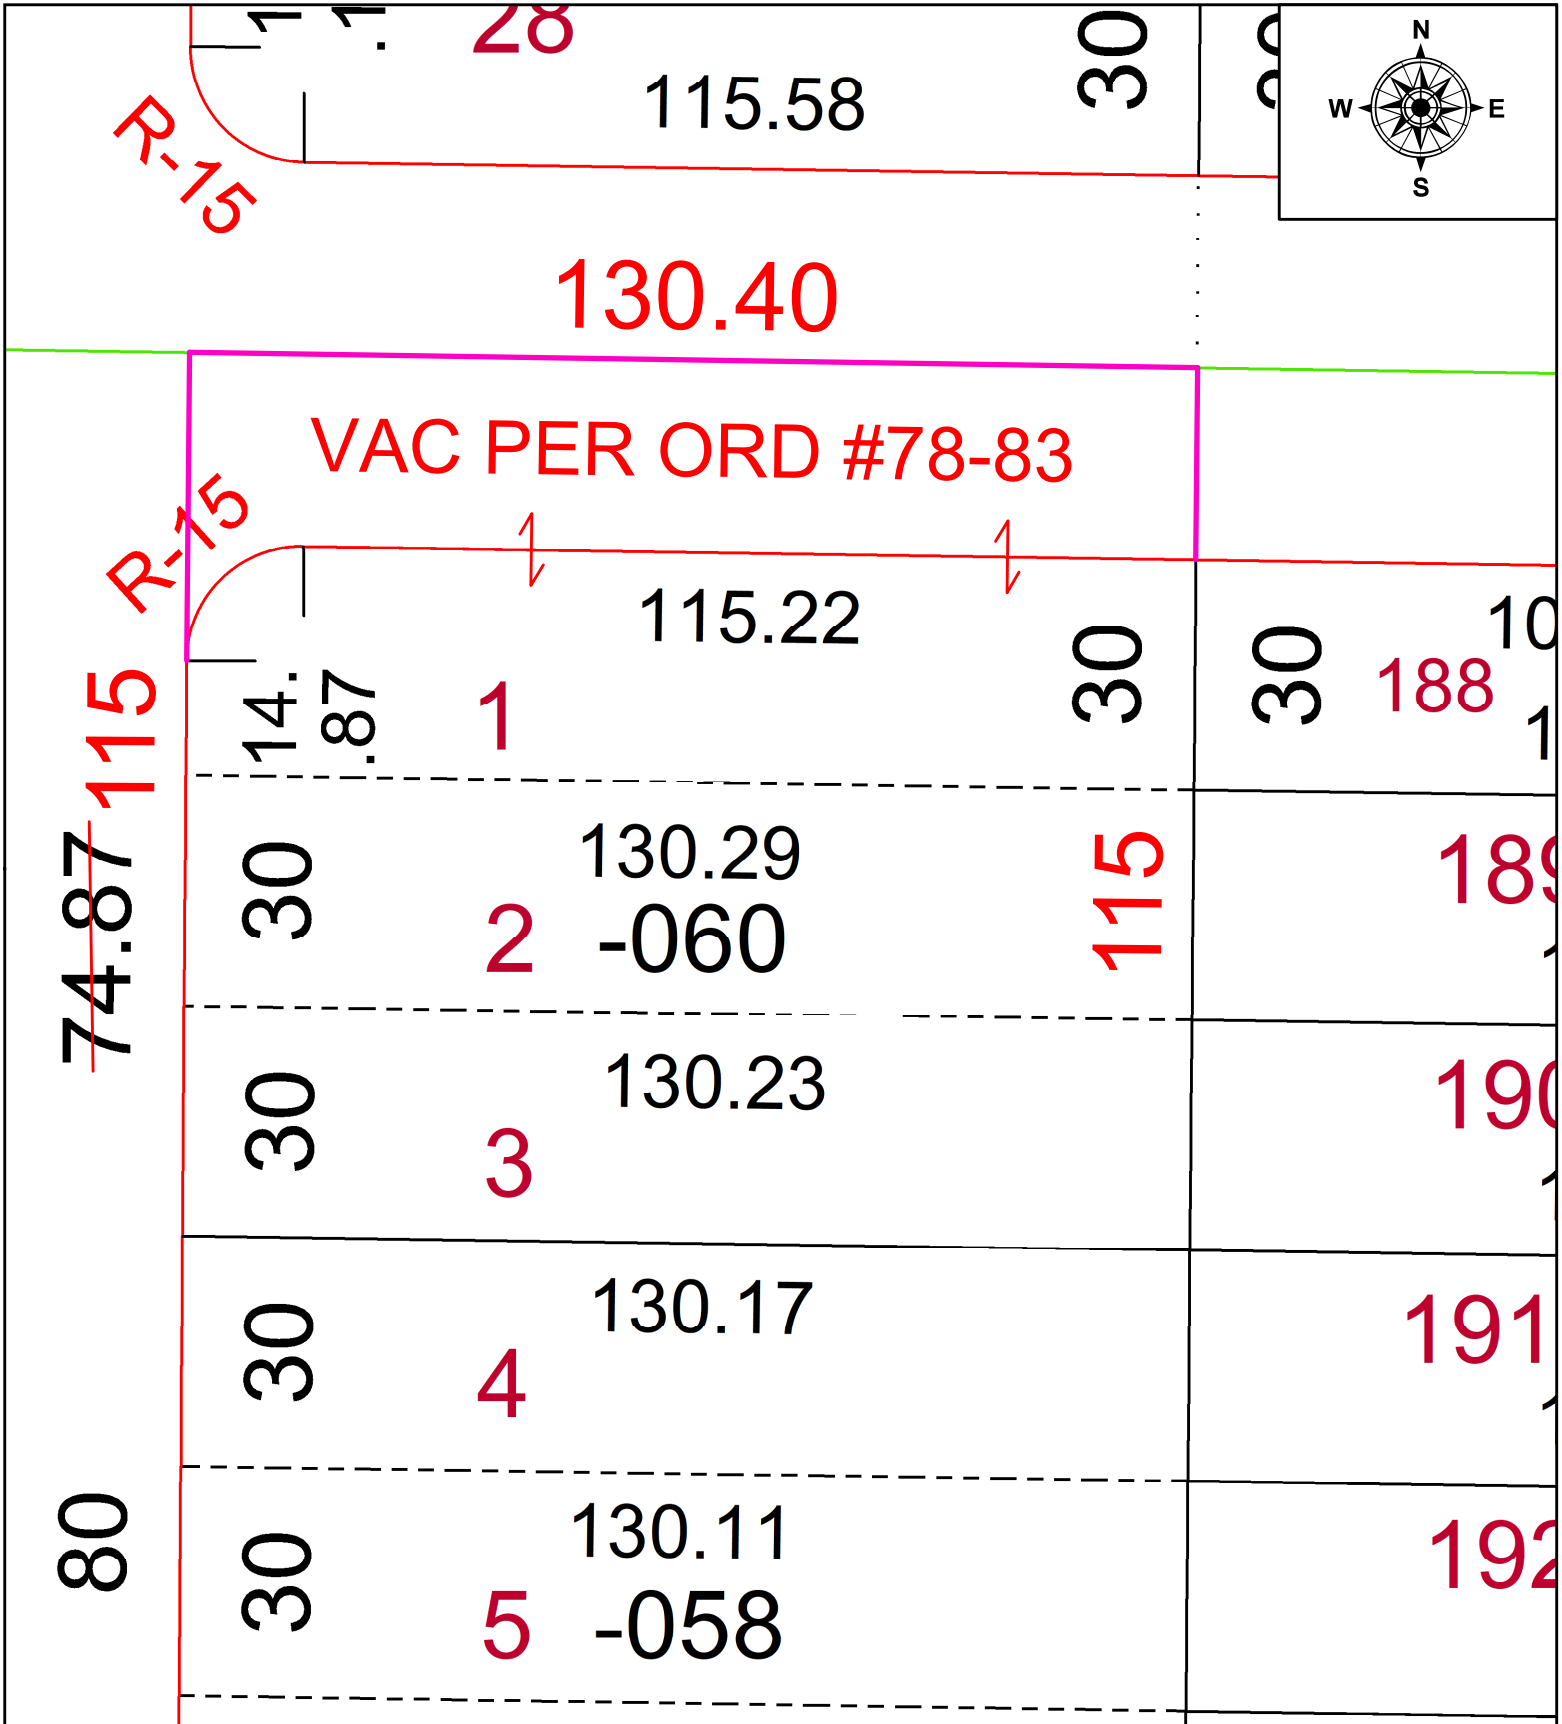

**SPLITS/DEEDS PROCESSED**  
LORAIN COUNTY TAX MAP DEPARTMENT  
226 MIDDLE AVE. ELYRIA, OH

SURVEYED BY: N/A	SURVEY #: N/A
CLOSURE: N/A	
MAP PAGE(S): 03-00-037	
APPROVED BY: SP	DATE: 8/3/2023
SCALE: 1" = 25'	PRIOR INSTRUMENT: 1999-0602396