


PARENT PARCEL: 08-00-082-000-034

CHILD PARCEL: AC. CORR.DUE TO TAX MAP ERROR--AC. WAS TYPED WRONG

STARTING POINT: N/A

23-05140-A

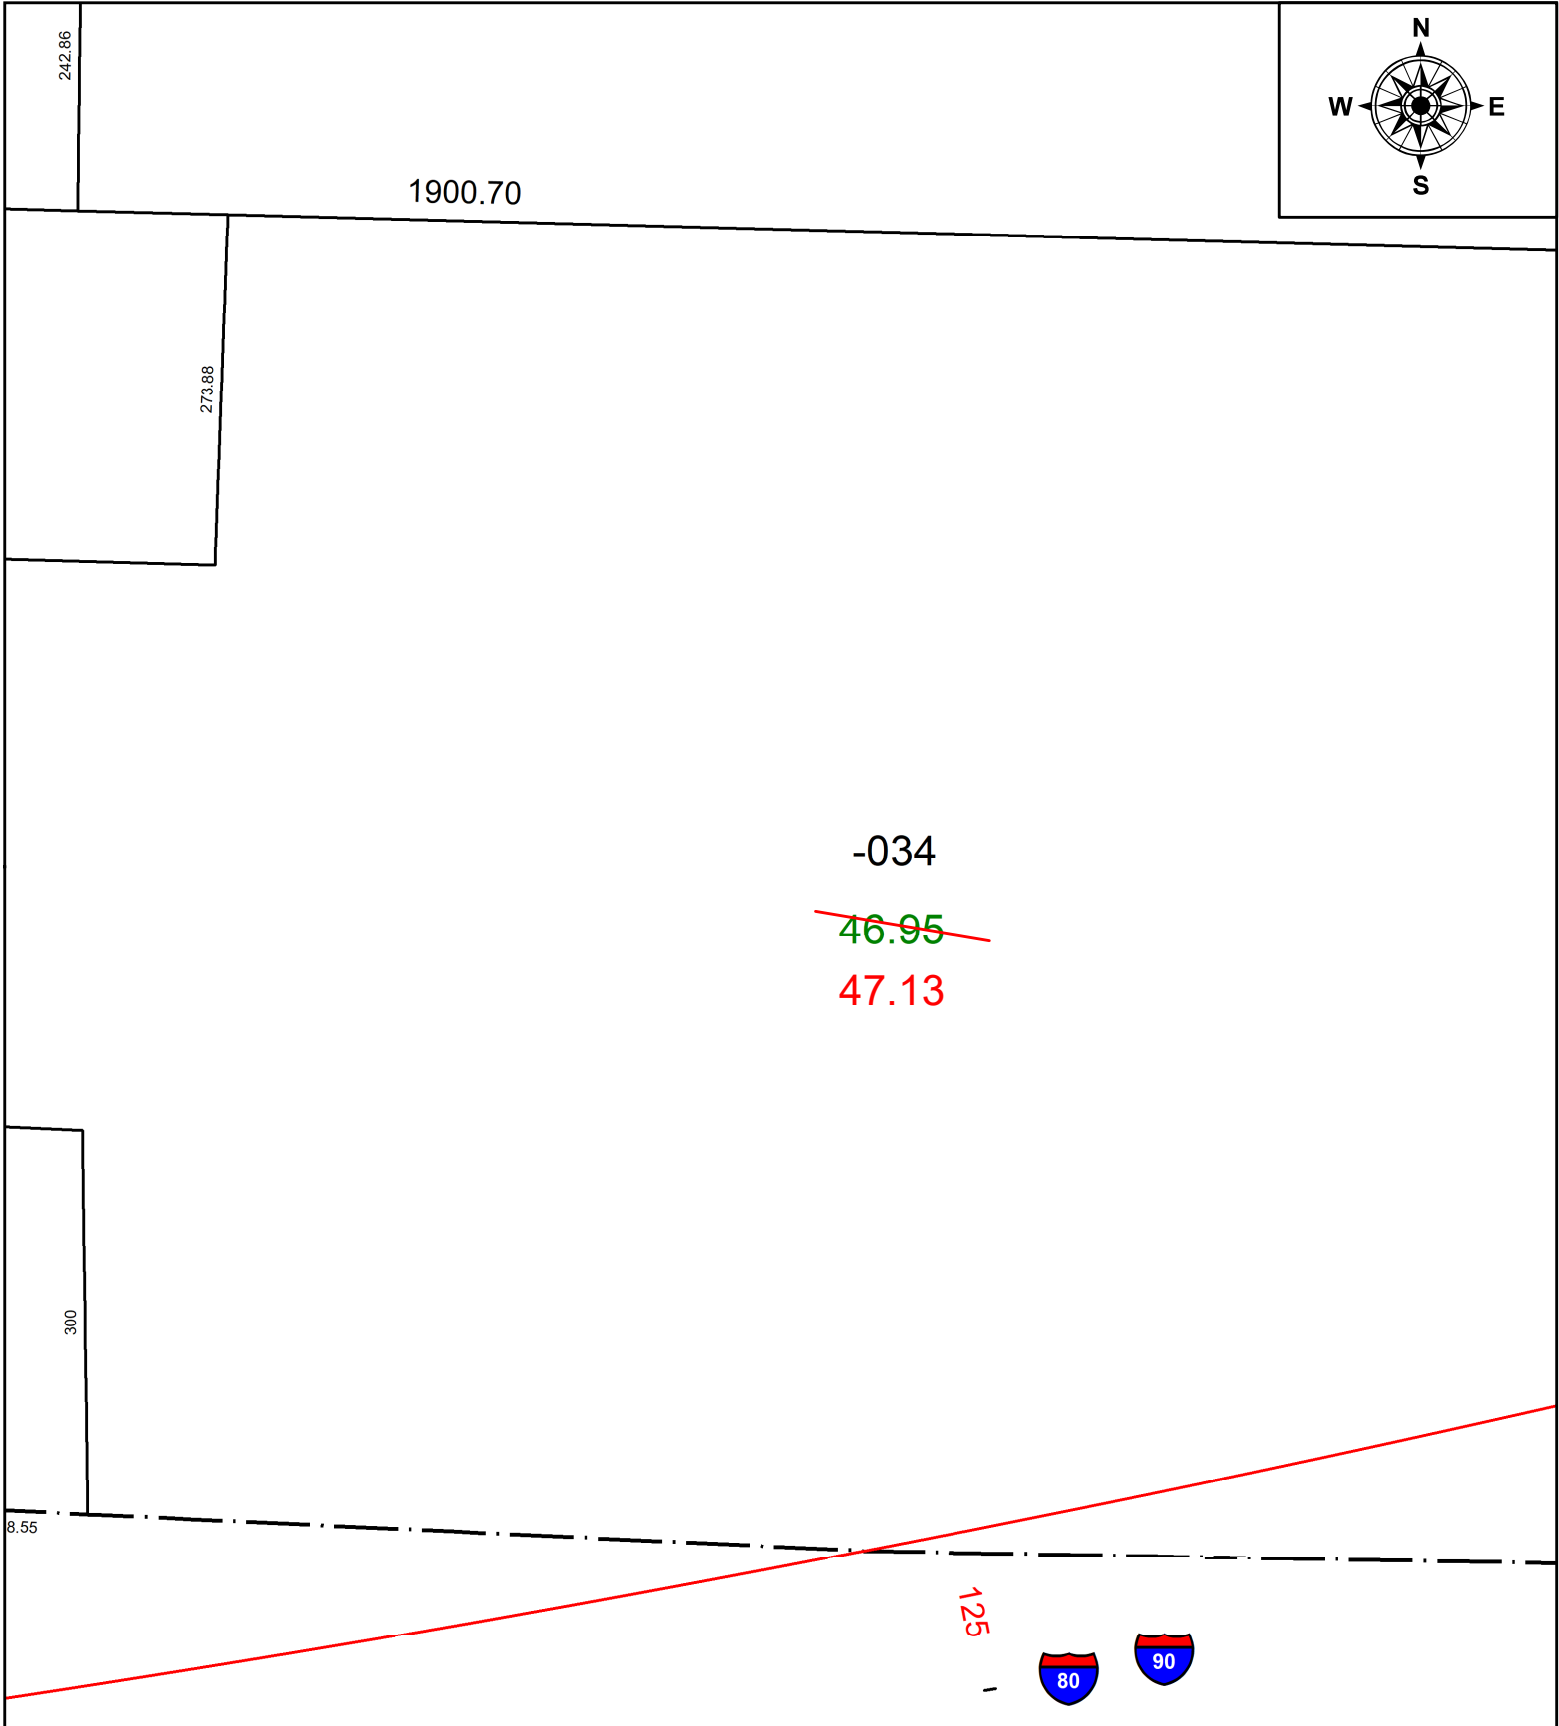

**SPLITS/DEEDS PROCESSED**  
 LORAIN COUNTY TAX MAP DEPARTMENT  
 226 MIDDLE AVE. ELYRIA, OH

SURVEYED BY: N/A SURVEY #: N/A  
 CLOSURE: N/A  
 MAP PAGE(S): 08-00-082  
 APPROVED BY: DMA DATE: 8/24/2023  
 SCALE: 1" = 150' PRIOR INSTRUMENT: N/A