


PARENT PARCEL: 03-00-058-102-028 & -030



CHILD PARCEL: MAP CORR. PER ORD. # 2125--PARCELS SHOULD BE IN TAX DISTRICT 42 PER ORD.

23-05150-C

STARTING POINT: N/A

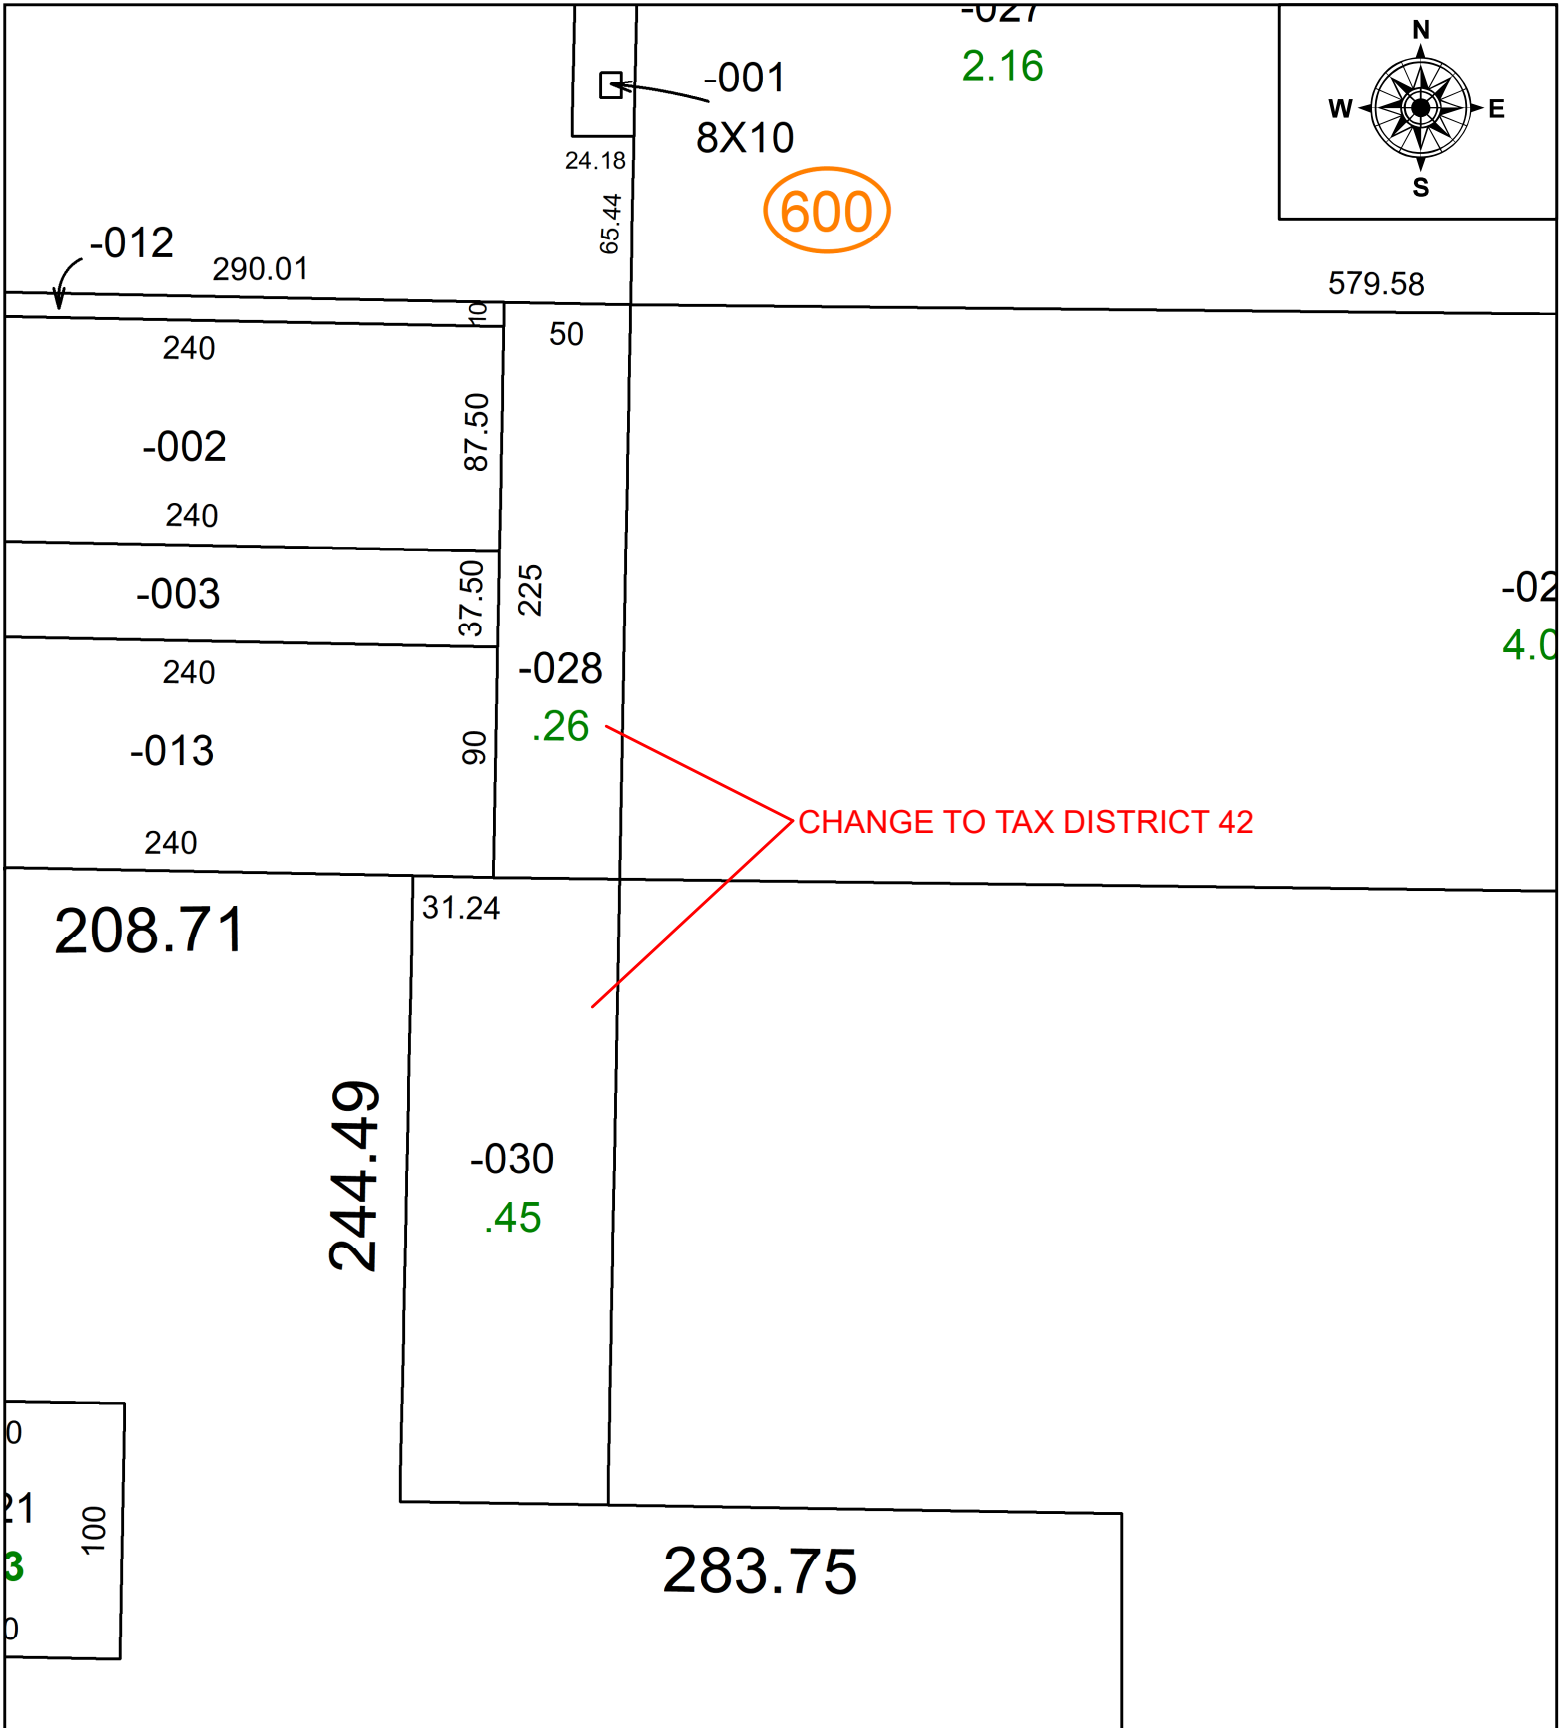

CHANGE TO TAX DISTRICT 42

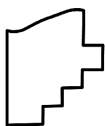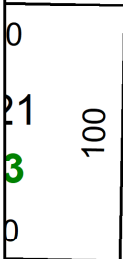

SPLITS/DEEDS PROCESSED
 LORAIN COUNTY TAX MAP DEPARTMENT
 226 MIDDLE AVE. ELYRIA, OH

SURVEYED BY: N/A SURVEY #: N/A
 CLOSURE: N/A
 MAP PAGE(S): 03-00-058
 APPROVED BY: DMA DATE: 9/8/2023
 SCALE: 1" = 25' PRIOR INSTRUMENT: N/A