


PARENT PARCEL: 03-00-017-102-019

CHILD PARCEL: **AC CORR PER SURV BY JOHN A. DECHANT JR**

STARTING POINT: C/L OF ABBE RD AND COLORADO AVE

23-05151-C

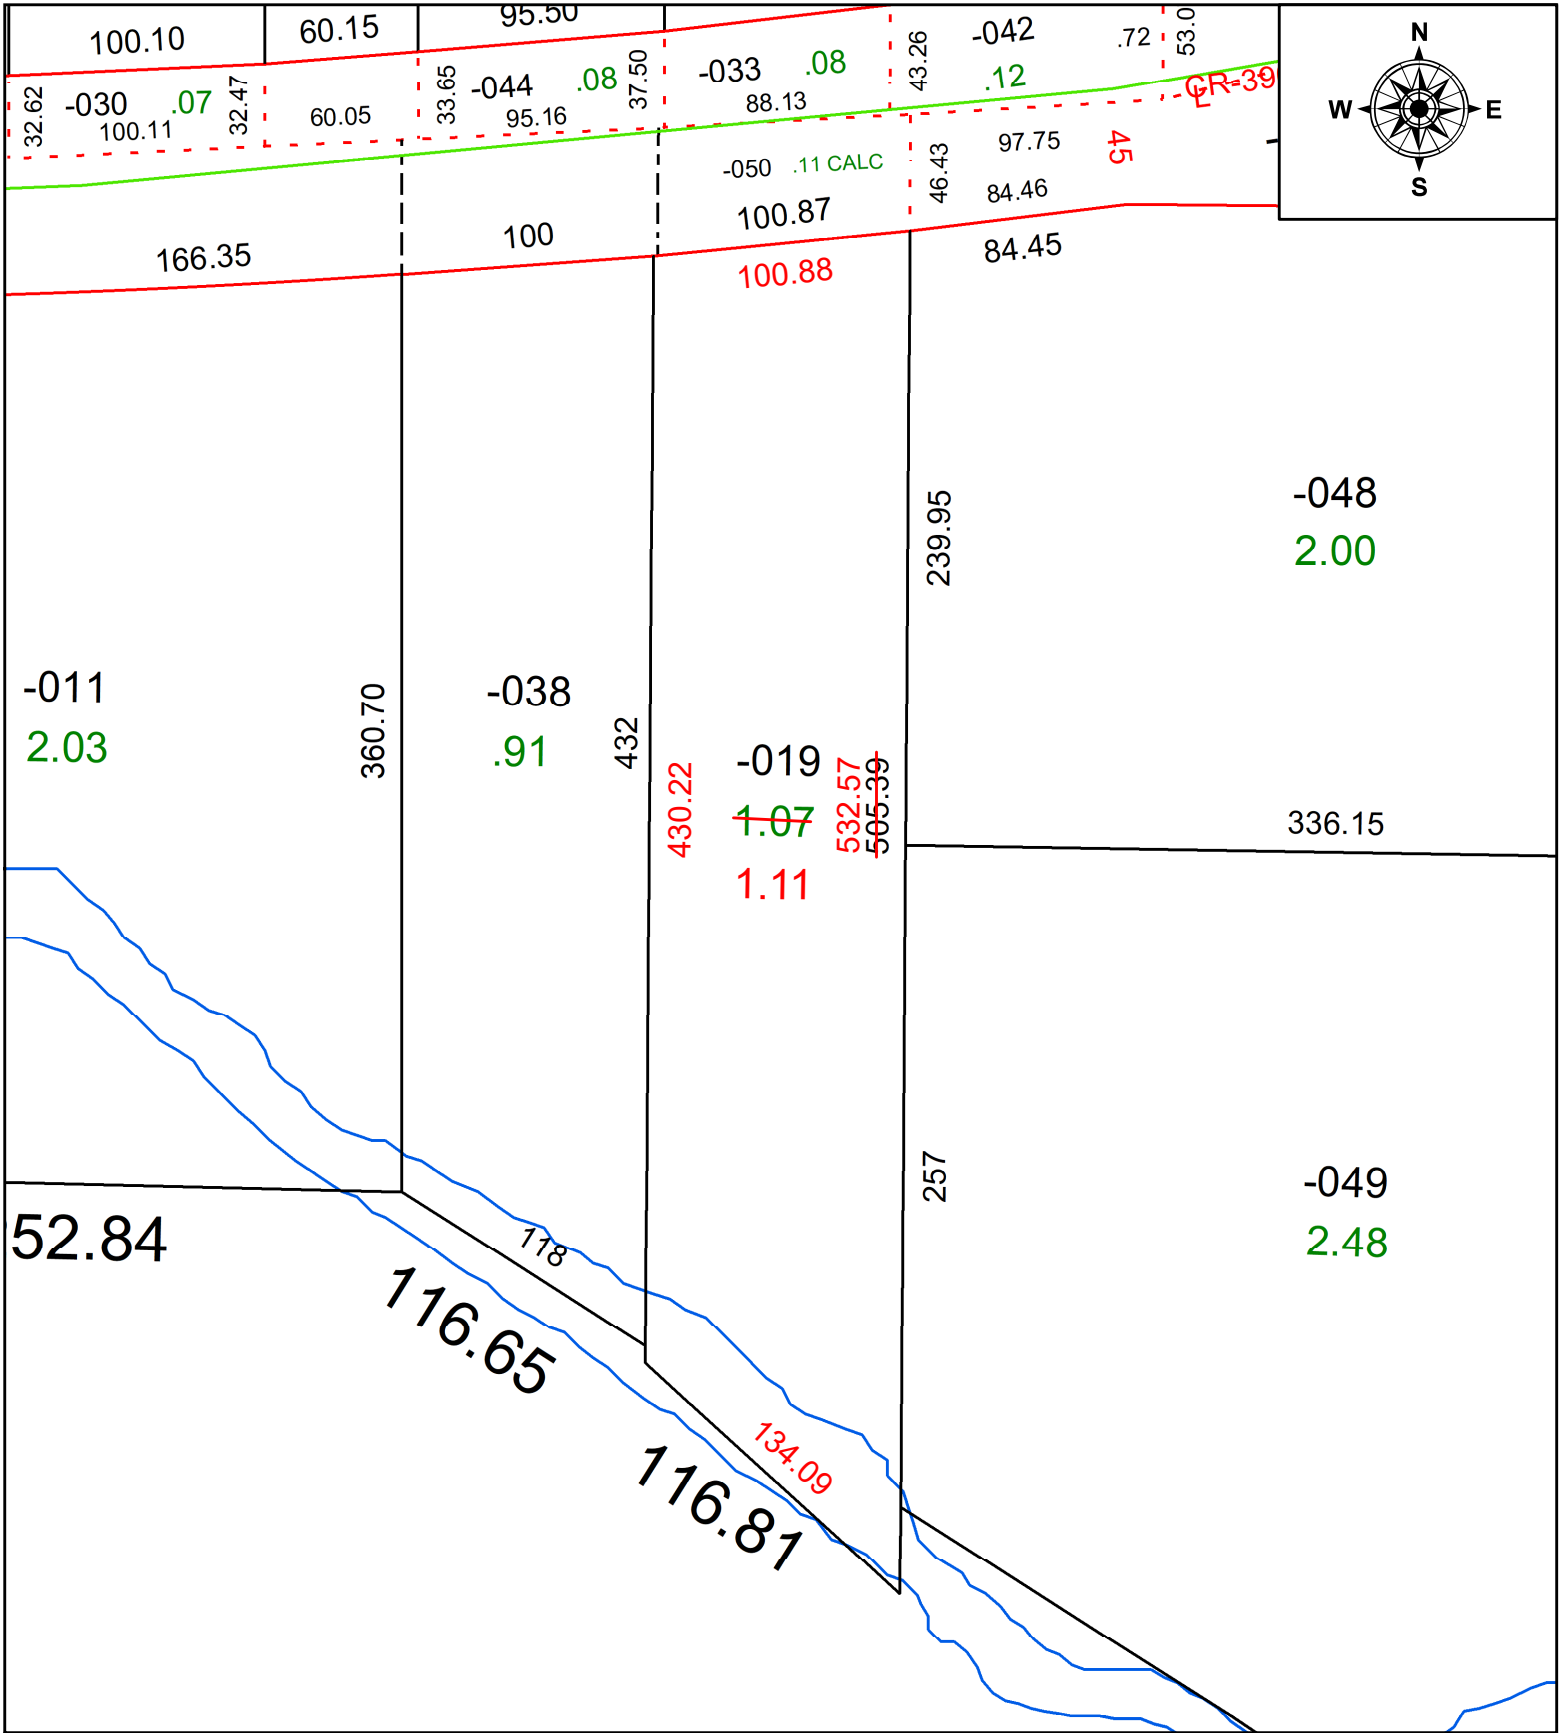

SPLITS/DEEDS PROCESSED
 LORAIN COUNTY TAX MAP DEPARTMENT
 226 MIDDLE AVE. ELYRIA, OH

SURVEYED BY: JOHN A. DECAHNT JR **SURV # 51008**
CLOSURE: 1: 100789
MAP PAGE(S): 03-00-017
APPROVED BY: AC **DATE:** September 08, 2023
SCALE: 1 in = 75 ft **PRIOR INSTRUMENT:** 2022- 0893212